PARENT PARCEL: 12-00-080-000-038, -082
CHILD PARCEL: 12-00-080-000-083, -084, -085
STARTING POINT: C/L OF SPRAGUE RD AND W LINE OF O/L 80

22-04484

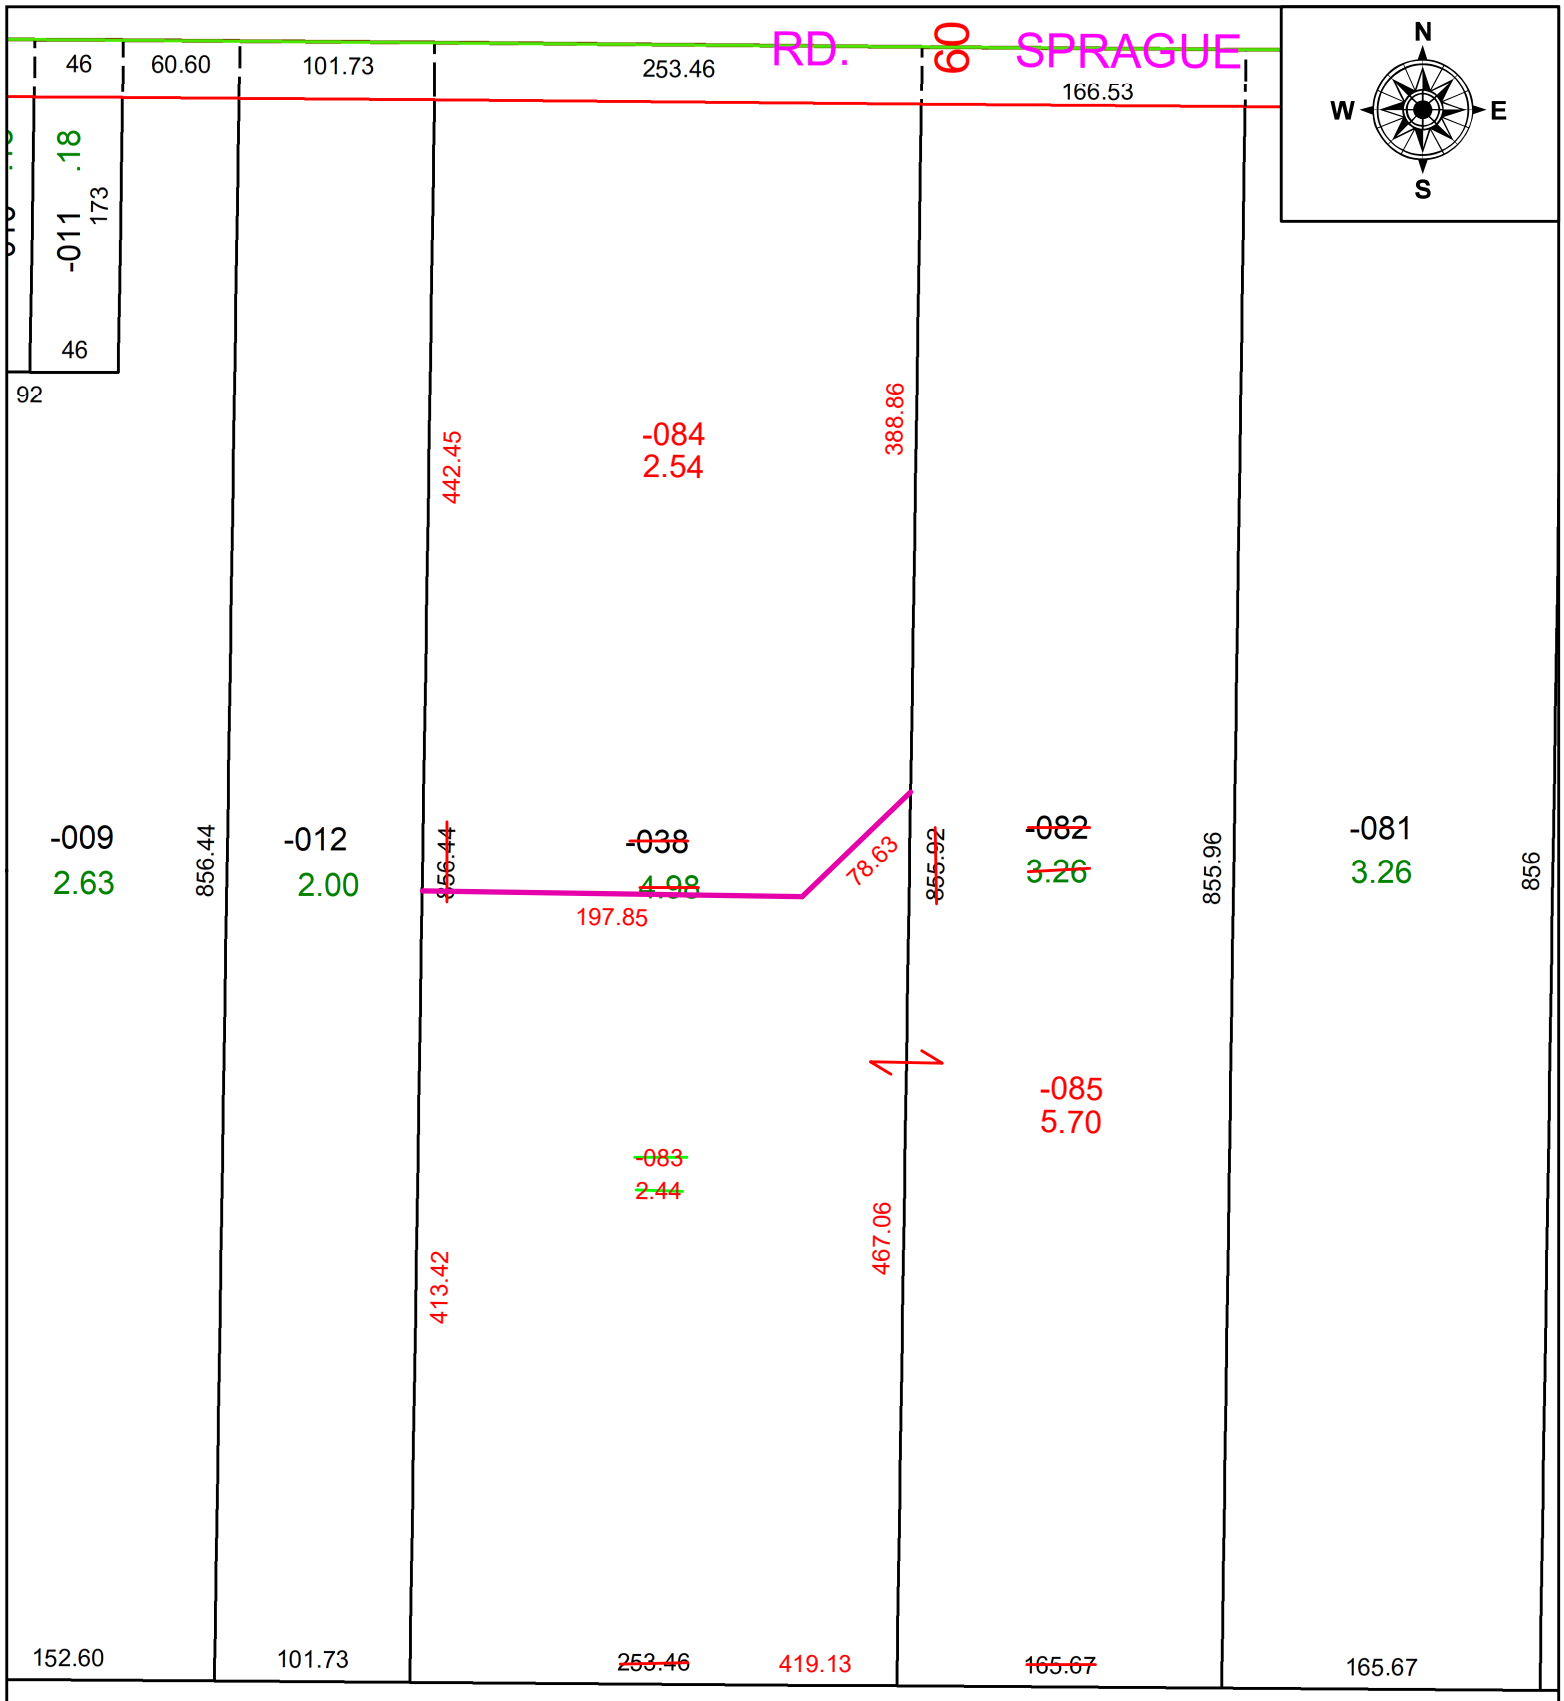

SPLITS/DEEDS PROCESSED
LORAIN COUNTY TAX MAP DEPARTMENT
226 MIDDLE AVE. ELYRIA, OH

SURVEYED BY: GEORGE HOFMANN
CLOSURE: 1: 214268
MAP PAGE(S): 12-00-080
APPOVED BY: AC **DATE:** 5/20/2022
SCALE: 1" = 100 **PRIOR INSTRUMENT:** 2022- 0863416