PARENT PARCEL: 02-01-006-138-010
CHILD PARCEL:
STARTING POINT: S/L 137 IN J.B. HOGE'S ADDITION

21-04485-C

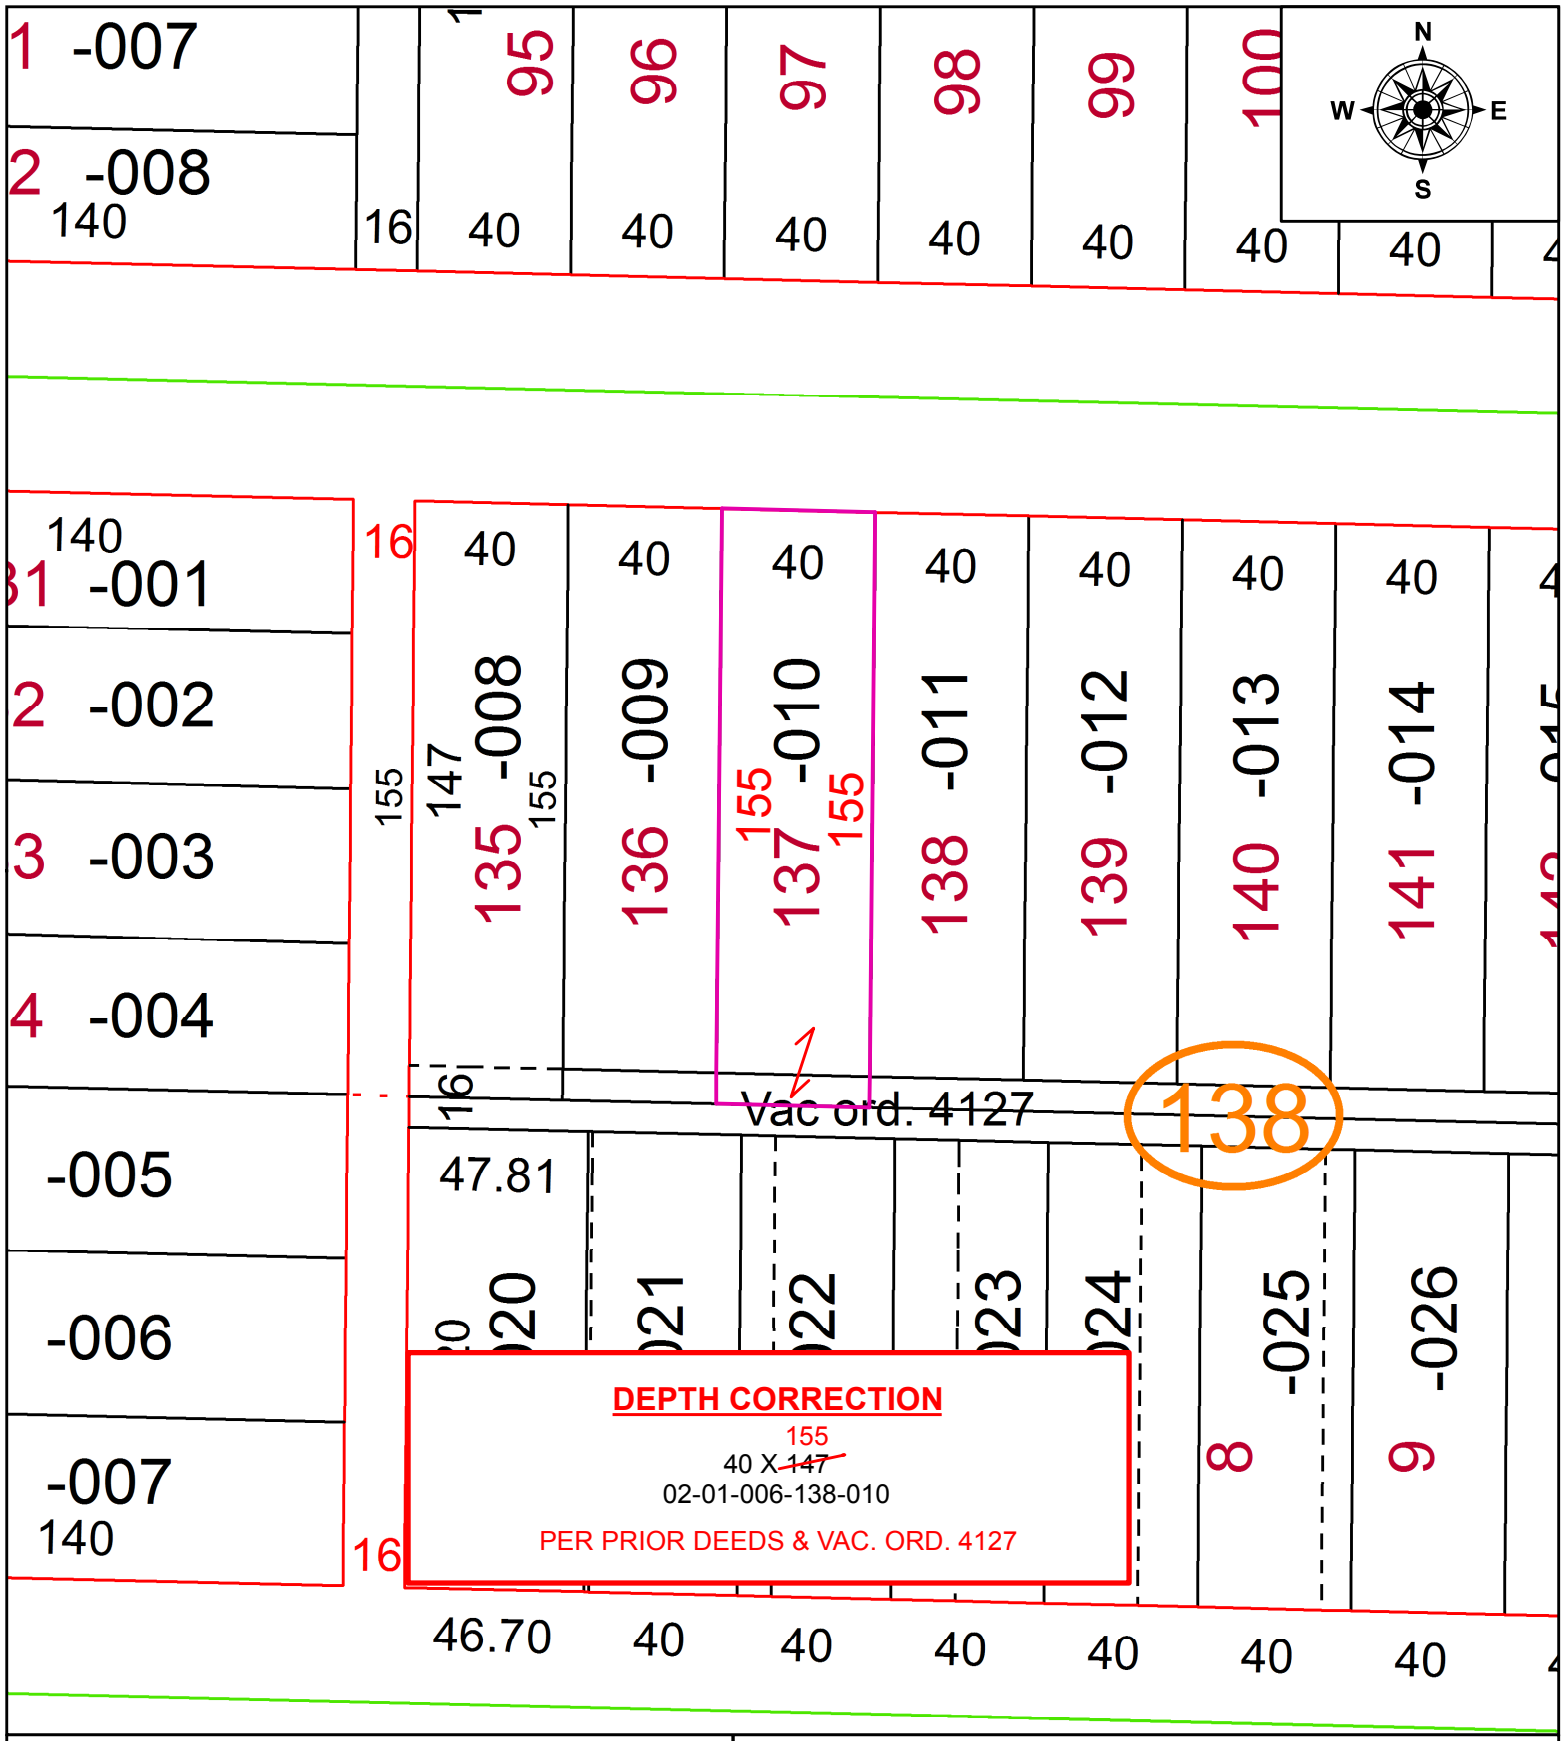

SPLITS/DEEDS PROCESSED
LORAIN COUNTY TAX MAP DEPARTMENT
226 MIDDLE AVE. ELYRIA, OH

SURVEYED BY: N/A
CLOSURE: N/A
MAP PAGE(S): 2-01-006
APPOVED BY: RRM **DATE:** 2-3-21
SCALE: 1" = 50 **PRIOR INSTRUMENT:** 20140507049