PARENT PARCEL: 05-00-047-000-019
CHILD PARCEL: 05-00-047-000-030 & -031
STARTING POINT: AC CORR PER SURV BY AMY M. KELLY

22-04485

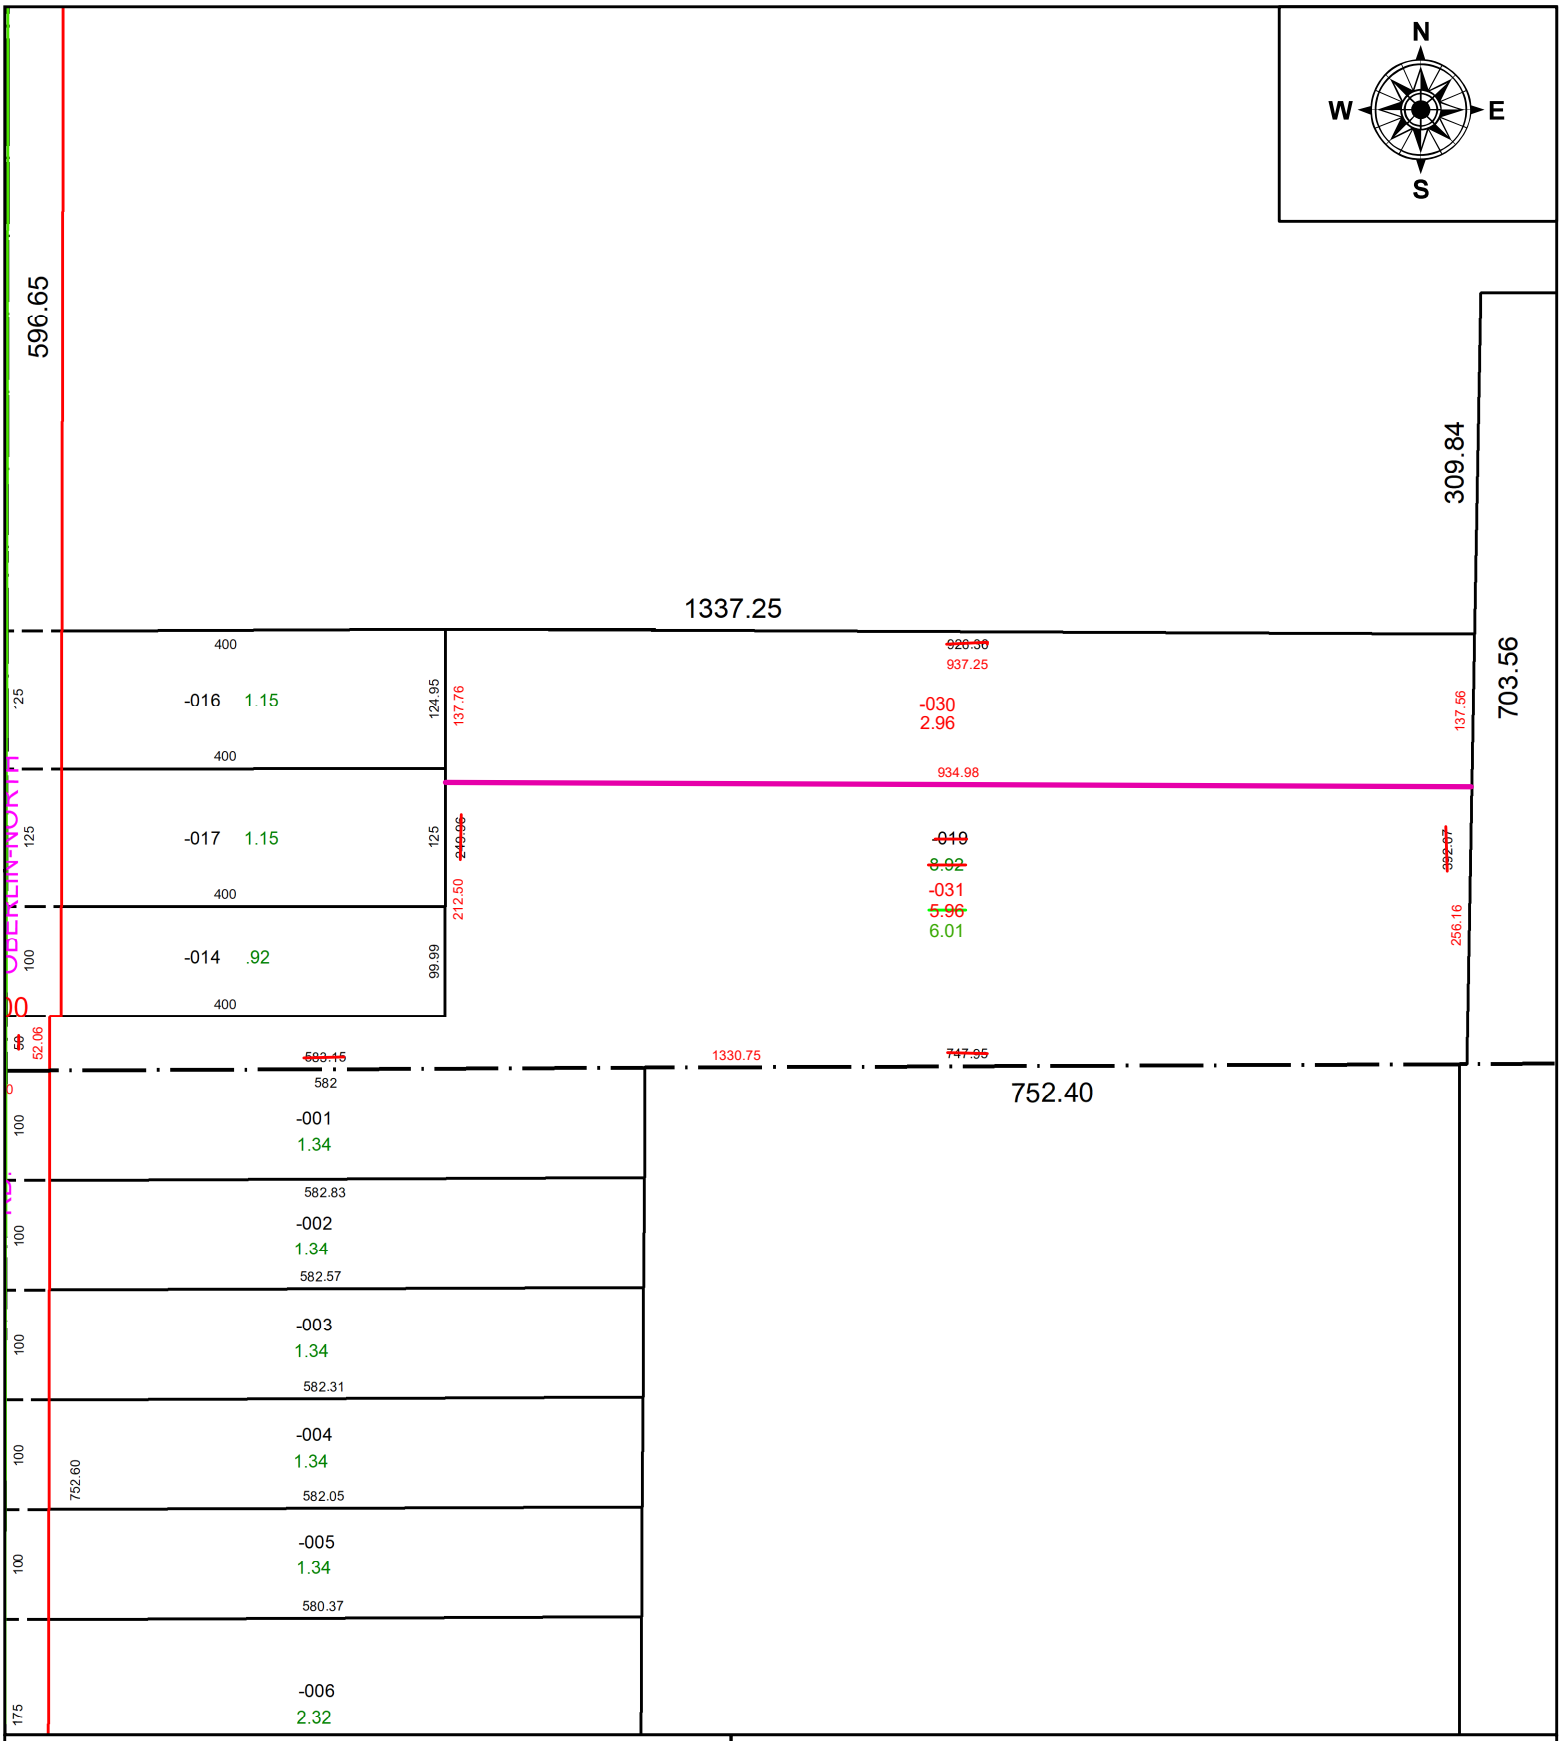

SPLITS/DEEDS PROCESSED

LORAIN COUNTY TAX MAP DEPARTMENT
226 MIDDLE AVE. ELYRIA, OH

SURVEYED BY: AMY M. KELLY
CLOSURE: 1: 530218
MAP PAGE(S): 05-00-047-A
APPOVED BY: AC **DATE:** 5/20/2022
SCALE: 1" = 175 **PRIOR INSTRUMENT:** 2003- 0931740