PARENT PARCEL: 03-00-043-101-015 & -016
CHILD PARCEL: 03-00-043-101-020
STARTING POINT: CL OF BEACH ST. & LAKE RD.

22-04486

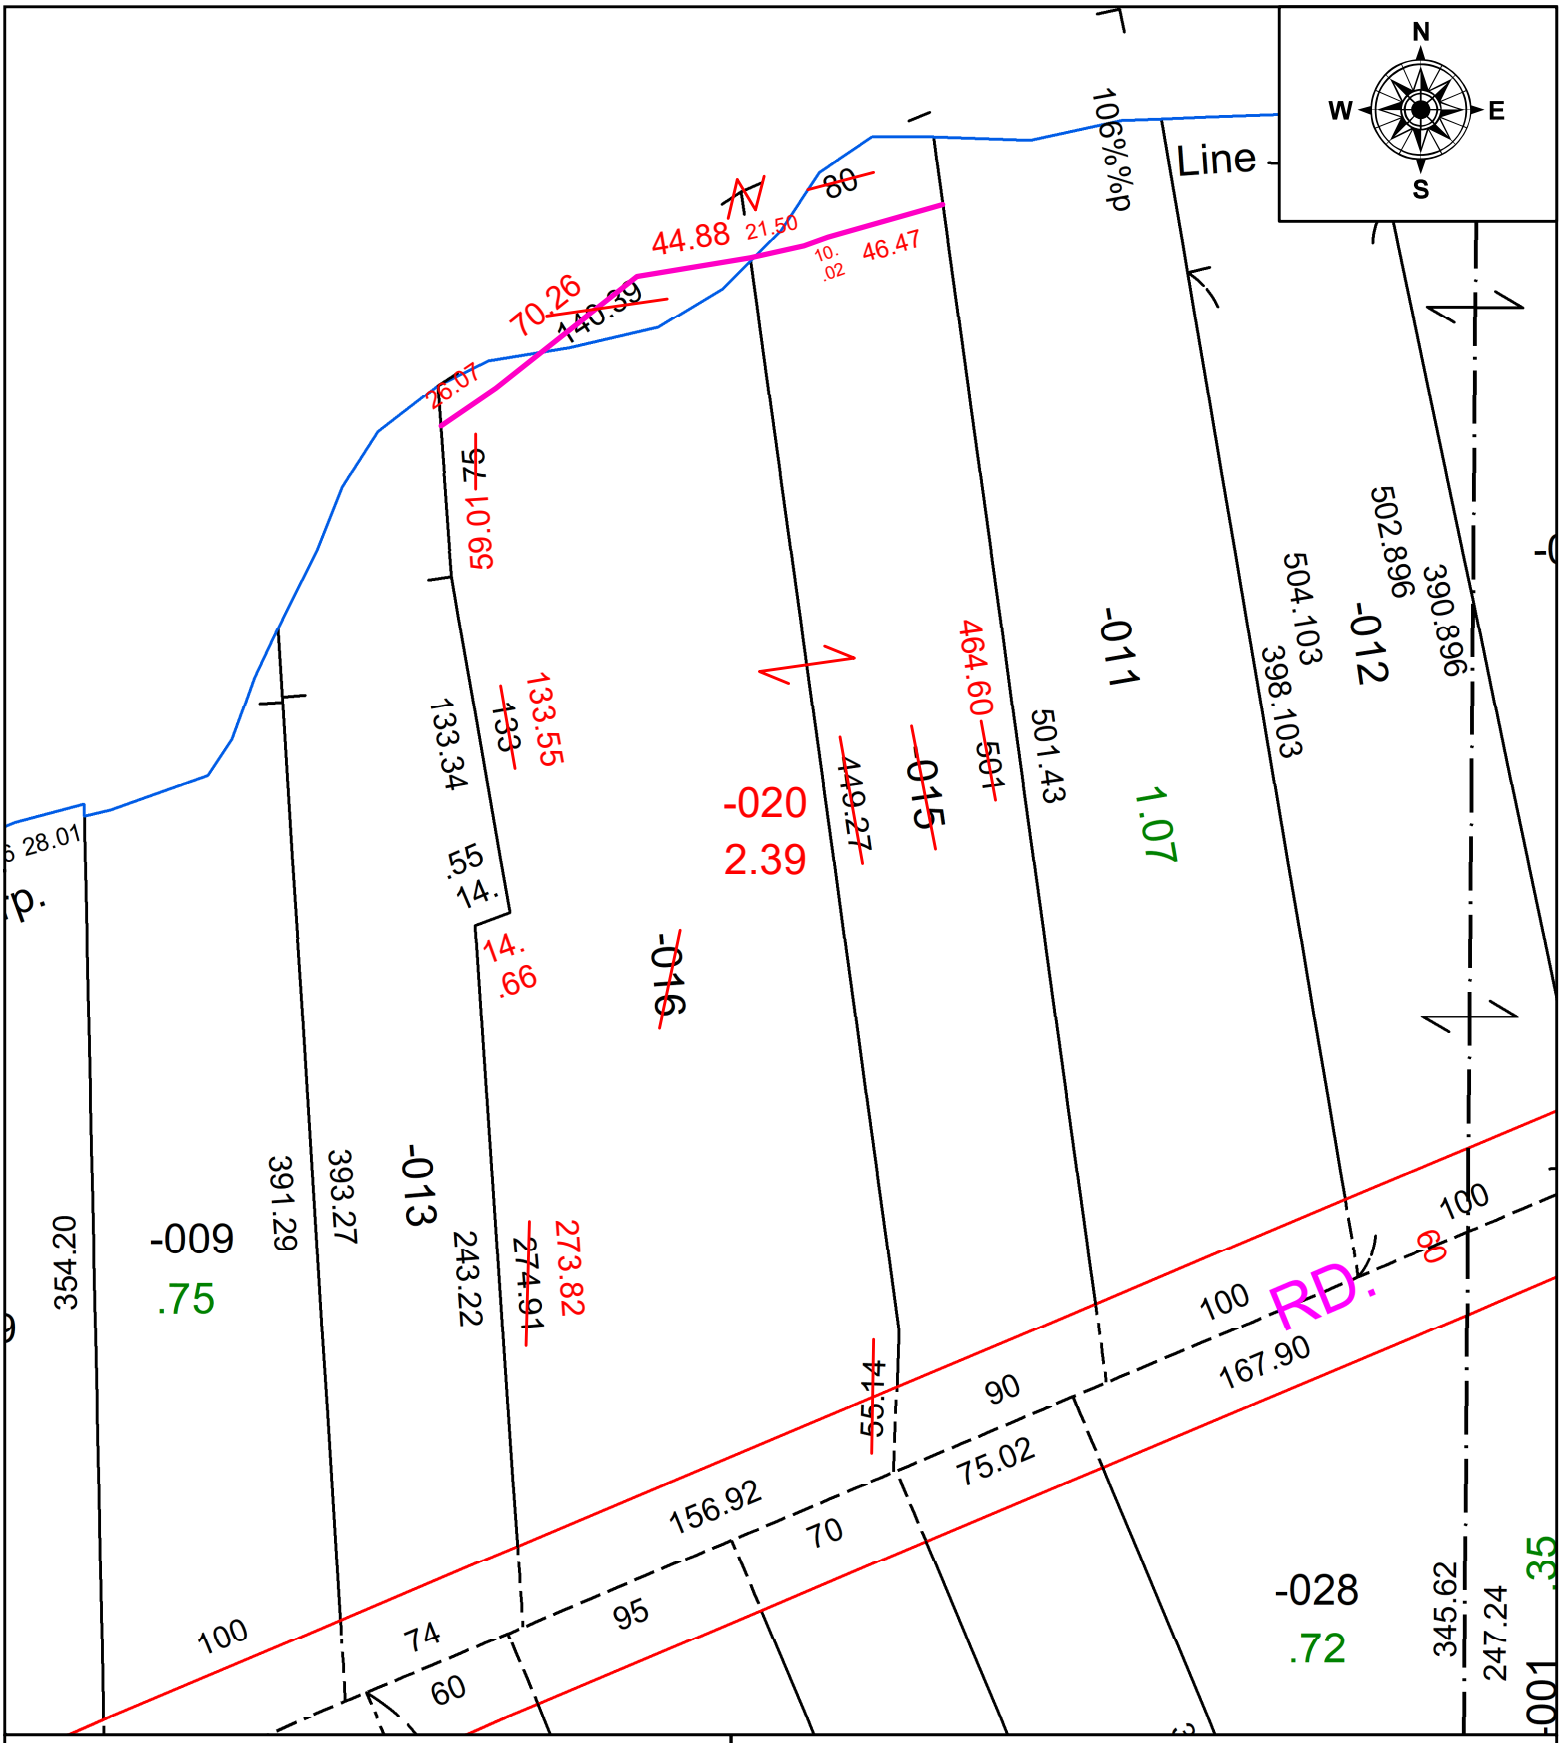

SPLITS/DEEDS PROCESSED
LORAIN COUNTY TAX MAP DEPARTMENT
226 MIDDLE AVE. ELYRIA, OH

SURVEYED BY: PATRICK McGANNON
CLOSURE: 1: 90144
MAP PAGE(S): 03-00-043
APPOVED BY: DMA **DATE:** 5/23/2022
SCALE: 1" = 75' **PRIOR INSTRUMENT:** 2020-0768719