**PARENT PARCEL:** 04-00-027-104-013 , -014, & -017

**CHILD PARCEL:** 04-00-027-104-018 THRU -023 ACREAGE CORRECTION PER WIILIAM VONDRA JR.

**STARTING POINT:** INTERSECTION OF C/LS OF LEAR NAGLE RD & CHERRY ST

22-04487

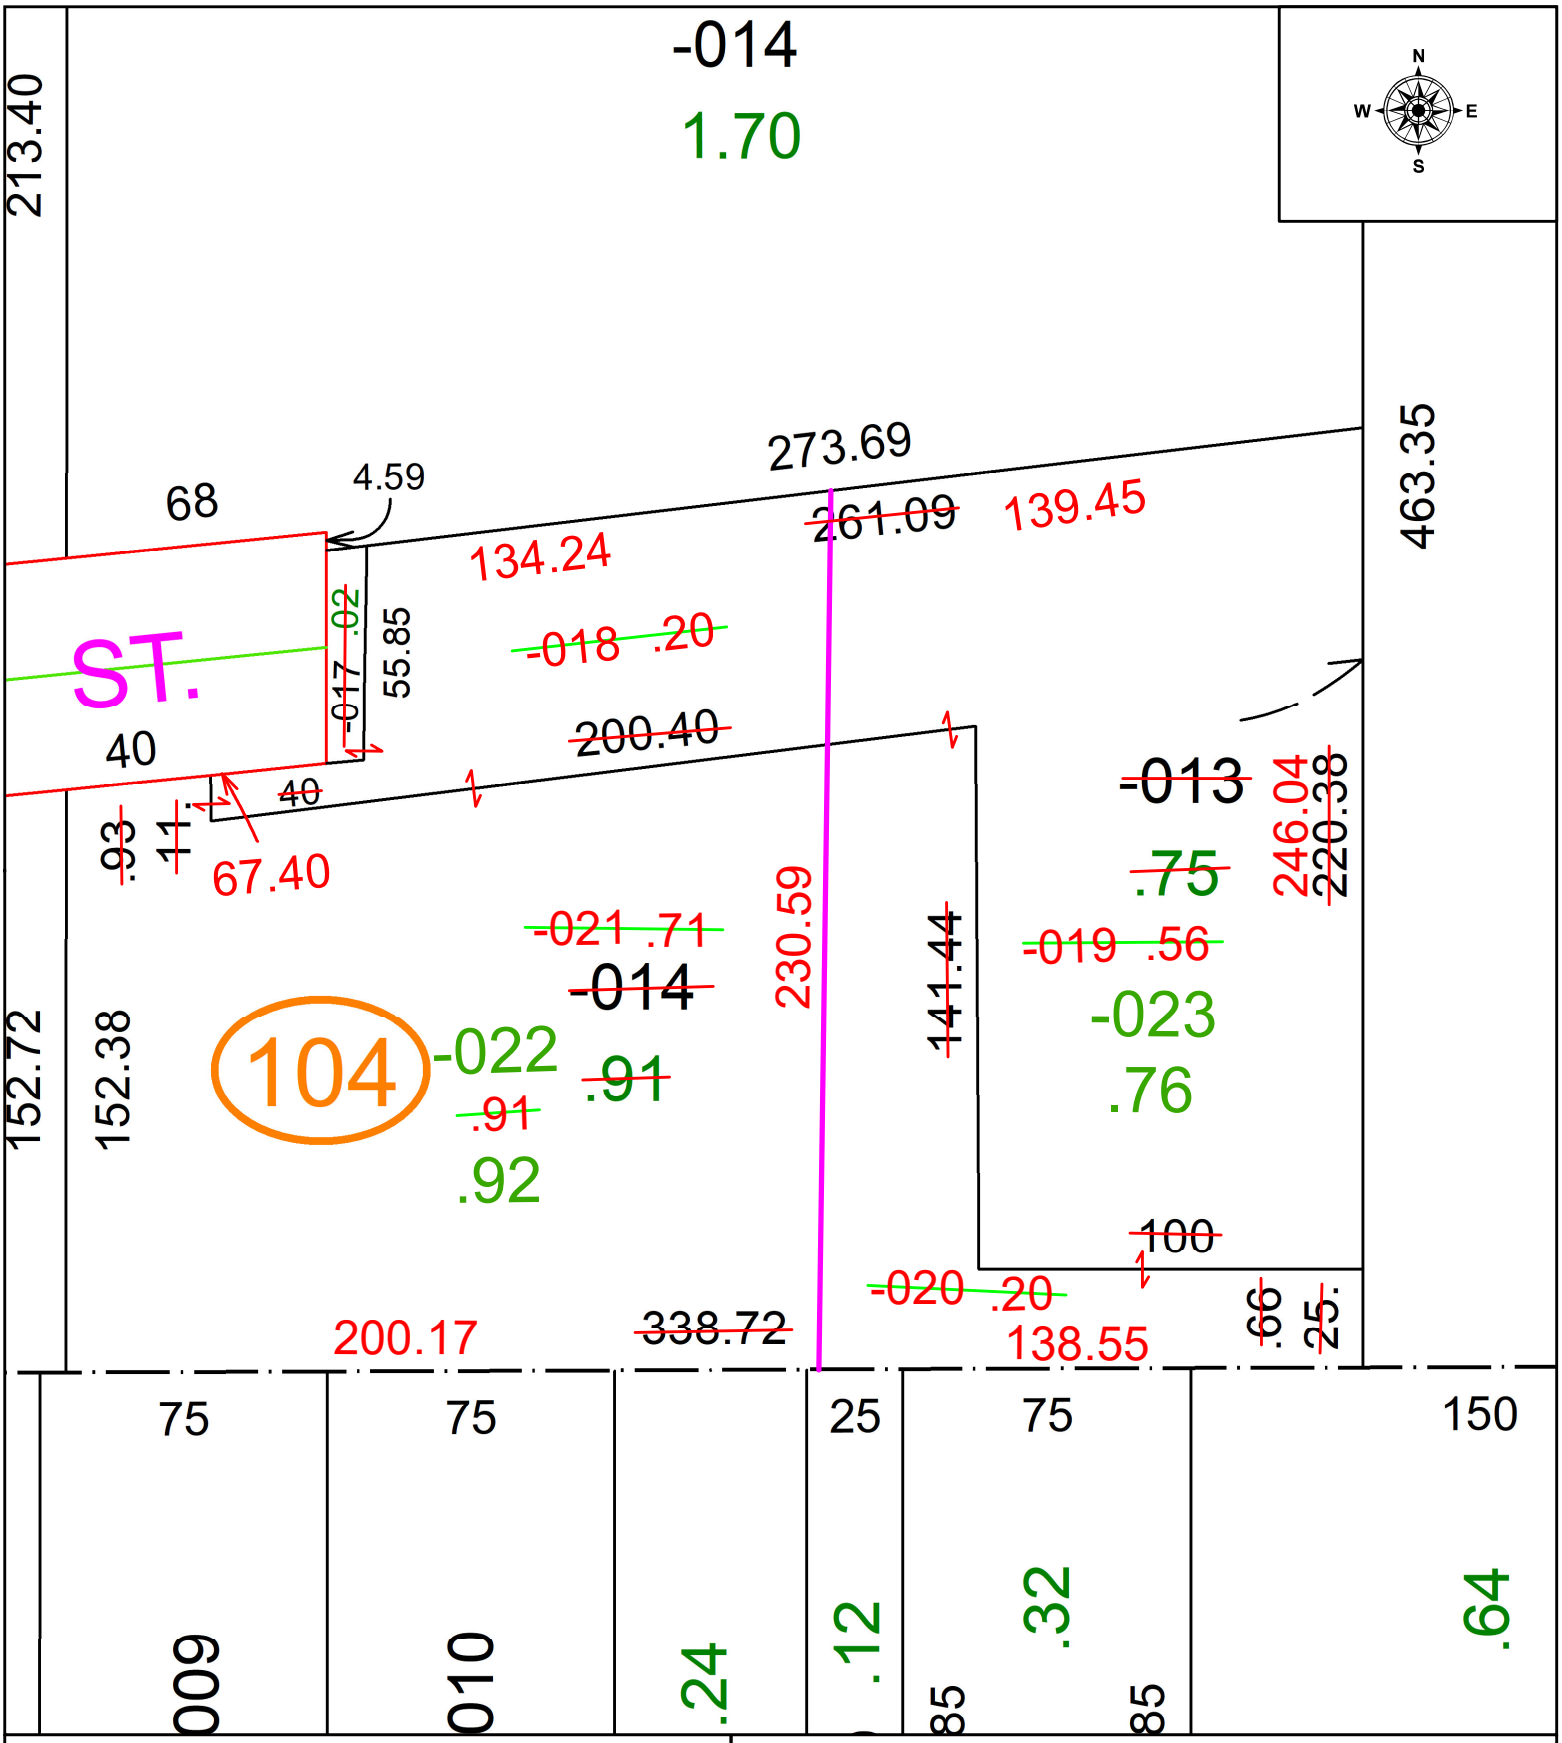


**SPLITS/DEEDS PROCESSED**

LORAIN COUNTY TAX MAP DEPARTMENT
226 MIDDLE AVE. ELYRIA, OH

**SURVEYED BY:** WILLIAM VONDRA JR. SURVEY #50593
**CLOSURE:** 1: 43058
**MAP PAGE(S):** 04-00-027
**APPOVED BY:** WRZ **DATE:** 6/3/2022
**SCALE:** 1" = 50 **PRIOR INSTRUMENT:** 2021-0841864