PARENT PARCEL: 03-00-103-116-057 , -058, & -059

CHILD PARCEL: 03-00-103-116-060 N/A

STARTING POINT: INTERSECTION OF C/LS OF OMAHA AVE & EAST 39TH ST AT A MONUMENT BOX

22-04489

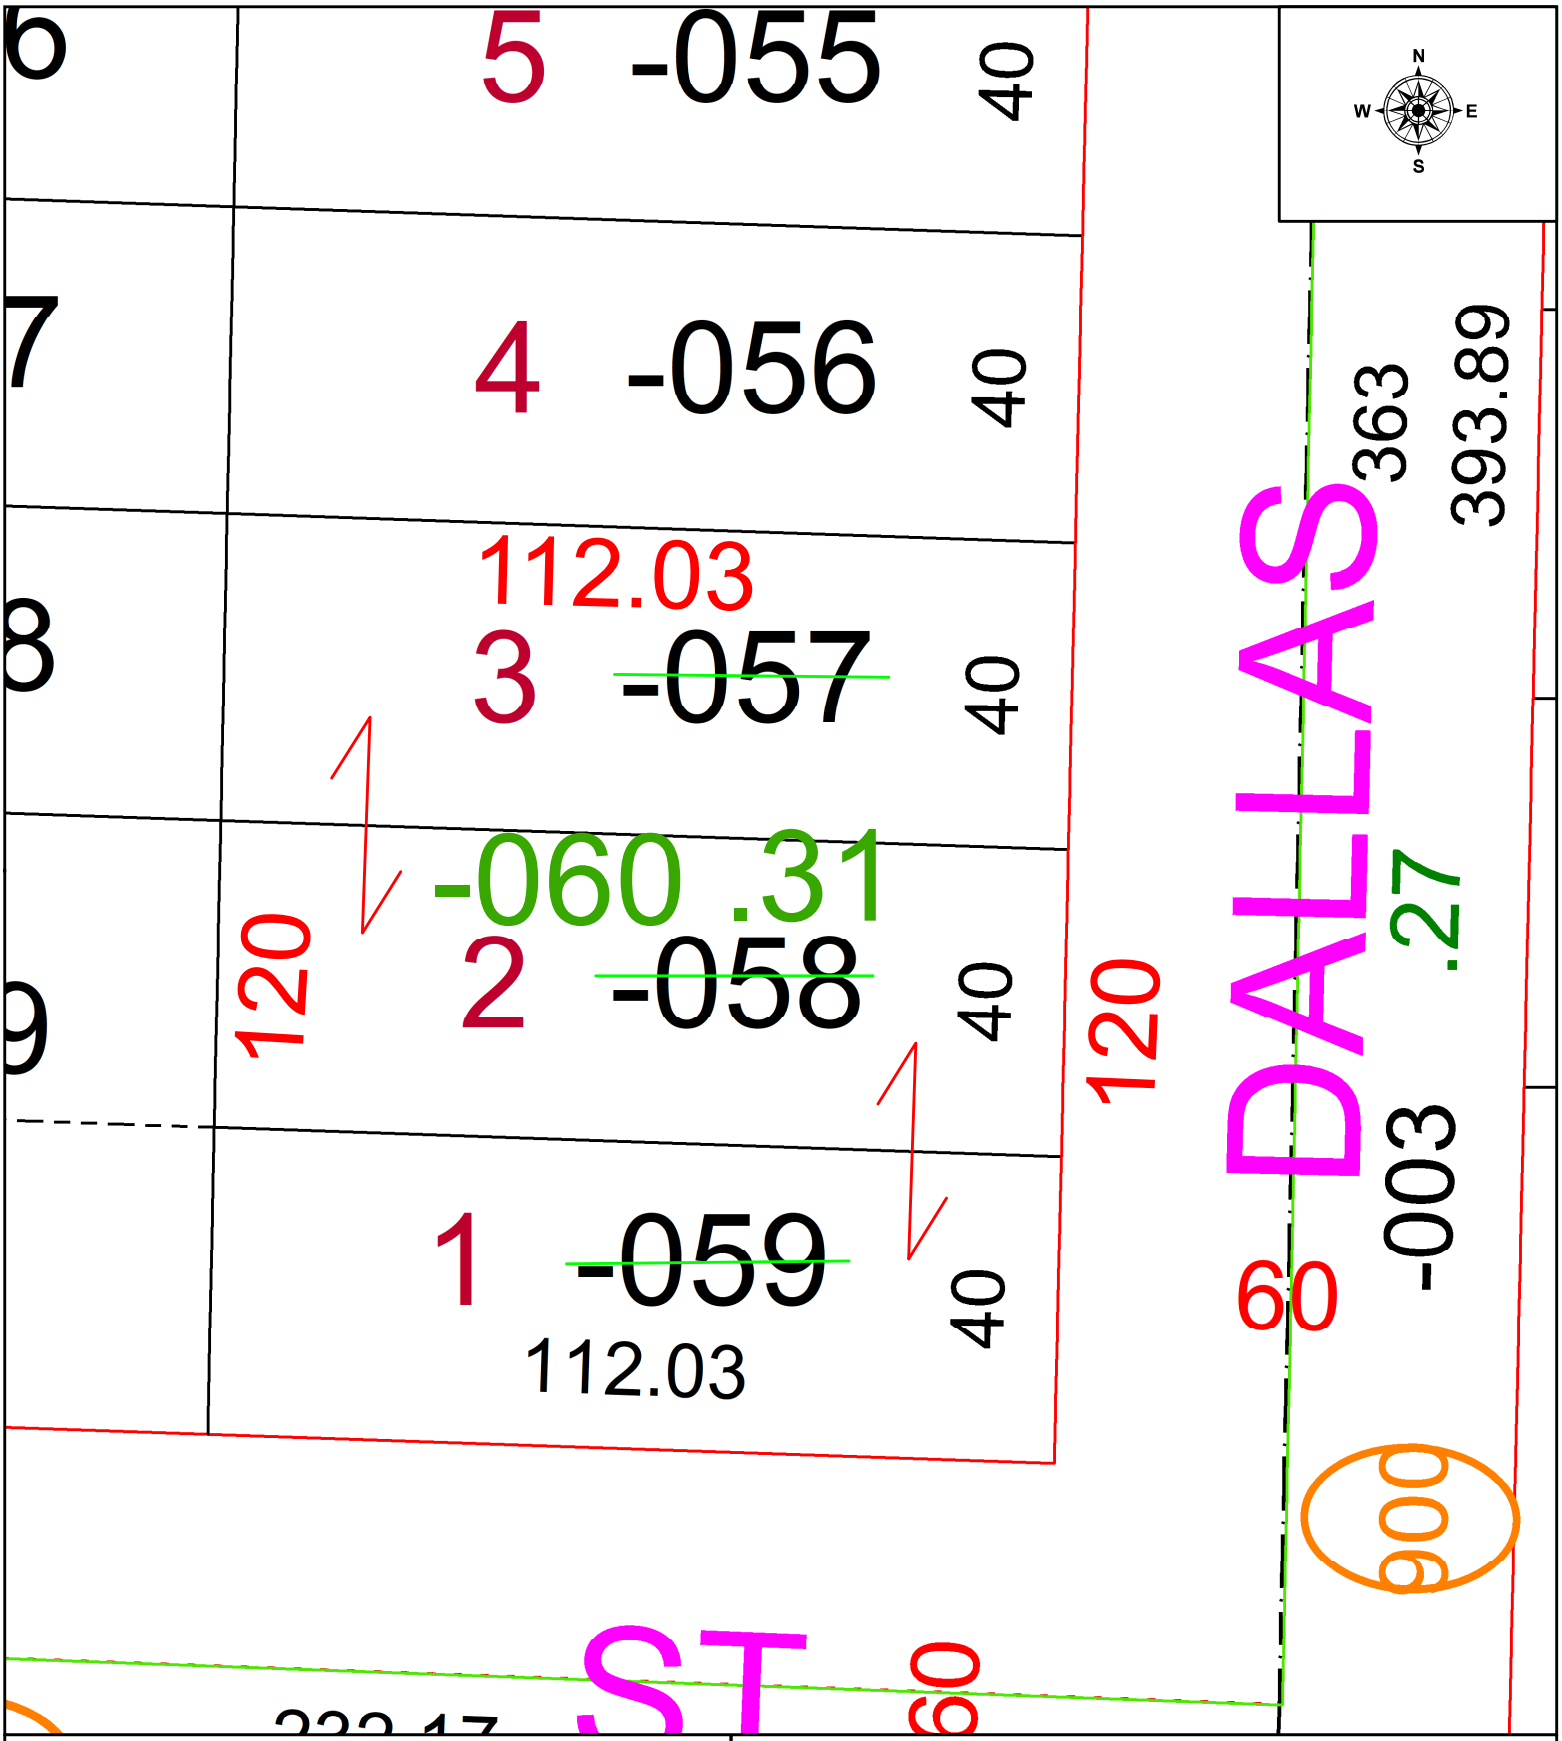

SPLITS/DEEDS PROCESSED

LORAIN COUNTY TAX MAP DEPARTMENT
226 MIDDLE AVE. ELYRIA, OH

SURVEYED BY: ALEX MARKS N/A
CLOSURE: 1: -2147483648
MAP PAGE(S): 03-00-103
APPOVED BY: WRZ **DATE:** 6/1/2022
SCALE: 1" = 25 **PRIOR INSTRUMENT:** 2022-0868672