PARENT PARCEL: 06-24-070-104-011

CHILD PARCEL:

STARTING POINT: INTERSECTION OF NORTH LINE OF BOND ST. AND WEST LINE OF JEFFERSON ST.

21-04494-D

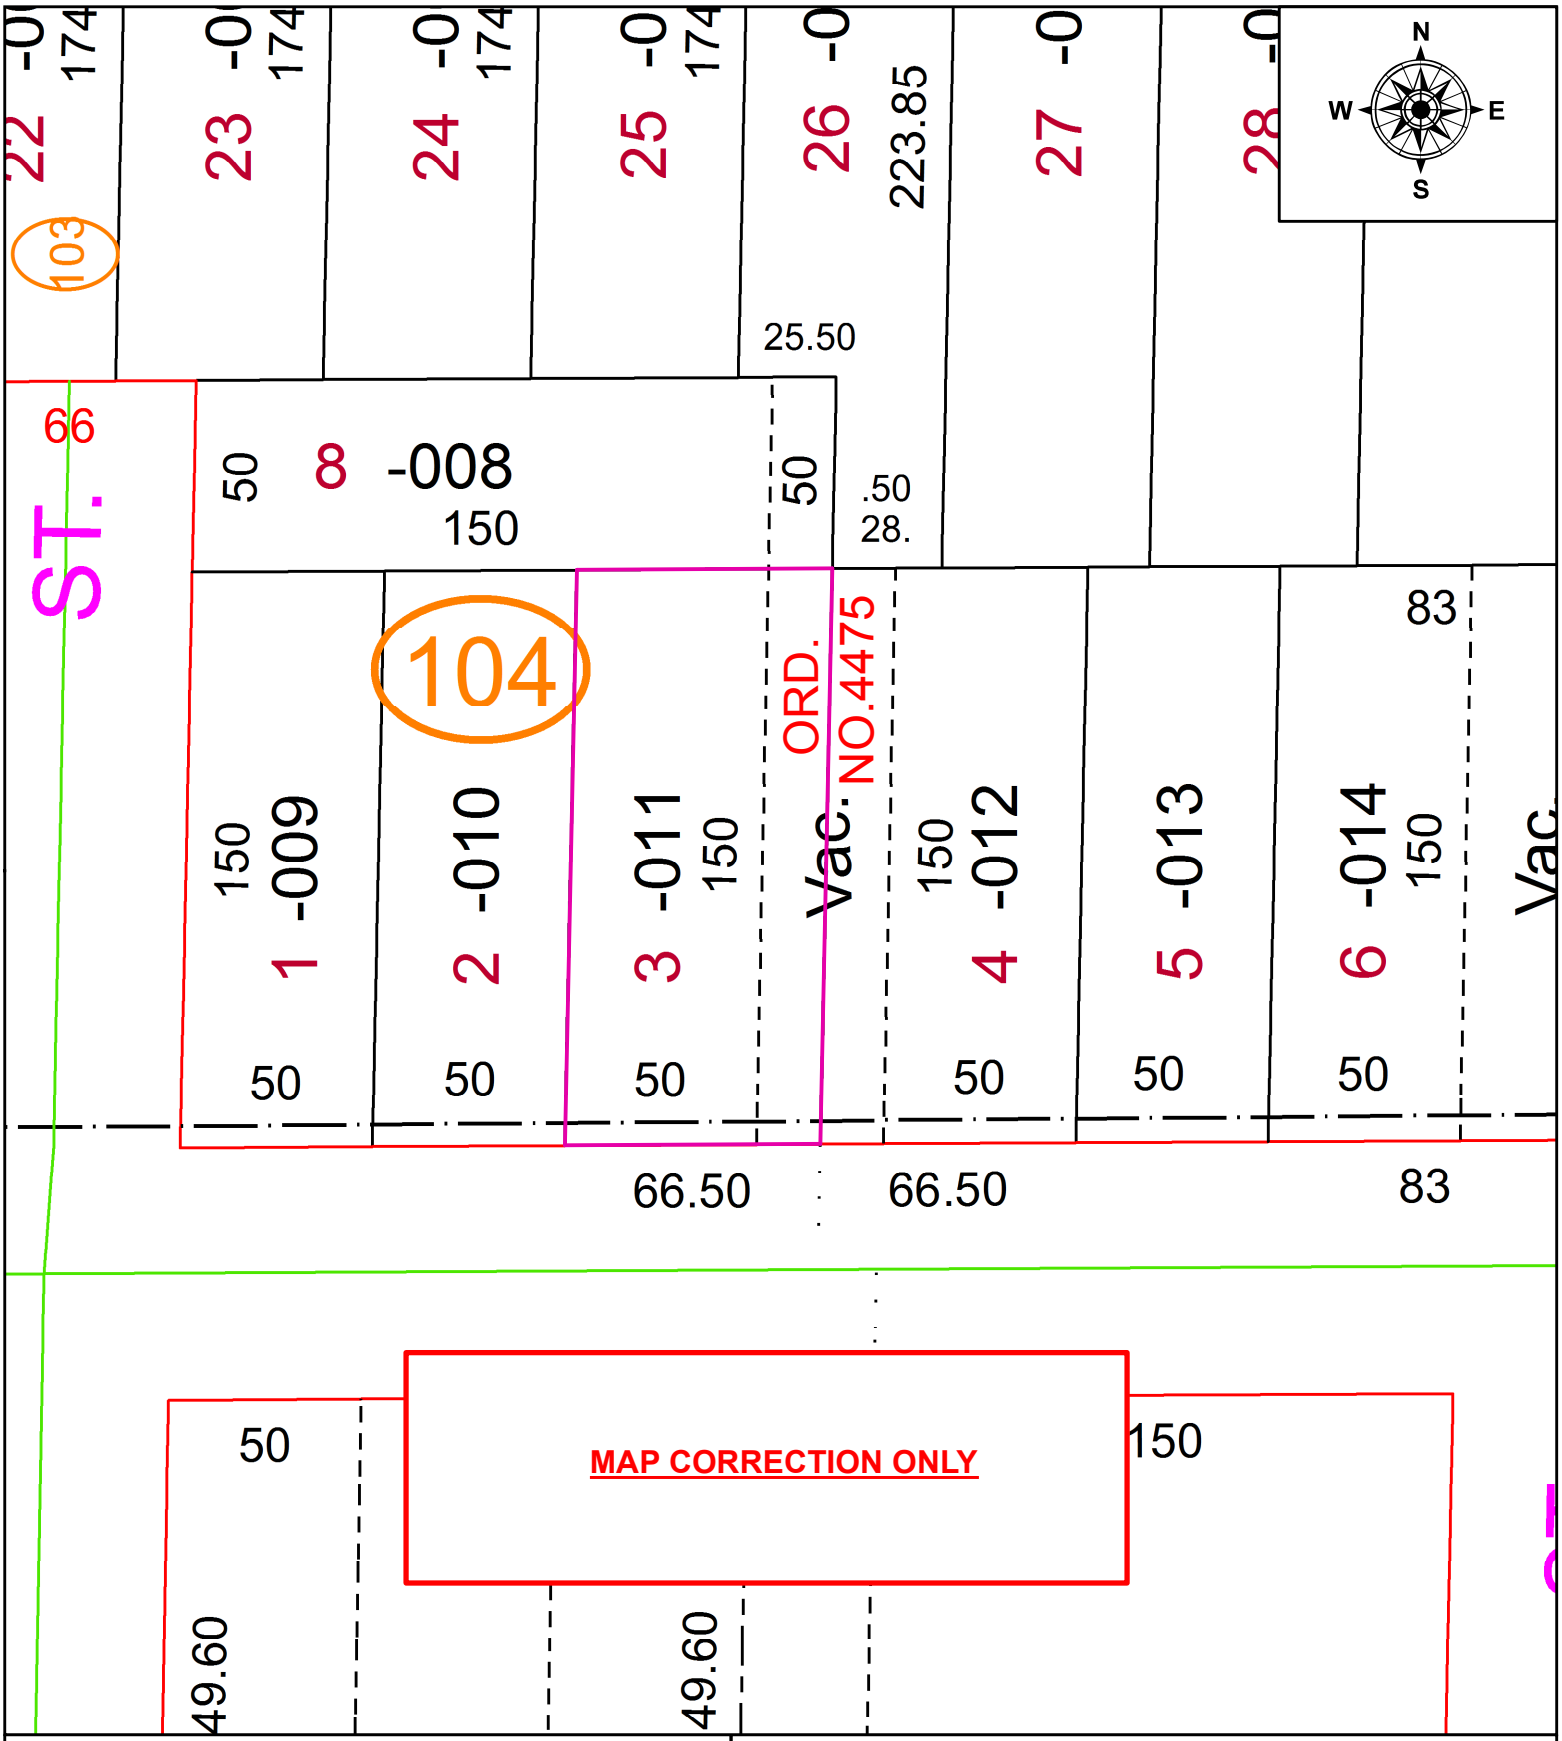

SPLITS/DEEDS PROCESSED

LORAIN COUNTY TAX MAP DEPARTMENT
226 MIDDLE AVE. ELYRIA, OH

SURVEYED BY: SEAN A. BOLAND
CLOSURE: 1: 2147483648
MAP PAGE(S): 6-24-070
APPOVED BY: RRM **DATE:** 2-22-21
SCALE: 1" = 50 **PRIOR INSTRUMENT:** 20140495095