PARENT PARCEL: 10-00-007-104-003

CHILD PARCEL:

STARTING POINT: INTERSECTION OF C/L OF BUTTERNUT RIDGE RD. AND C/L OF MIDDLE AVE.

21-04496-A

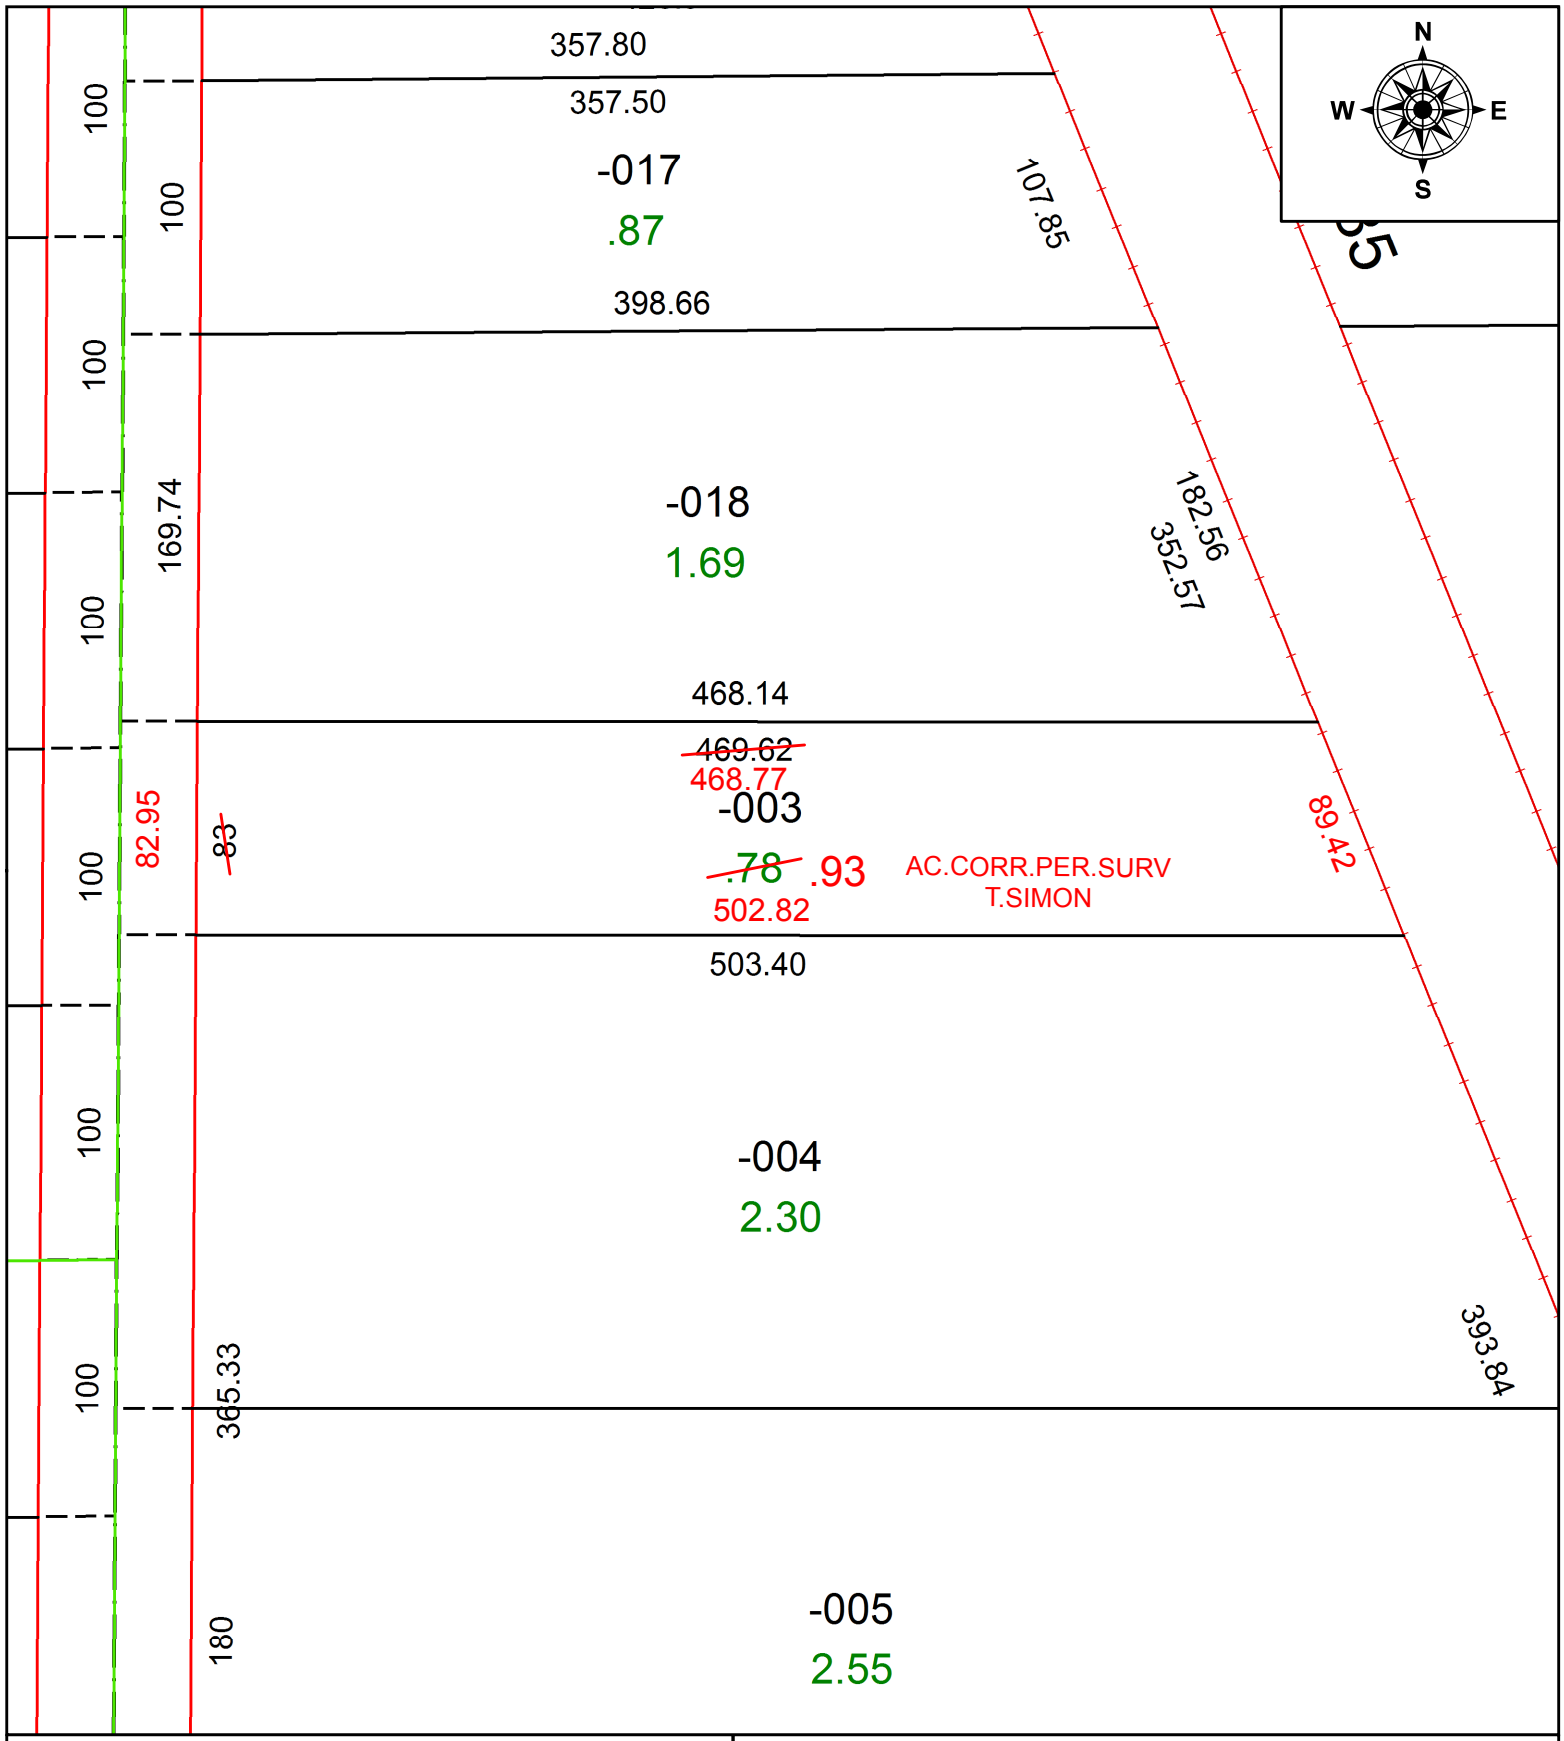

SPLITS/DEEDS PROCESSED

LORAIN COUNTY TAX MAP DEPARTMENT
226 MIDDLE AVE. ELYRIA, OH

SURVEYED BY: THOMAS A. SIMON
CLOSURE: 1:374,668
MAP PAGE(S): 10-00-007
APPOVED BY: RRM **DATE:** 2-26-21
SCALE: 1" = 75 **PRIOR INSTRUMENT:** 20200791993