PARENT PARCEL: 13-09-007-000-013 & 13-09-008-000-001

CHILD PARCEL: 13-09-007-000-014, -015 & -016 **13-09-008-000-001 AC. CORR.**

STARTING POINT: CL OF PUEBLO DR. & LINE BETWEEN O.L 20 & 21

22-04497

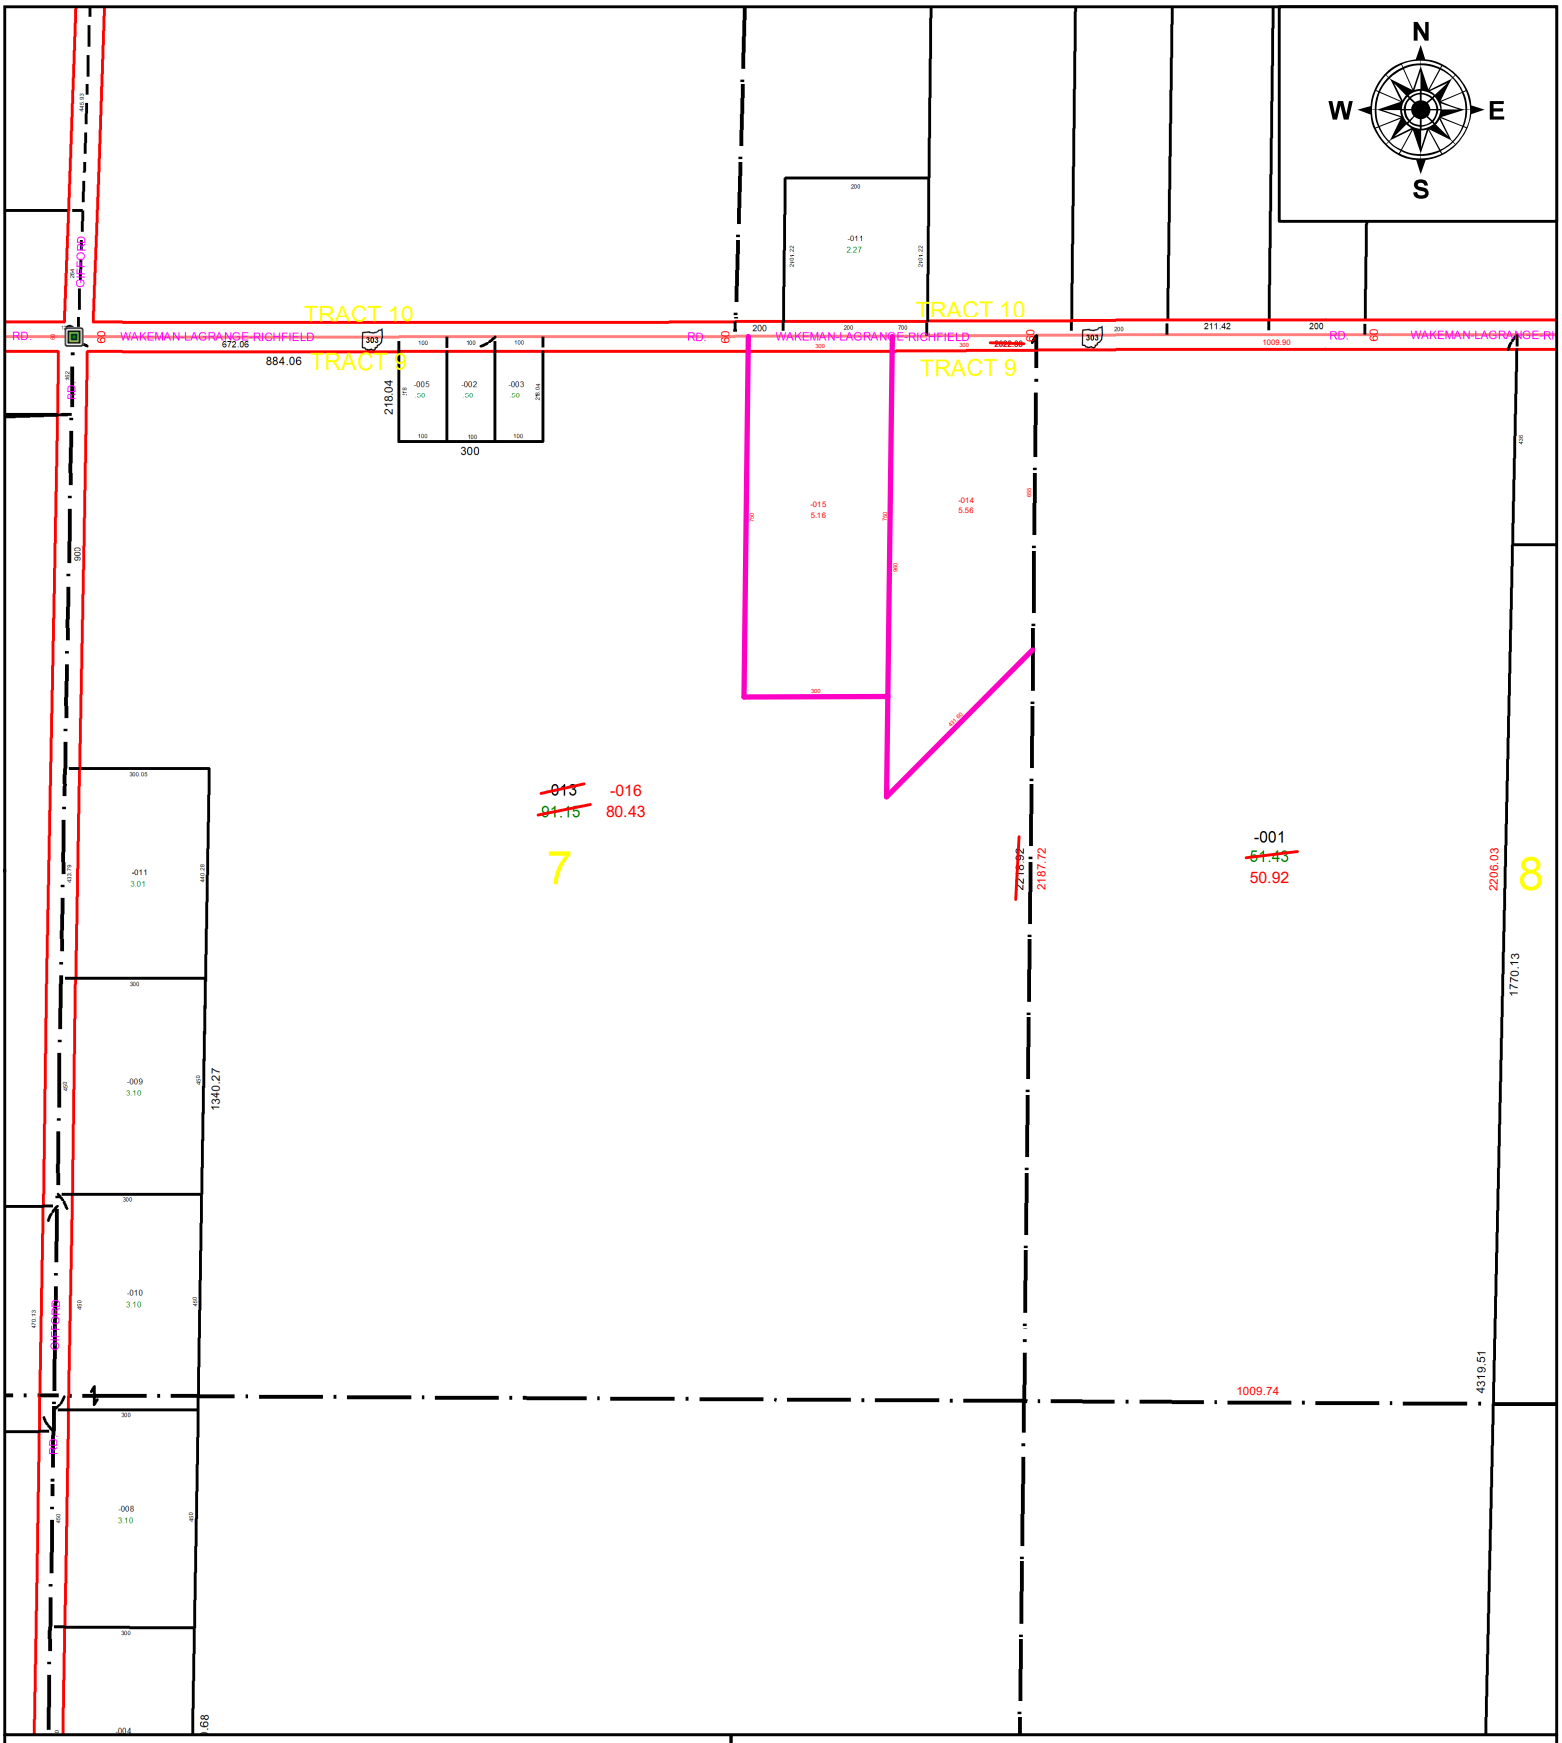

SPLITS/DEEDS PROCESSED

LORAIN COUNTY TAX MAP DEPARTMENT
226 MIDDLE AVE. ELYRIA, OH

SURVEYED BY: LOIUS GIFFELS
CLOSURE: 1: 1402079
MAP PAGE(S): 13-09-007 & -008
APPOVED BY: DMA **DATE:** 6/10/2022
SCALE: 1" = 400' **PRIOR INSTRUMENT:** 2021-0852009