PARENT PARCEL: 01-00-033-000-018, 01-00-048-000-004

CHILD PARCEL: 01-00-033-000-061 THRU -064, 01-00-048-000-007 TRHU -010

STARTING POINT: C/L OF DARROW RD WITH E LINE OF O/L 33

22-04498

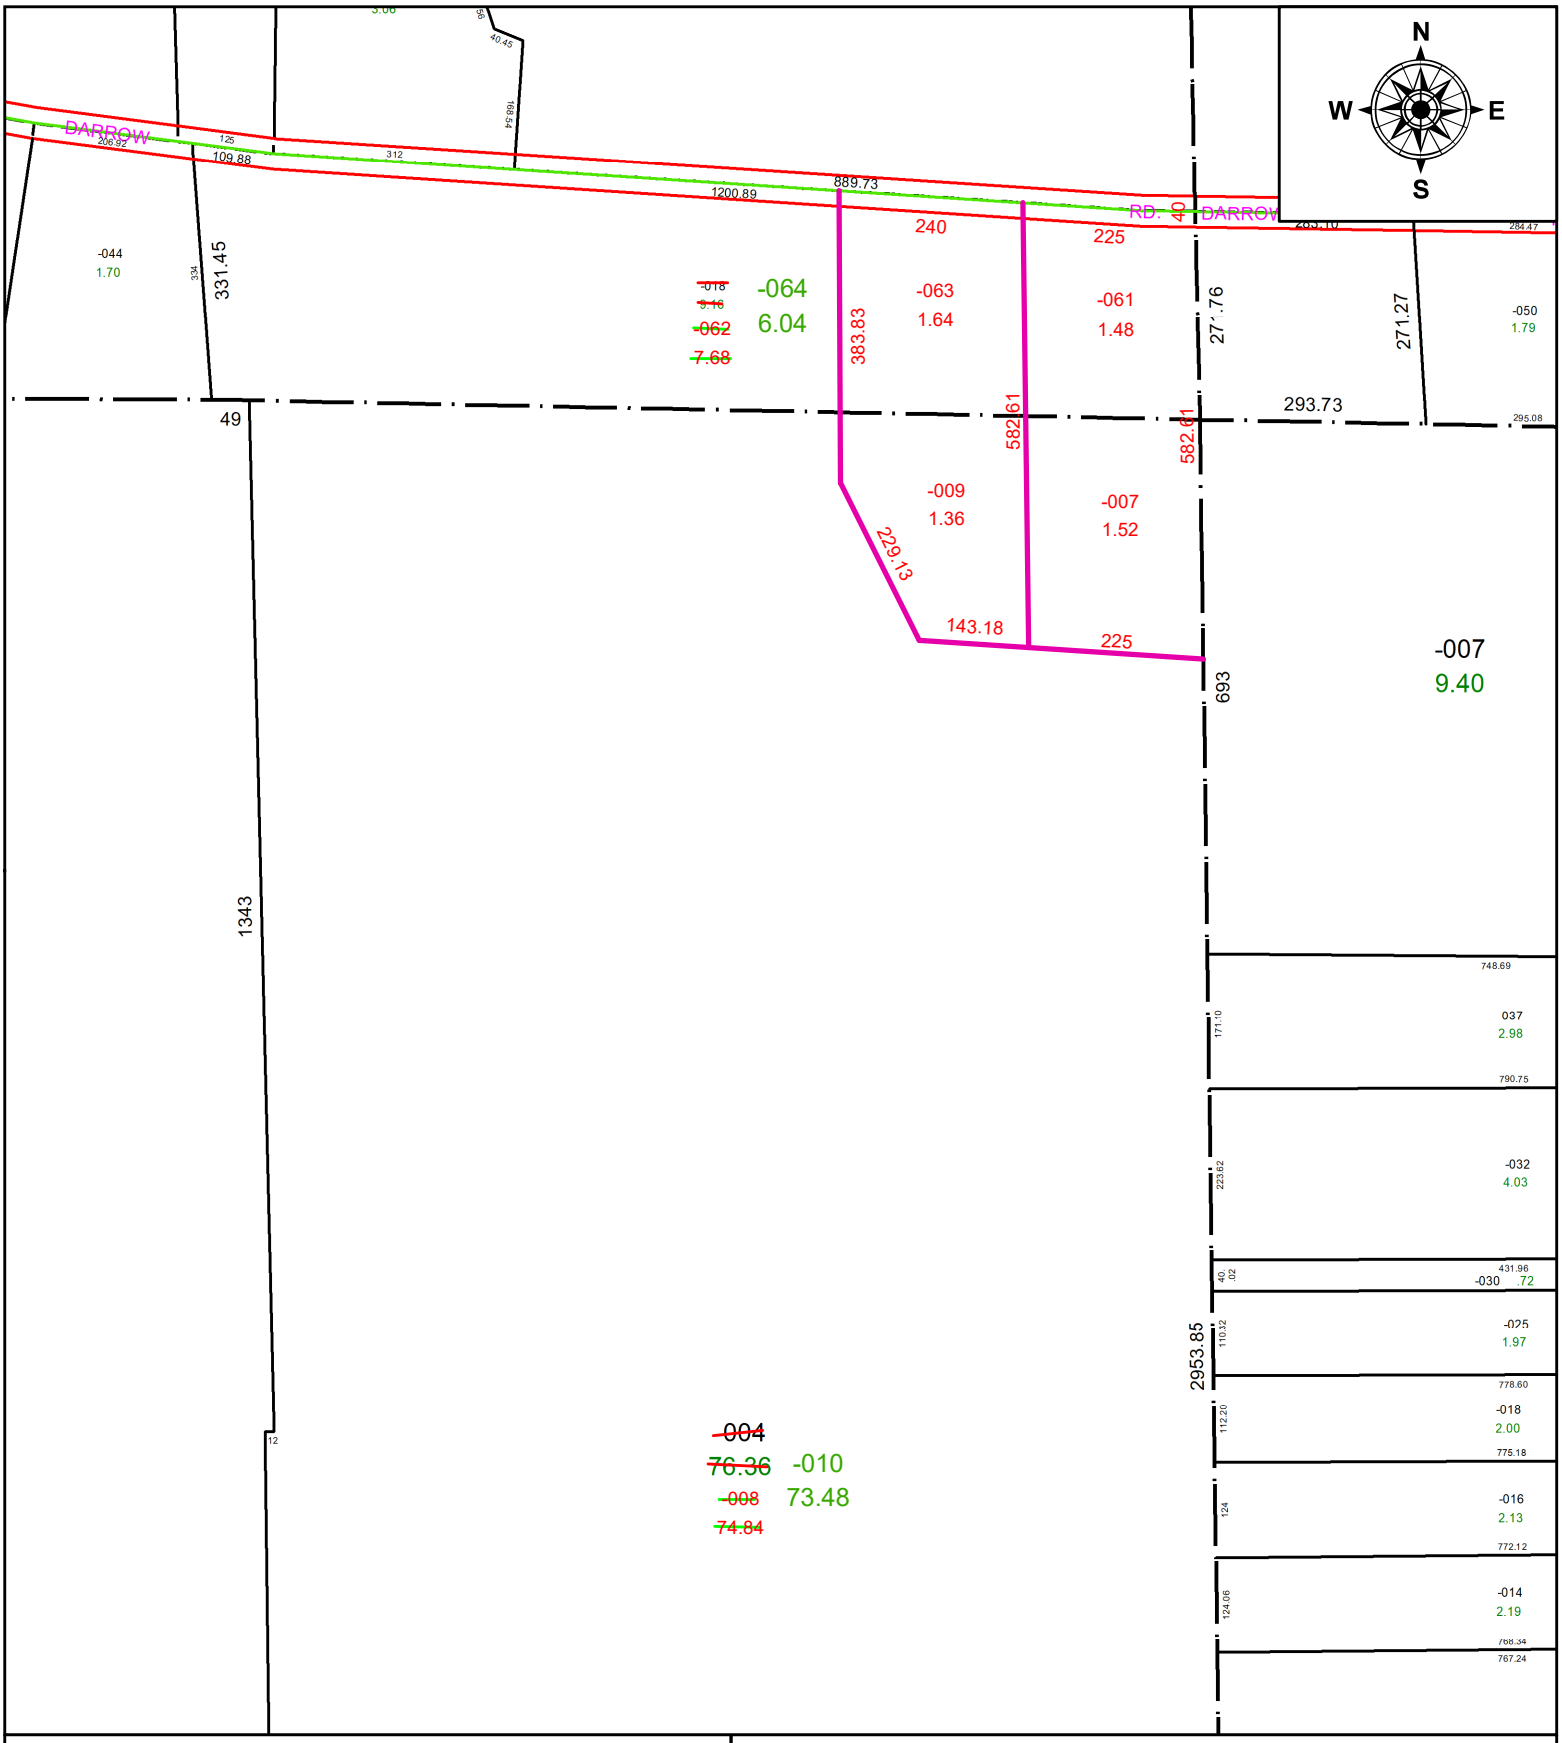

SPLITS/DEEDS PROCESSED

LORAIN COUNTY TAX MAP DEPARTMENT
226 MIDDLE AVE. ELYRIA, OH

SURVEYED BY: DANIEL E. HARTLUNG JR.
CLOSURE: 1: 2147483648
MAP PAGE(S): 01-00-033 & -048
APPOVED BY: AC **DATE:** 6/10/2022
SCALE: 1" = 250 **PRIOR INSTRUMENT:** 2021- 0851053