PARENT PARCEL: 06-23-030-101-028

CHILD PARCEL:

STARTING POINT: INTERSECTION OF C/L OF ABBE RD. AND C/L OF THORNWOOD BLVD.

21-04501-C

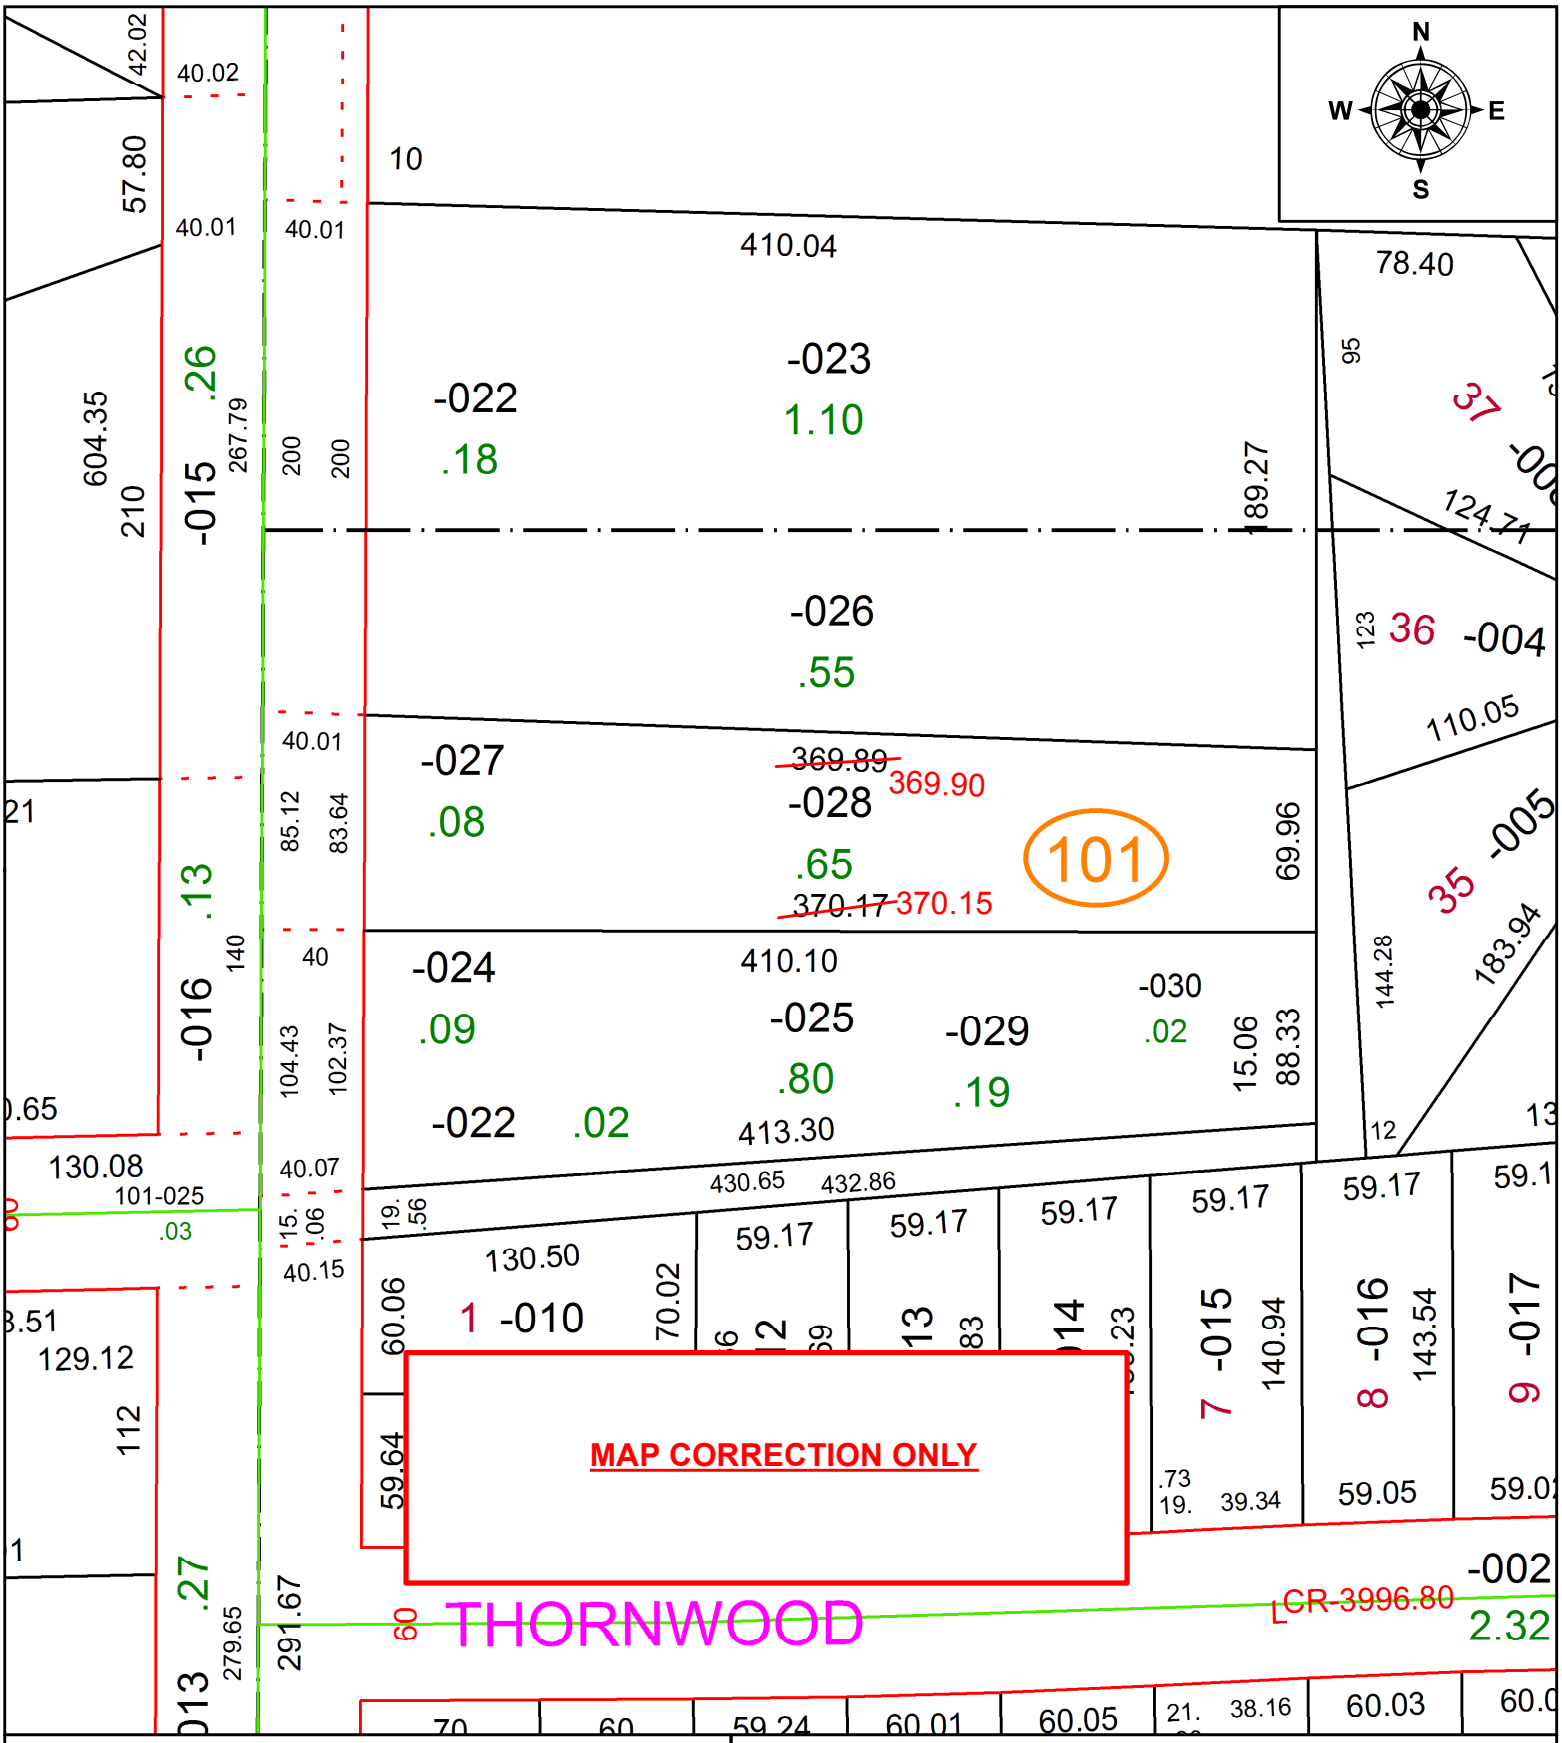

SPLITS/DEEDS PROCESSED

LORAIN COUNTY TAX MAP DEPARTMENT
226 MIDDLE AVE. ELYRIA, OH

SURVEYED BY: SEAN A. BOLAND
CLOSURE: 1:308,449
MAP PAGE(S): 6-23-030
APPOVED BY: RRM **DATE:** 3-19-21
SCALE: 1" = 75 **PRIOR INSTRUMENT:** 20180661425