PARENT PARCEL: 10-00-009-101-006 & -007

CHILD PARCEL: 10-00-009-101-008 THRU -011 AC CORR PER SURVEYOR TIMOTHY HOZALSKI

STARTING POINT: INTERSECTION OF C/LS OF WEST RIDGE RD & RUSSIA RD AT A MONUMENT BOX

22-04502

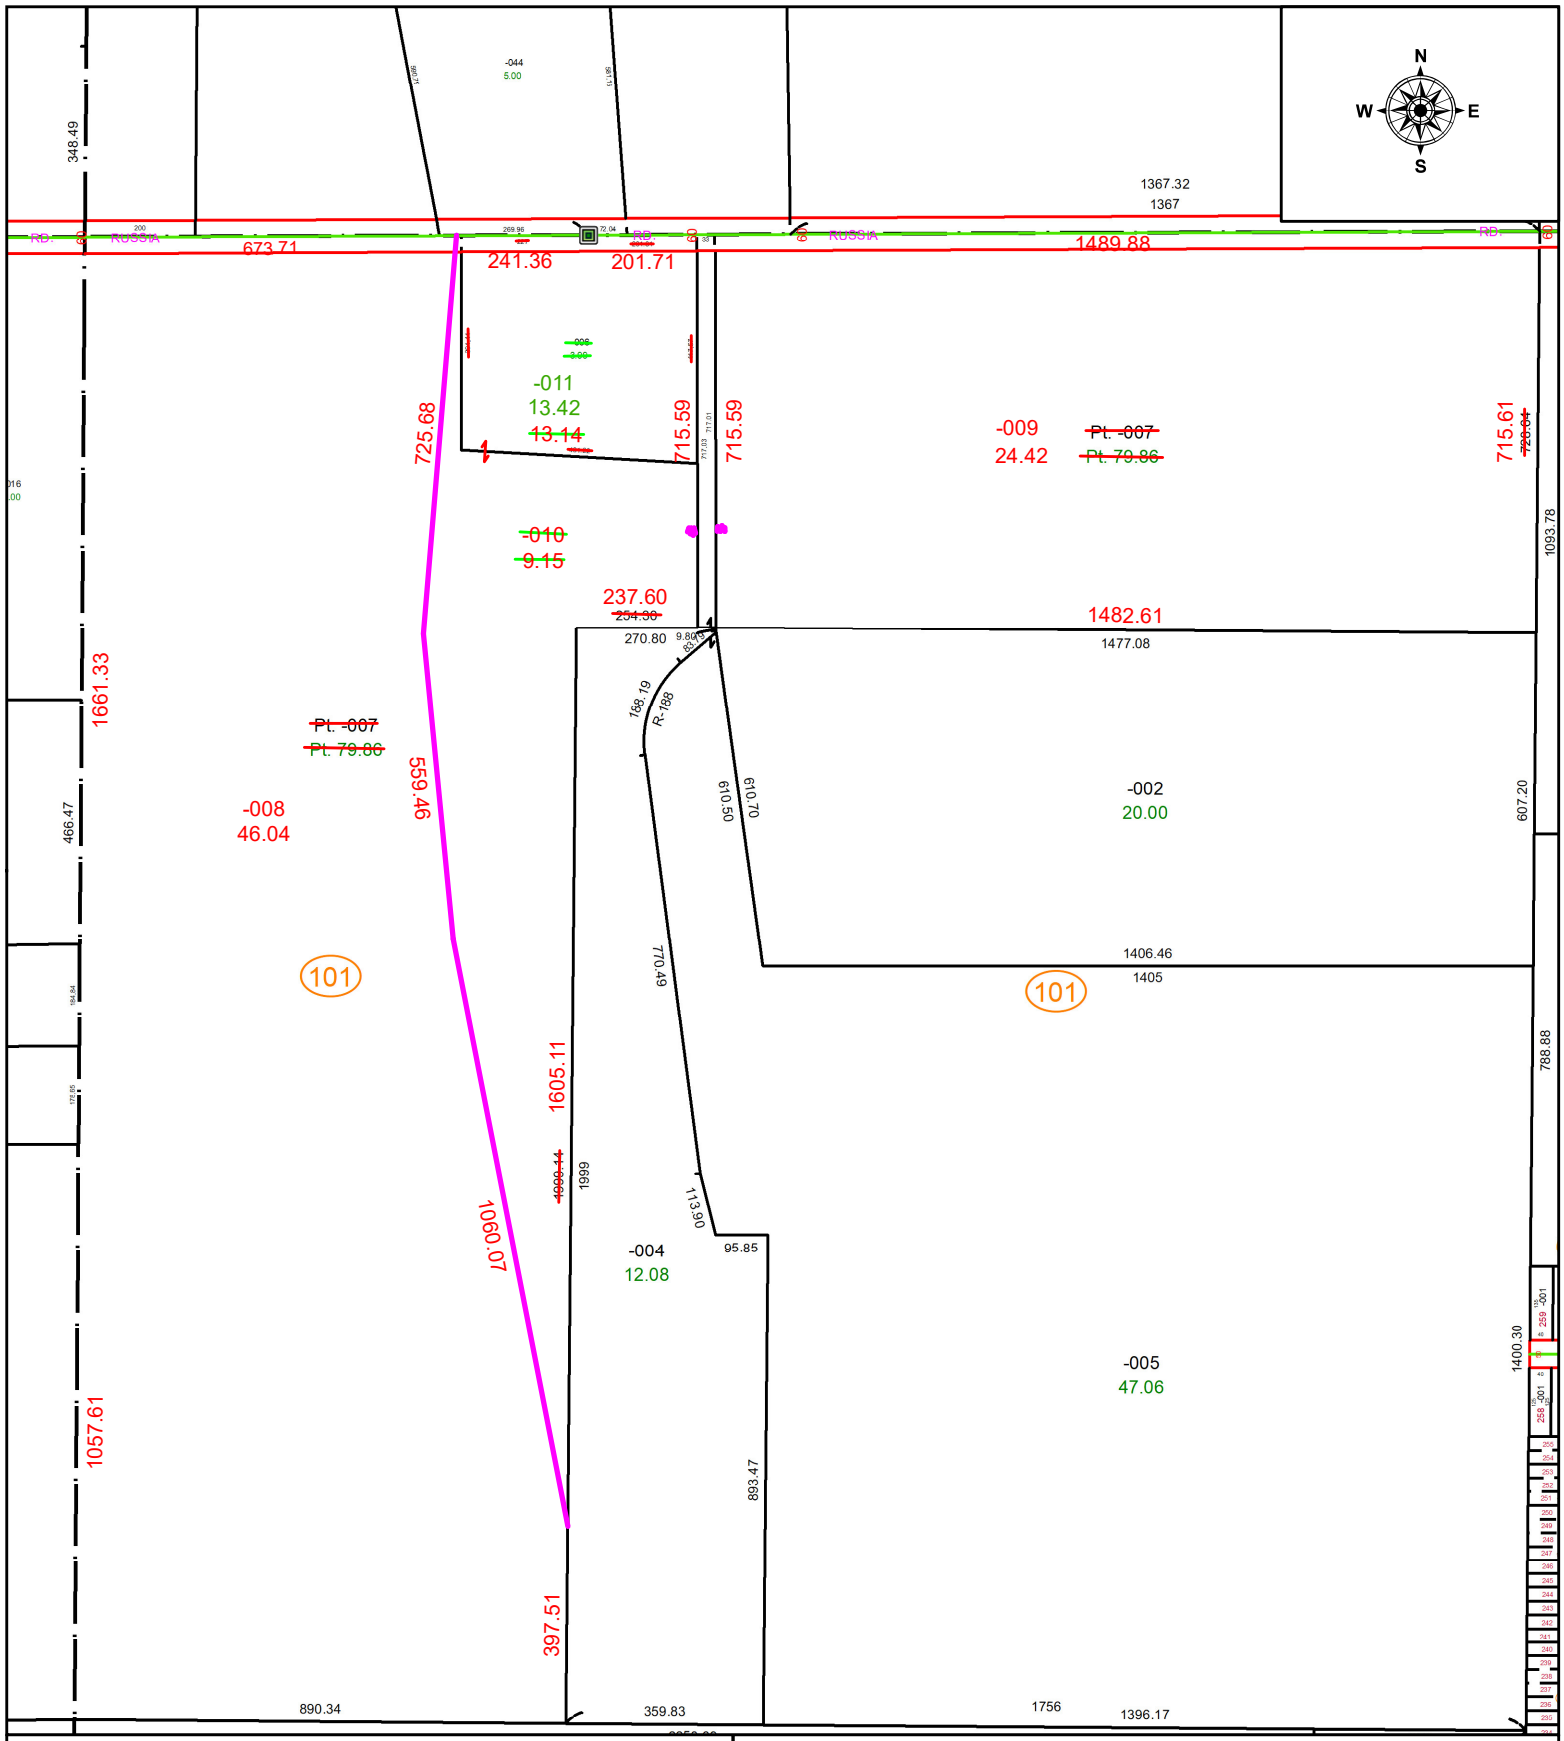

SPLITS/DEEDS PROCESSED

LORAIN COUNTY TAX MAP DEPARTMENT
226 MIDDLE AVE. ELYRIA, OH

SURVEYED BY: TIMOTHY HOZALSKI SURVEY # 50604

CLOSURE: 1: 1420169

MAP PAGE(S): 10-00-009

APPOVED BY: WRZ **DATE:** 6/14/2022

SCALE: 1" = 350 **PRIOR INSTRUMENT:** 2017-0643194