PARENT PARCEL: 09-00-086-108-010

CHILD PARCEL:

STARTING POINT: INTERSECTION OF C/L OF GROVELAND ST. AND C/L OF S, PARK ST.

21-04504-D

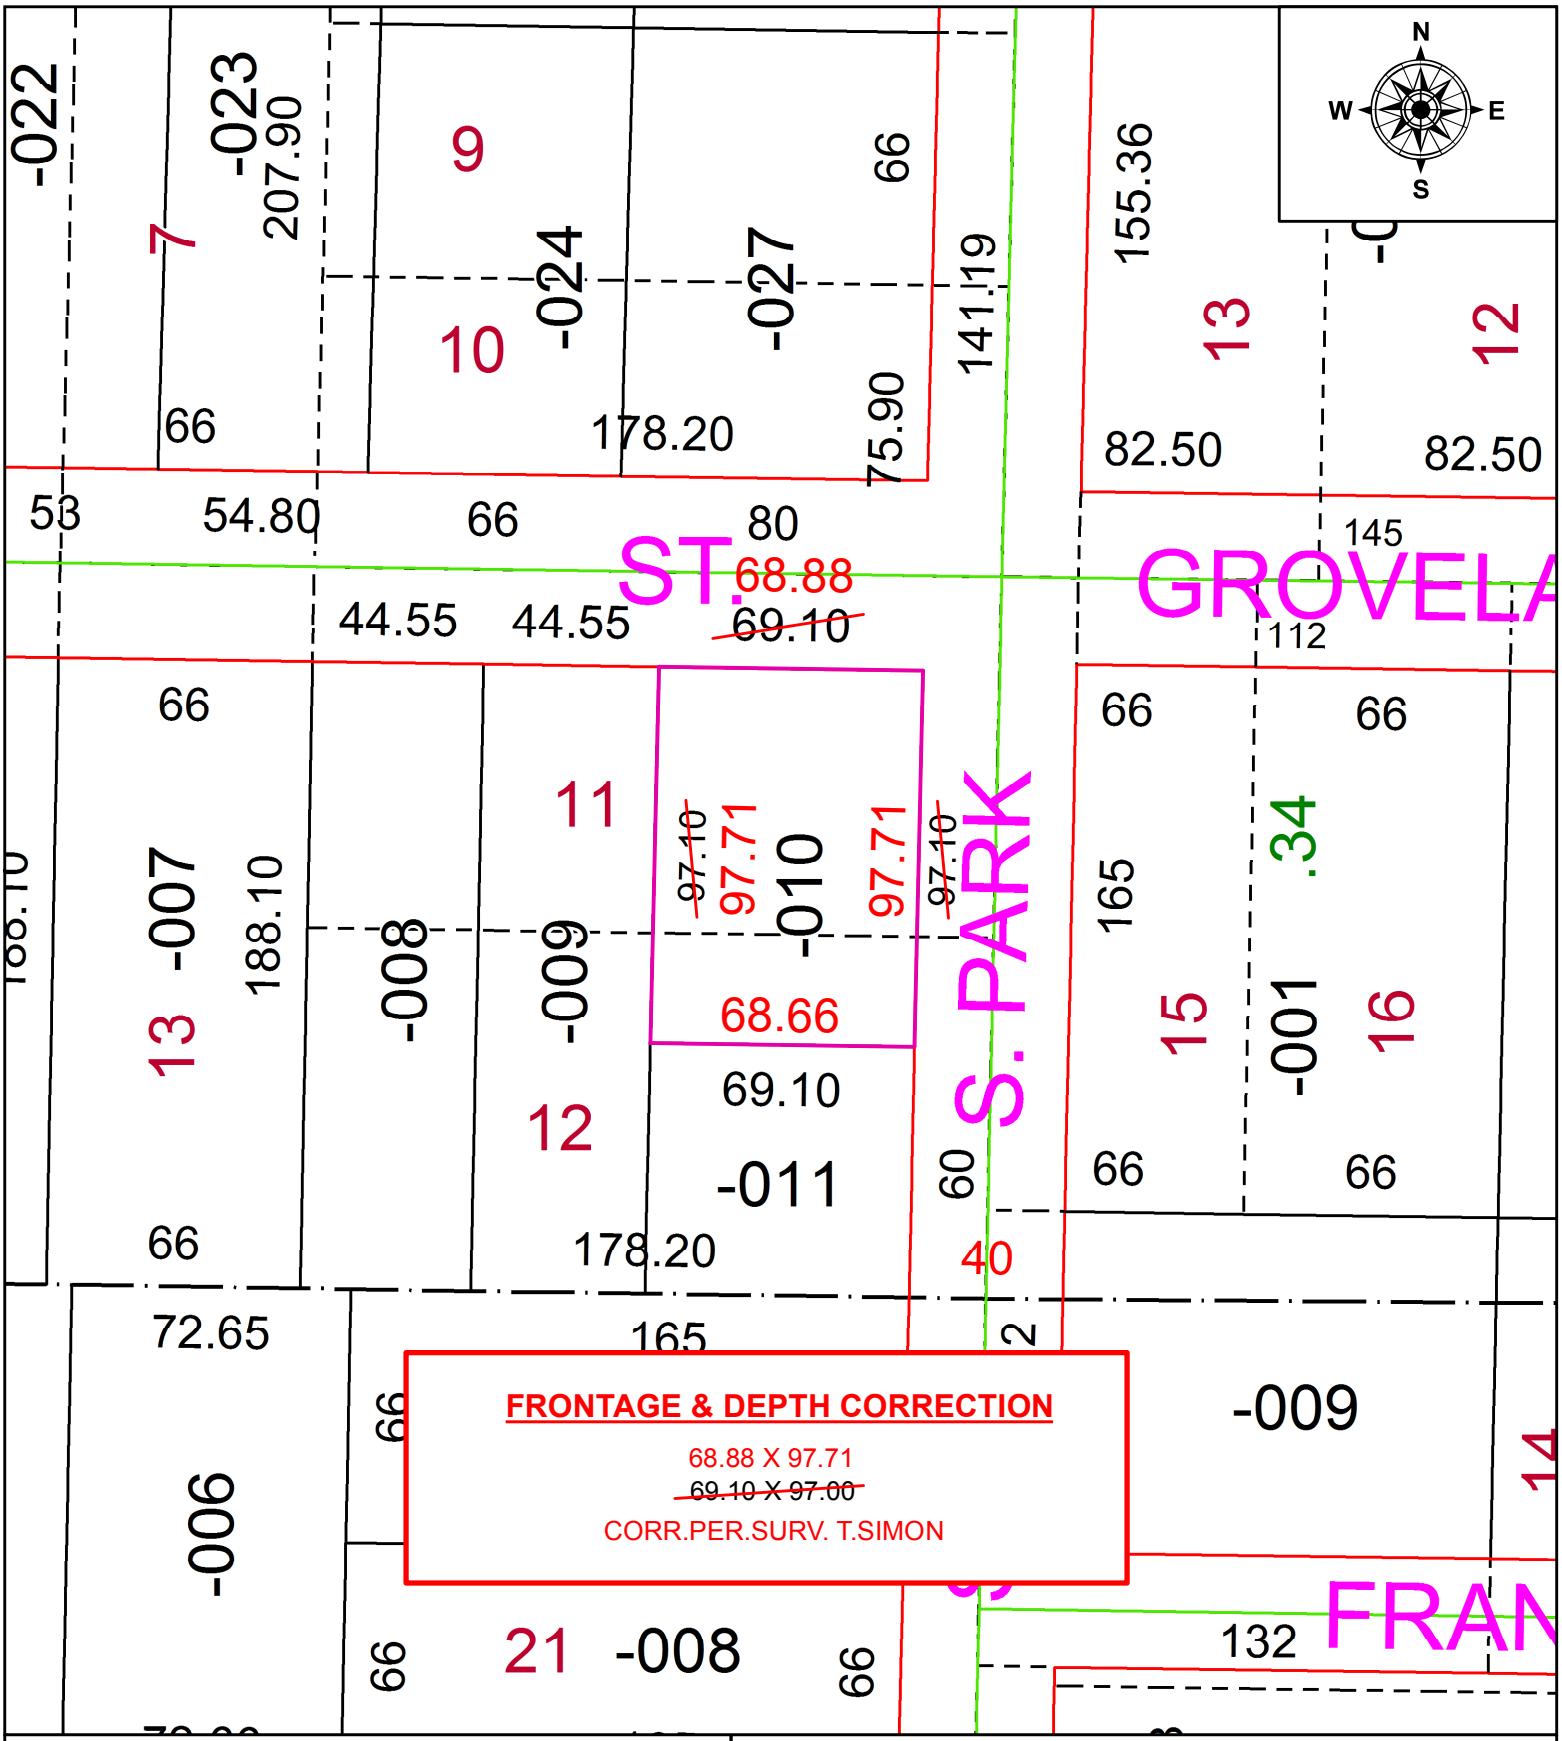

FRONTAGE & DEPTH CORRECTION

68.88 X 97.71

~~69.10 X 97.00~~

CORR.PER.SURV. T.SIMON

SPLITS/DEEDS PROCESSED

LORAIN COUNTY TAX MAP DEPARTMENT
226 MIDDLE AVE. ELYRIA, OH

SURVEYED BY: THOMAS A. SIMON
CLOSURE: 1: 67,010
MAP PAGE(S): 9-00-086
APPOVED BY: RRM **DATE:** 3-19-21
SCALE: 1" = 50 **PRIOR INSTRUMENT:** 20170617790