PARENT PARCEL: 09-00-022-000-006, -007

CHILD PARCEL: 09-00-022-000-012, -013

STARTING POINT: AC CORR PER SURV BY AMY M. KELLY

22-04504

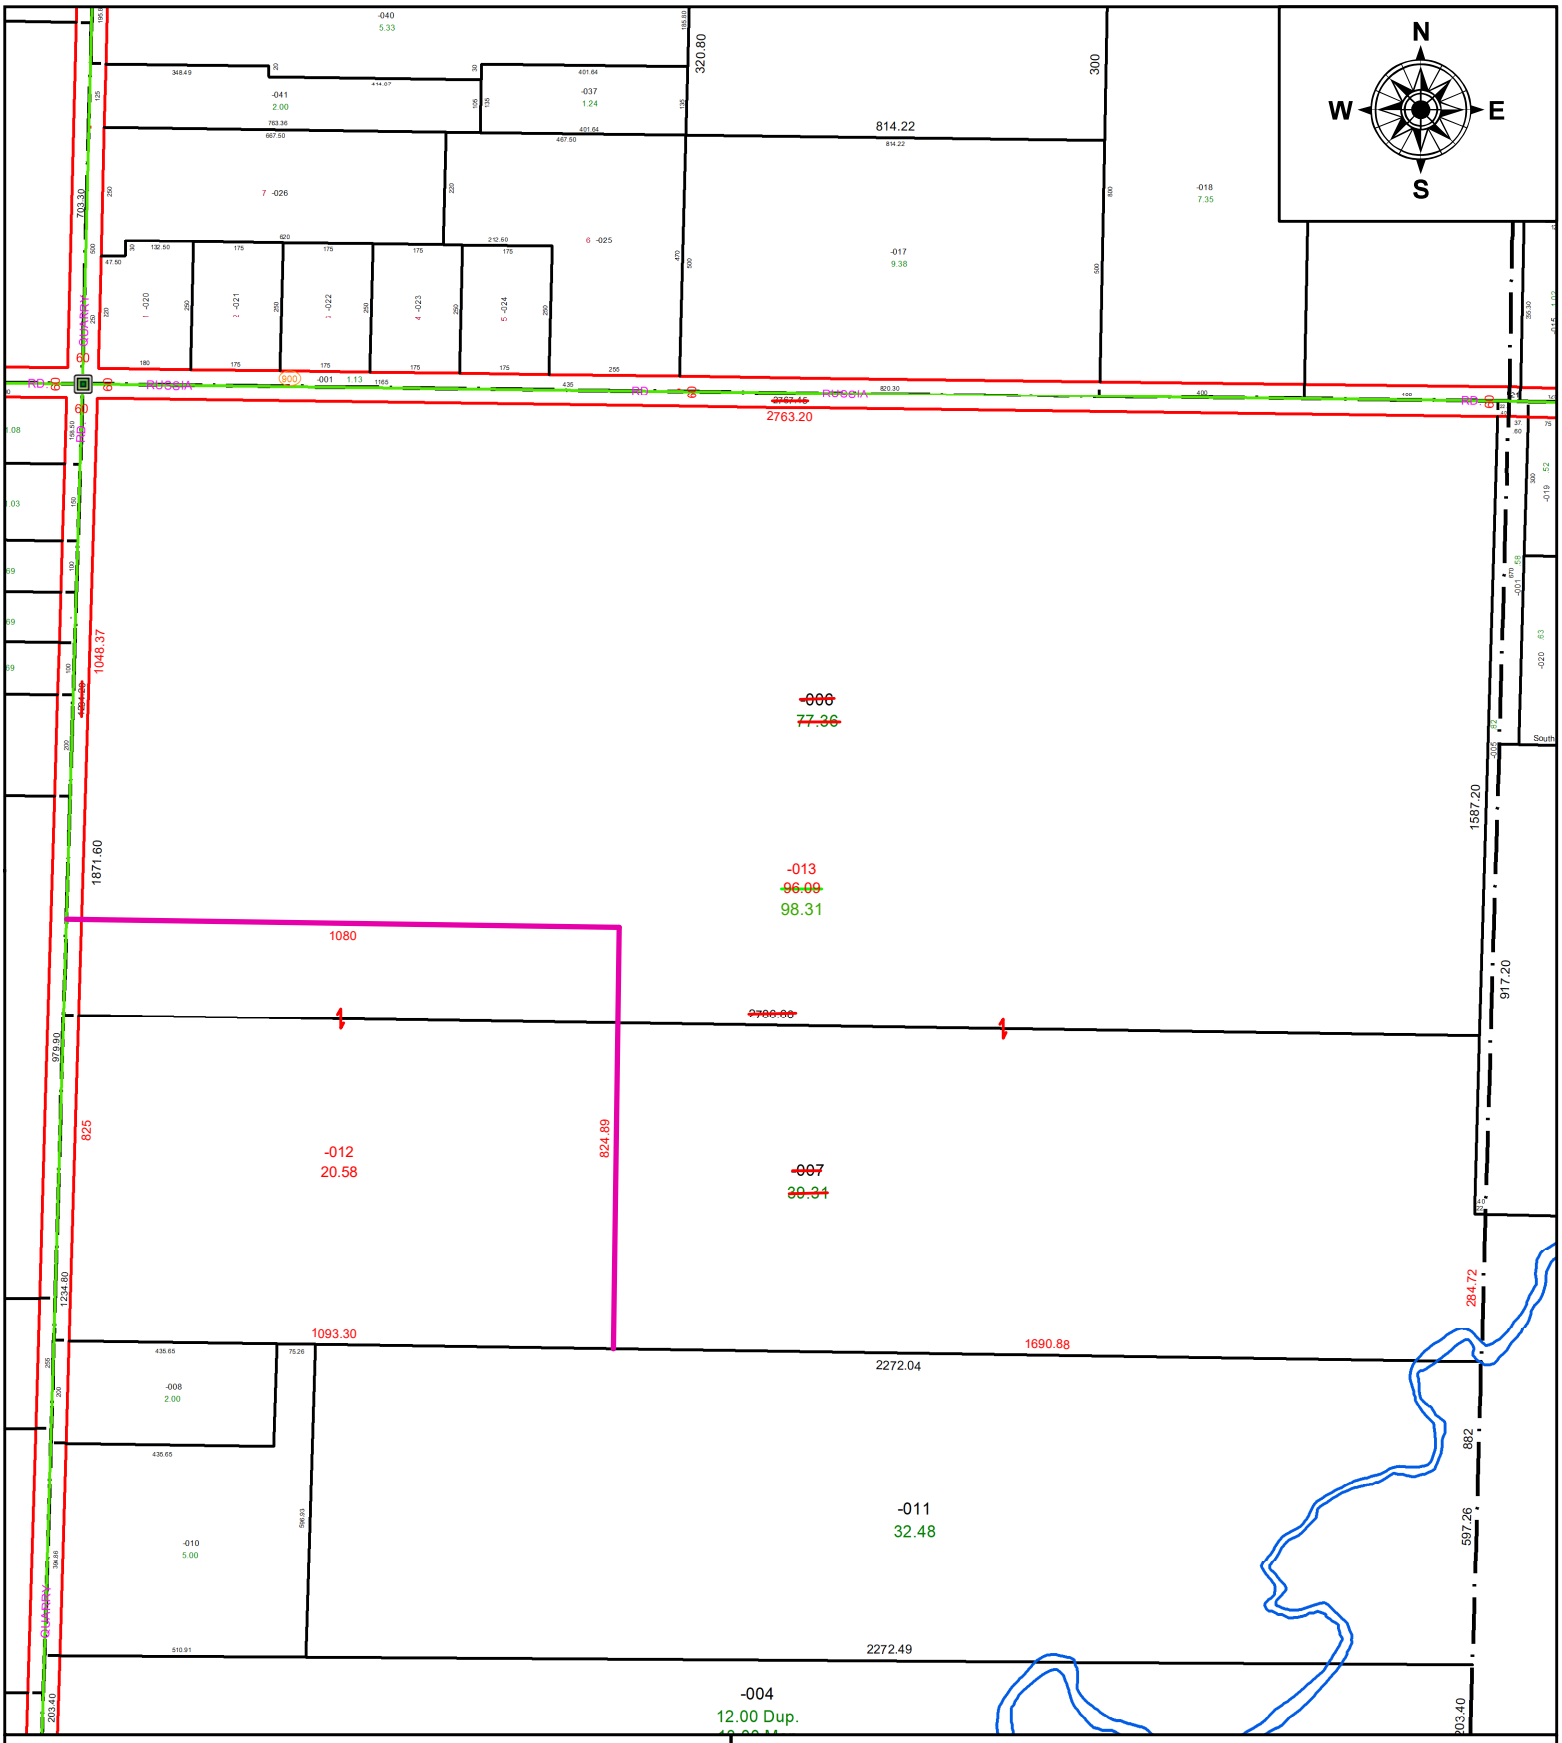

SPLITS/DEEDS PROCESSED

LORAIN COUNTY TAX MAP DEPARTMENT
226 MIDDLE AVE. ELYRIA, OH

SURVEYED BY: AMY M. KELLY
CLOSURE: 1: 613369
MAP PAGE(S): 09-00-022
APPOVED BY: AC **DATE:** 6/14/2022
SCALE: 1" = 375 **PRIOR INSTRUMENT:** 2019- 0703526