PARENT PARCEL: 18-00-021-106-058

CHILD PARCEL:

STARTING POINT: NORTHWEST CORNER OF S/L 34 IN ADAMS ADDITION

21-04506-D

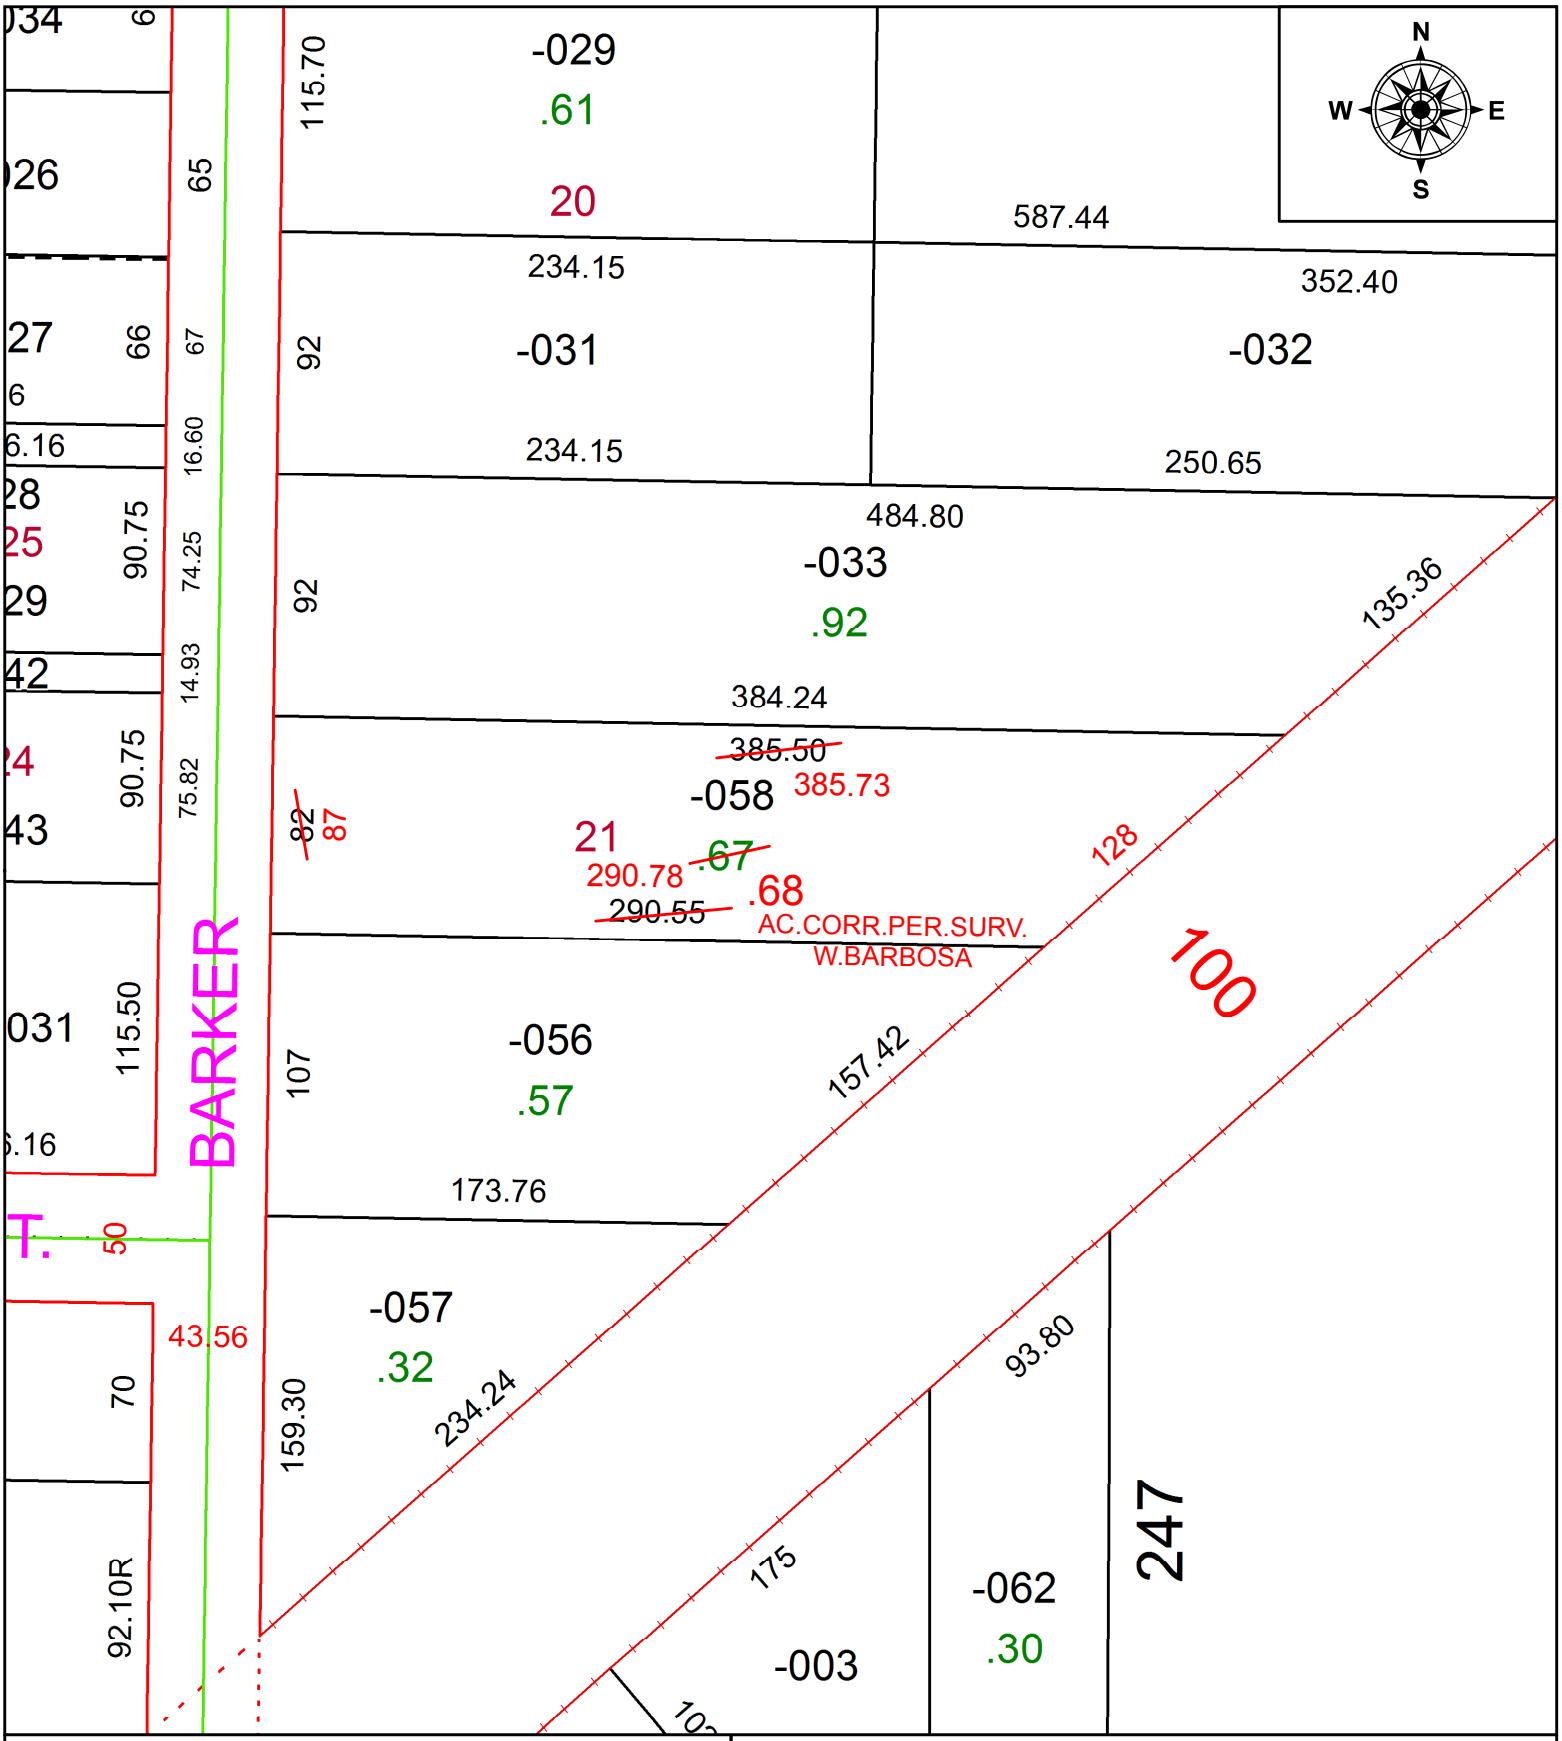

SPLITS/DEEDS PROCESSED

LORAIN COUNTY TAX MAP DEPARTMENT
226 MIDDLE AVE. ELYRIA, OH

SURVEYED BY: WILFREDO BARBOSA
CLOSURE: 1: 270,356
MAP PAGE(S): 18-00-021
APPOVED BY: RRM **DATE:** 3-25-21
SCALE: 1" = 75 **PRIOR INSTRUMENT:** 20170649555