PARENT PARCEL: 05-00-024-118-014 & -015

CHILD PARCEL: 05-00-024-118-029 N/A

STARTING POINT: SOUTHEAST CORNER OF S/L 183 IN JOSIAH HEIRS ADDITION

22-04510

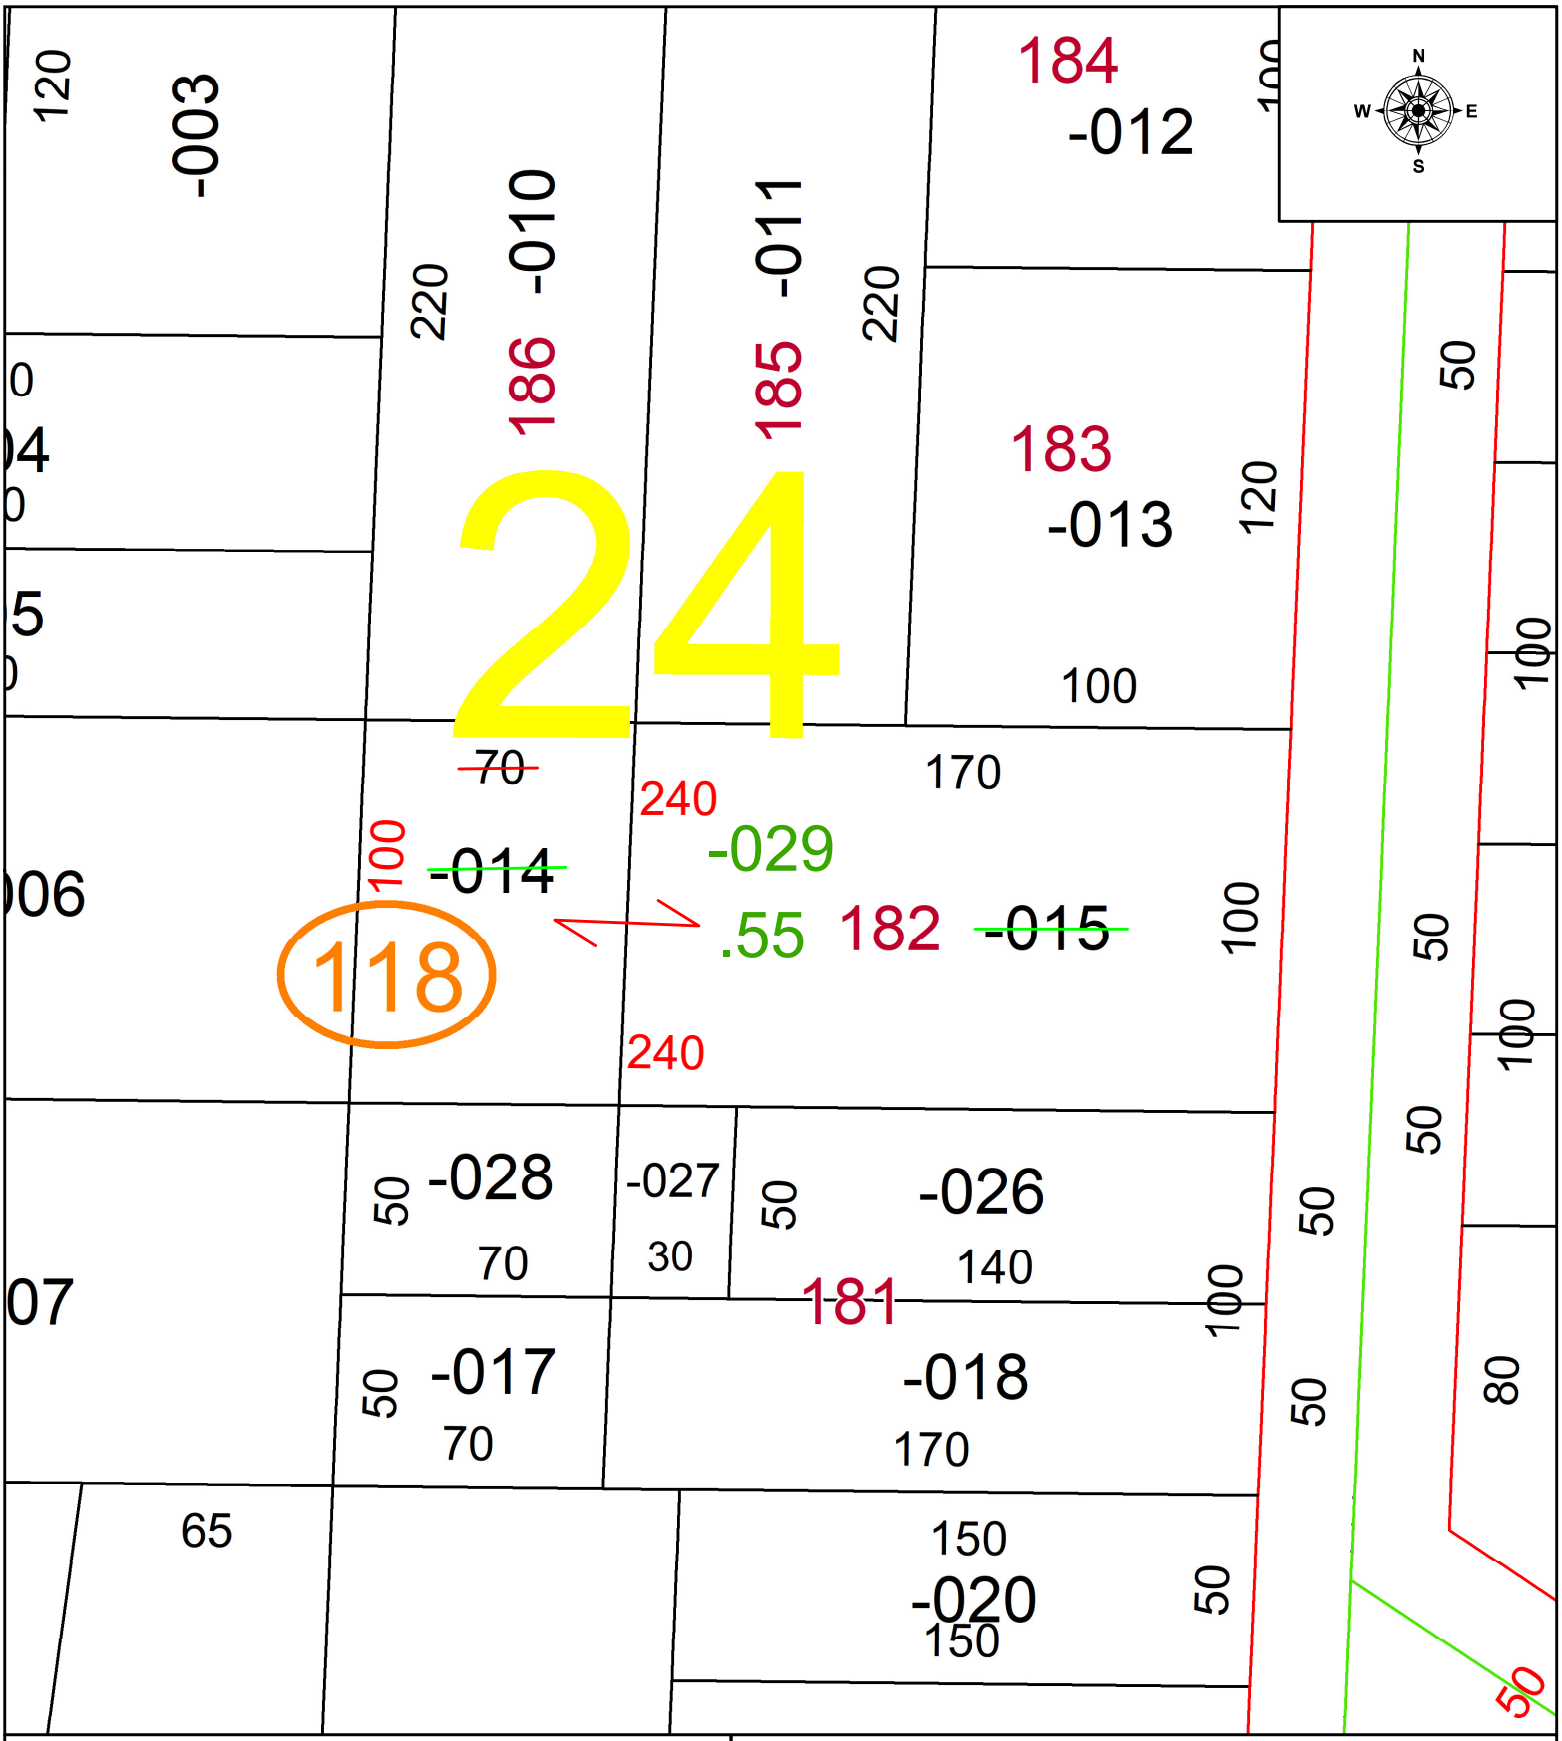

SPLITS/DEEDS PROCESSED

LORAIN COUNTY TAX MAP DEPARTMENT
226 MIDDLE AVE. ELYRIA, OH

SURVEYED BY: PATRICK MCGANNON SURVEY # 50616

CLOSURE: 1: -2147483648

MAP PAGE(S): 05-00-024

APPOVED BY: WRZ **DATE:** 6/23/2022

SCALE: 1" = 50 **PRIOR INSTRUMENT:** 1992-0166802