PARENT PARCEL: 06-24-014-000-029

CHILD PARCEL:

STARTING POINT: INTERSECTION O C/L OF MURRAY RIDGE RD, AND C/L OF LEO BULLOCKS PKWY

21-04513-D

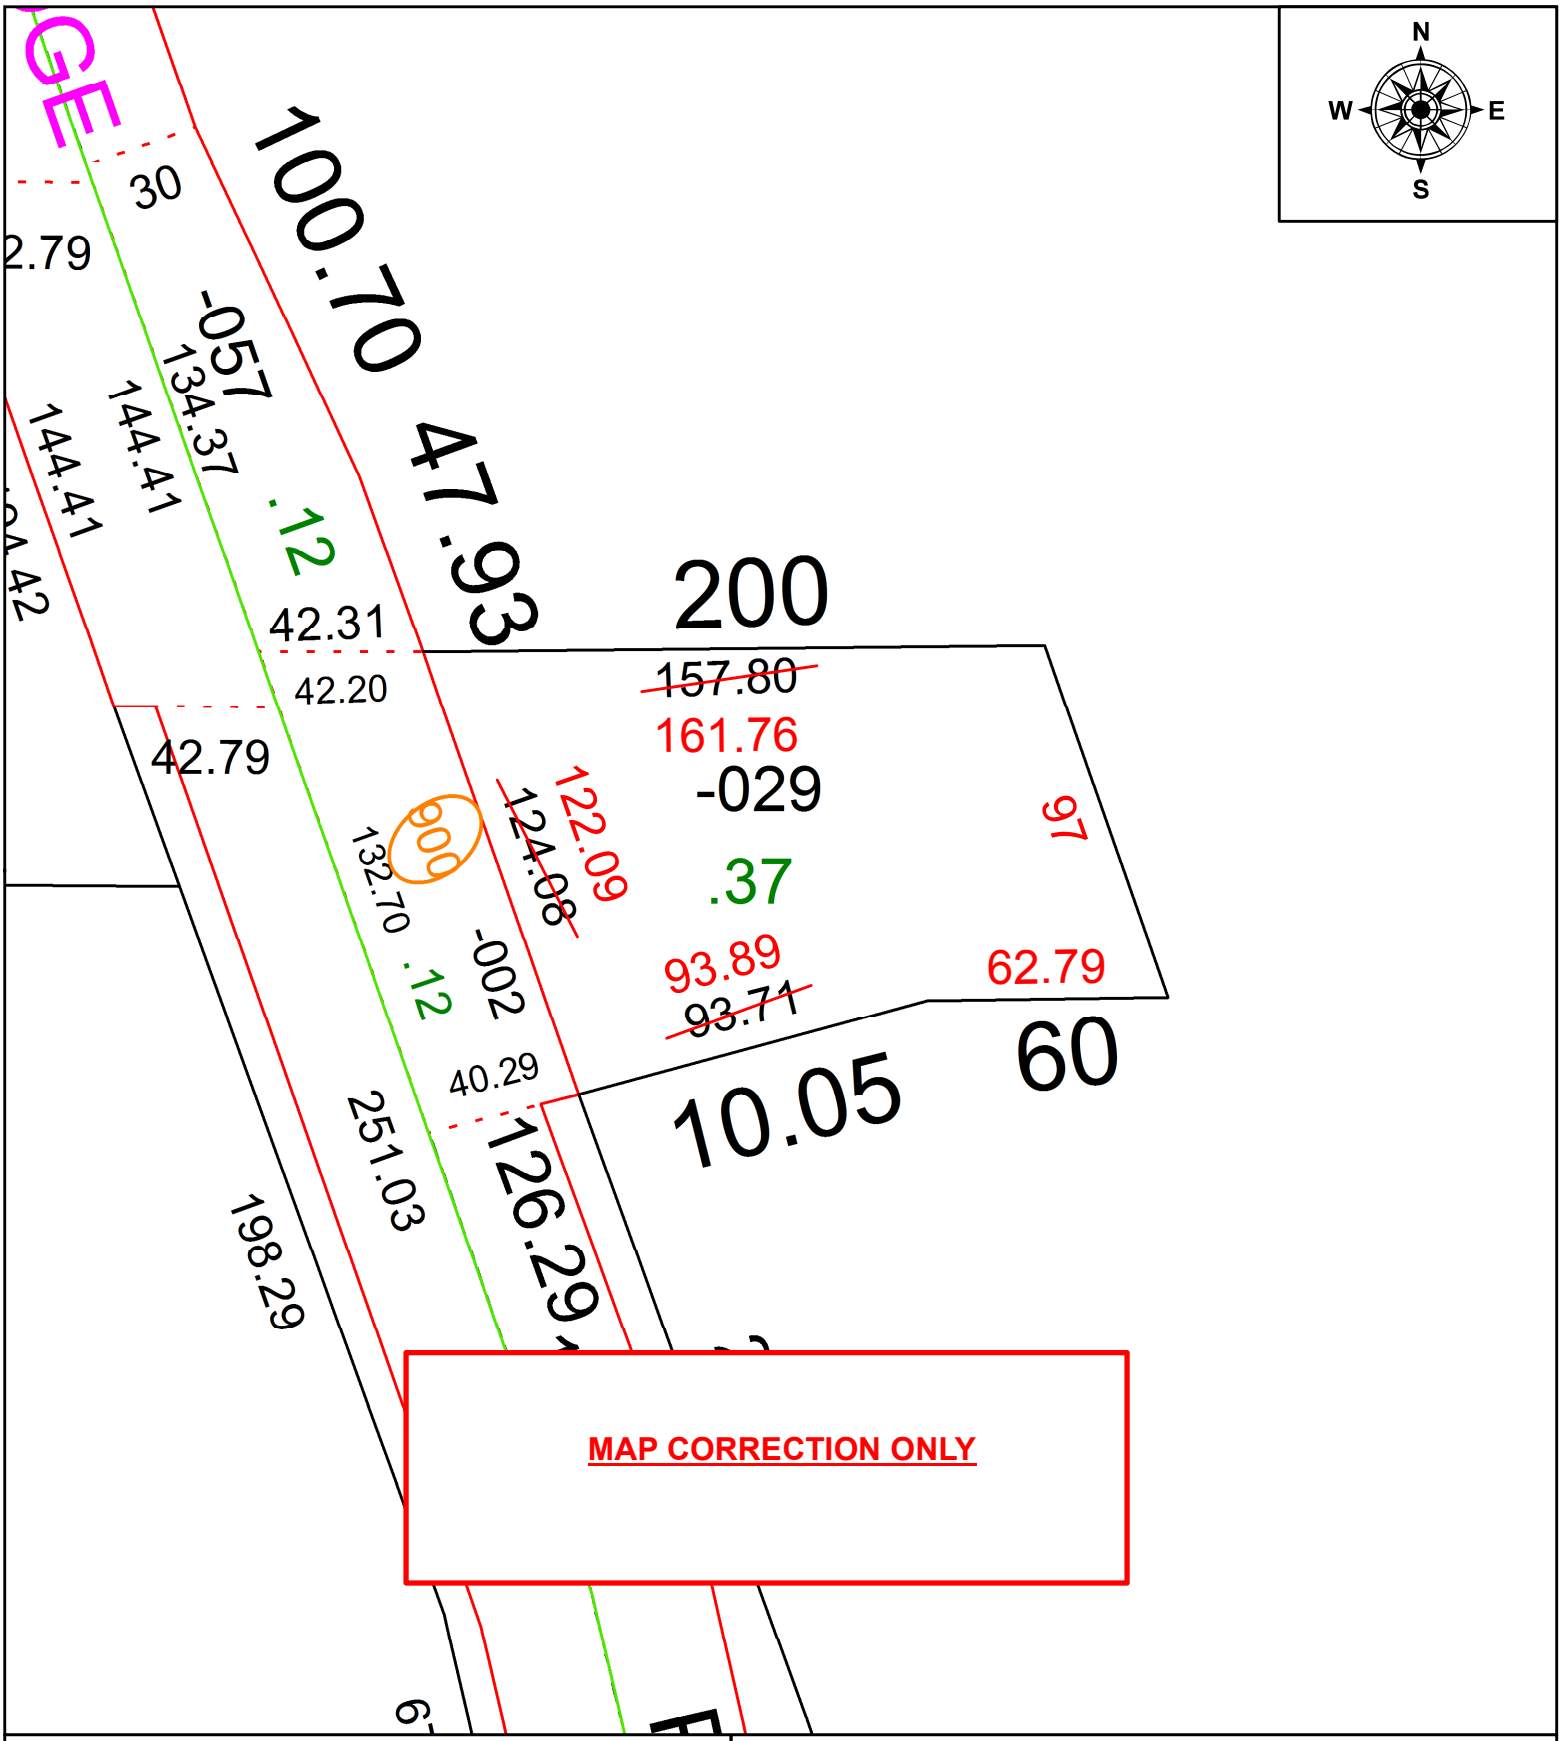

SPLITS/DEEDS PROCESSED

LORAIN COUNTY TAX MAP DEPARTMENT
226 MIDDLE AVE. ELYRIA, OH

SURVEYED BY: WILFREDO BARBOSA
CLOSURE: 1: 70,542
MAP PAGE(S): 6-24-014
APPOVED BY: RRM **DATE:** 3-31-21
SCALE: 1" = 50 **PRIOR INSTRUMENT:** 20040032465