PARENT PARCEL: 03-00-047-101-010 & -011

CHILD PARCEL: 03-00-047-101-030 THRU -035 N/A

STARTING POINT: MAG. NAIL @ INTERSECTION OF C/L OF EAST ERIE AVE & NEBRASKA AVE

22-04514

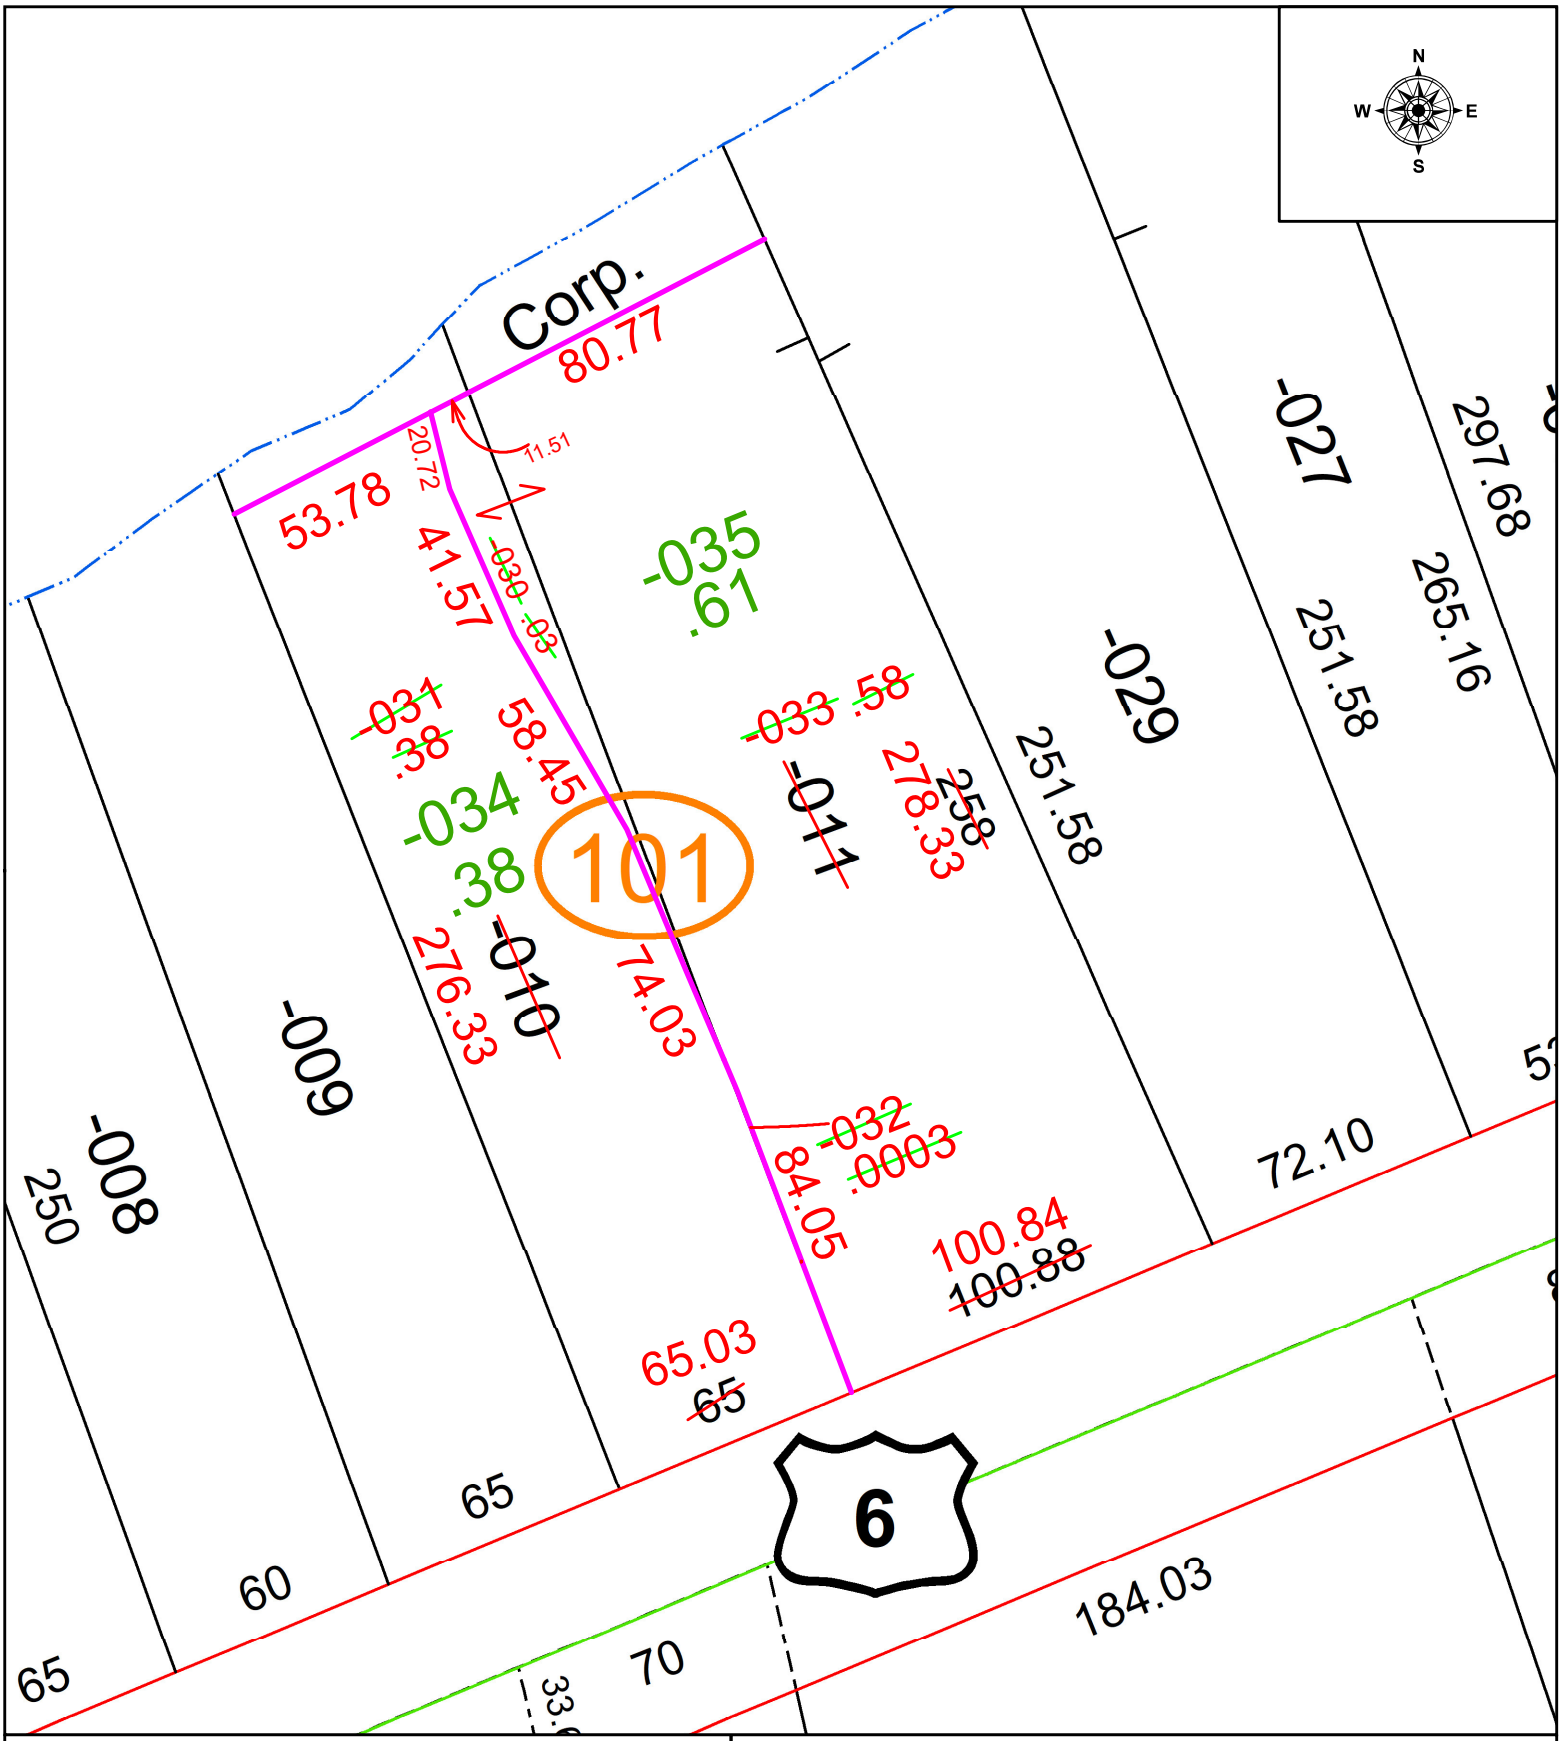

SPLITS/DEEDS PROCESSED

LORAIN COUNTY TAX MAP DEPARTMENT
226 MIDDLE AVE. ELYRIA, OH

SURVEYED BY: AMY KELLY SURVEY # 50630

CLOSURE: 1: 59962

MAP PAGE(S): 03-00-047

APPOVED BY: WRZ **DATE:** 7/8/2022

SCALE: 1" = 50 **PRIOR INSTRUMENT:** 2005-0086517