PARENT PARCEL: 05-00-097-101-007, -027
CHILD PARCEL: 05-00-097-101-031, -032, -033
STARTING POINT: AC CORR PER SURV BY PATRICK MCGANNON

22-04515

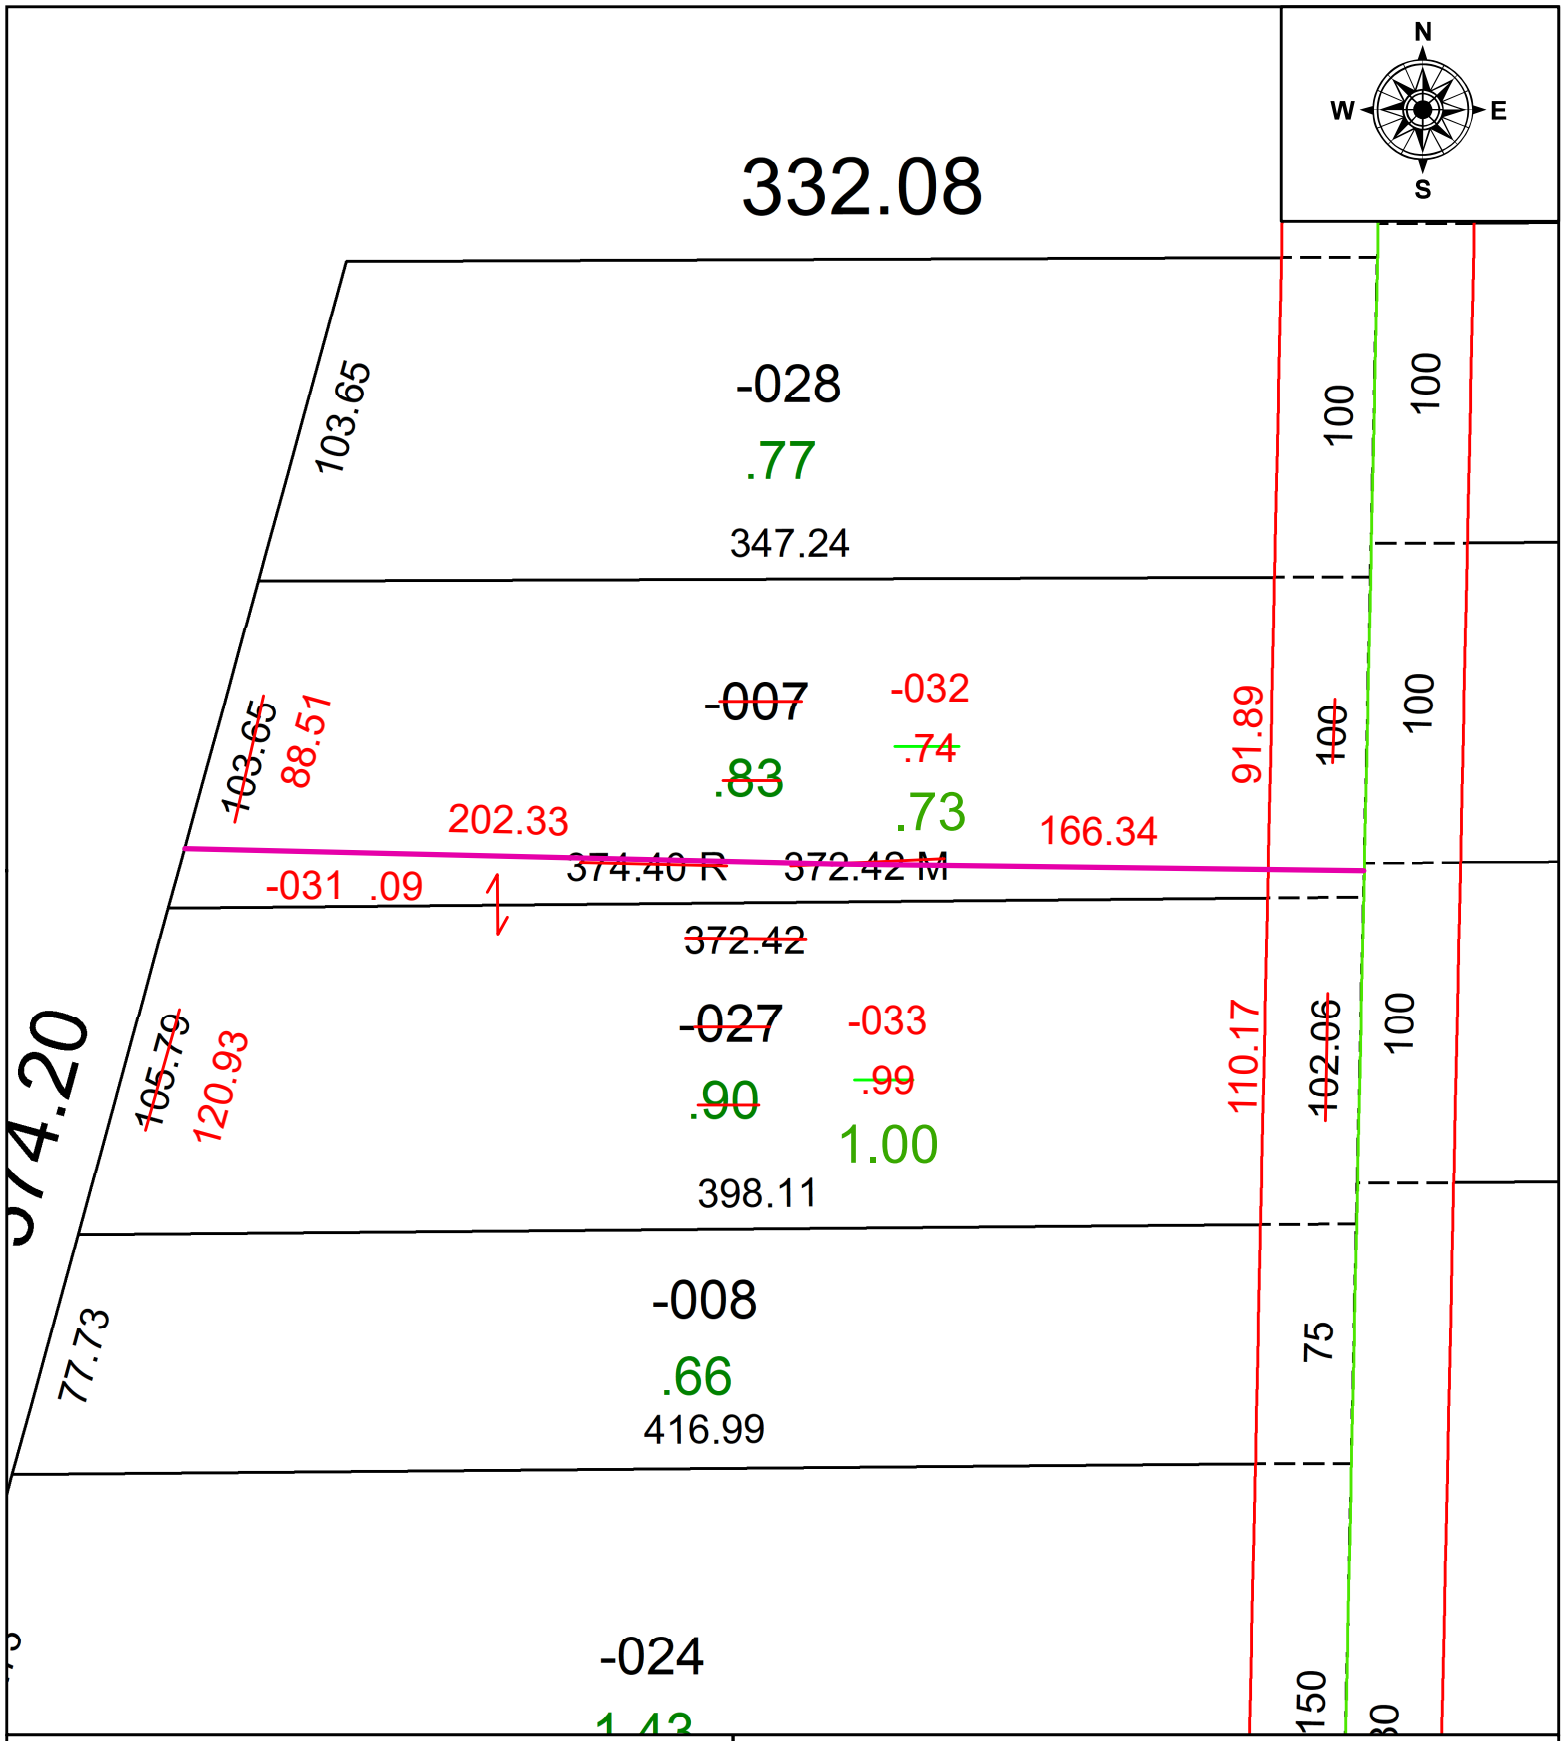

SPLITS/DEEDS PROCESSED
LORAIN COUNTY TAX MAP DEPARTMENT
226 MIDDLE AVE. ELYRIA, OH

SURVEYED BY: PATRICK MCGANNON
CLOSURE: 1: 125662
MAP PAGE(S): 05-00-097-A
APPOVED BY: AC **DATE:** June 29, 2022
SCALE: 1" = 60 **PRIOR INSTRUMENT:** 2008- 0255220