PARENT PARCEL: 04-00-012-102-073, -074
CHILD PARCEL: 04-00-012-102-077
STARTING POINT: C/L OF LONG AND STONEY RIDGE RD

22-04517

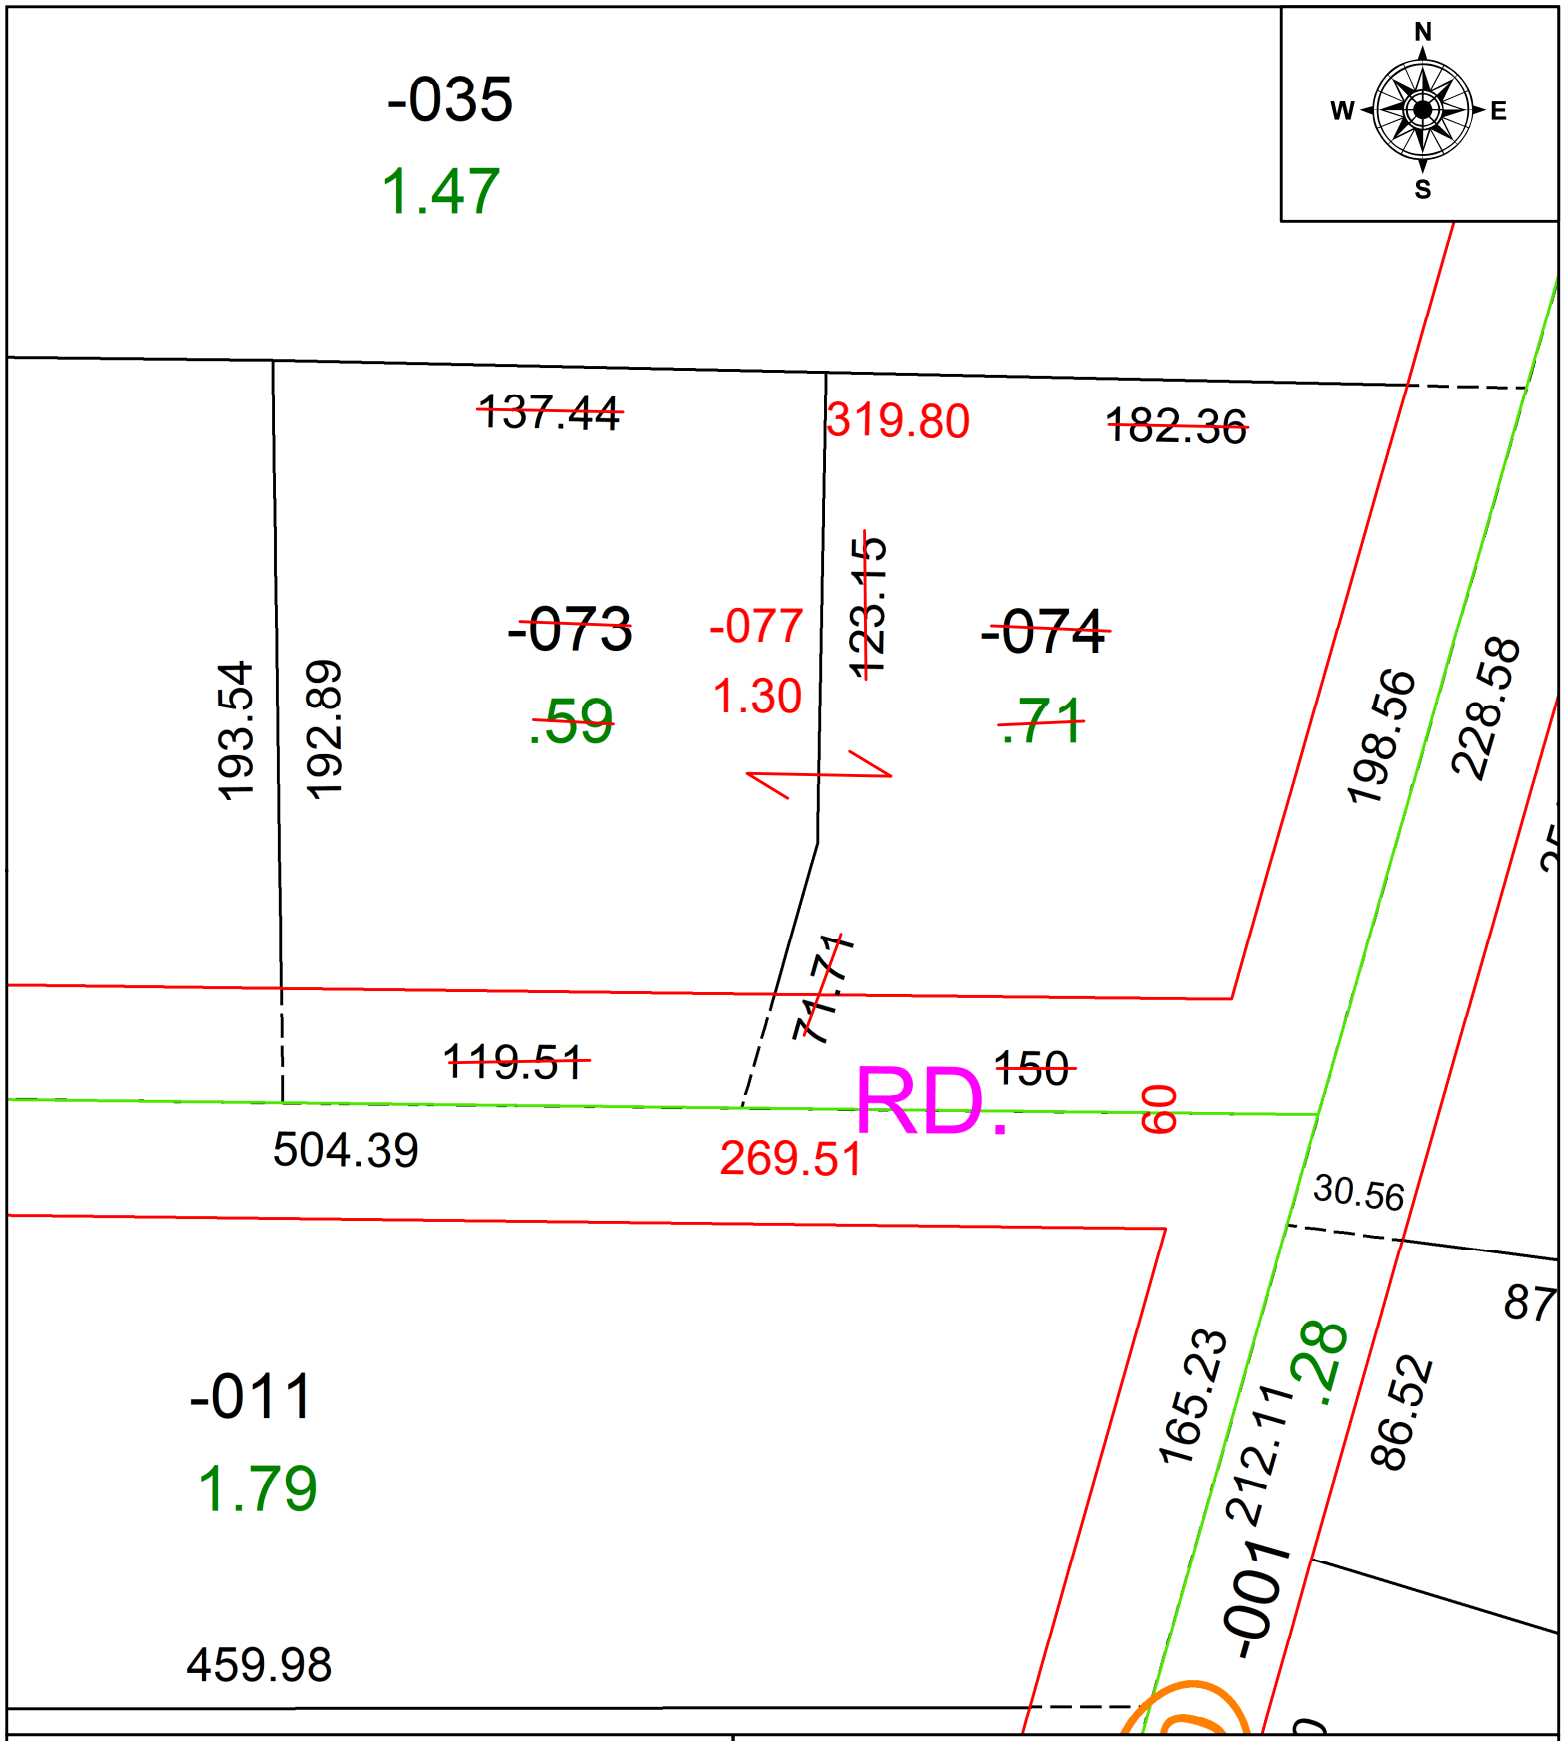

SPLITS/DEEDS PROCESSED
LORAIN COUNTY TAX MAP DEPARTMENT
226 MIDDLE AVE. ELYRIA, OH

SURVEYED BY: AMY M. KELLY
CLOSURE: 1: 535699
MAP PAGE(S): 04-00-012-A
APPOVED BY: AC **DATE:** June 30, 2022
SCALE: 1" = 50 **PRIOR INSTRUMENT:** 2011- 0390828