**PARENT PARCEL:** 09-00-102-000-023

**CHILD PARCEL:**

**STARTING POINT:** INTERSECTION OF C/L OF W. HAMILTON ST. AND C/L OF QUARRY RD.

# 21-04520-D

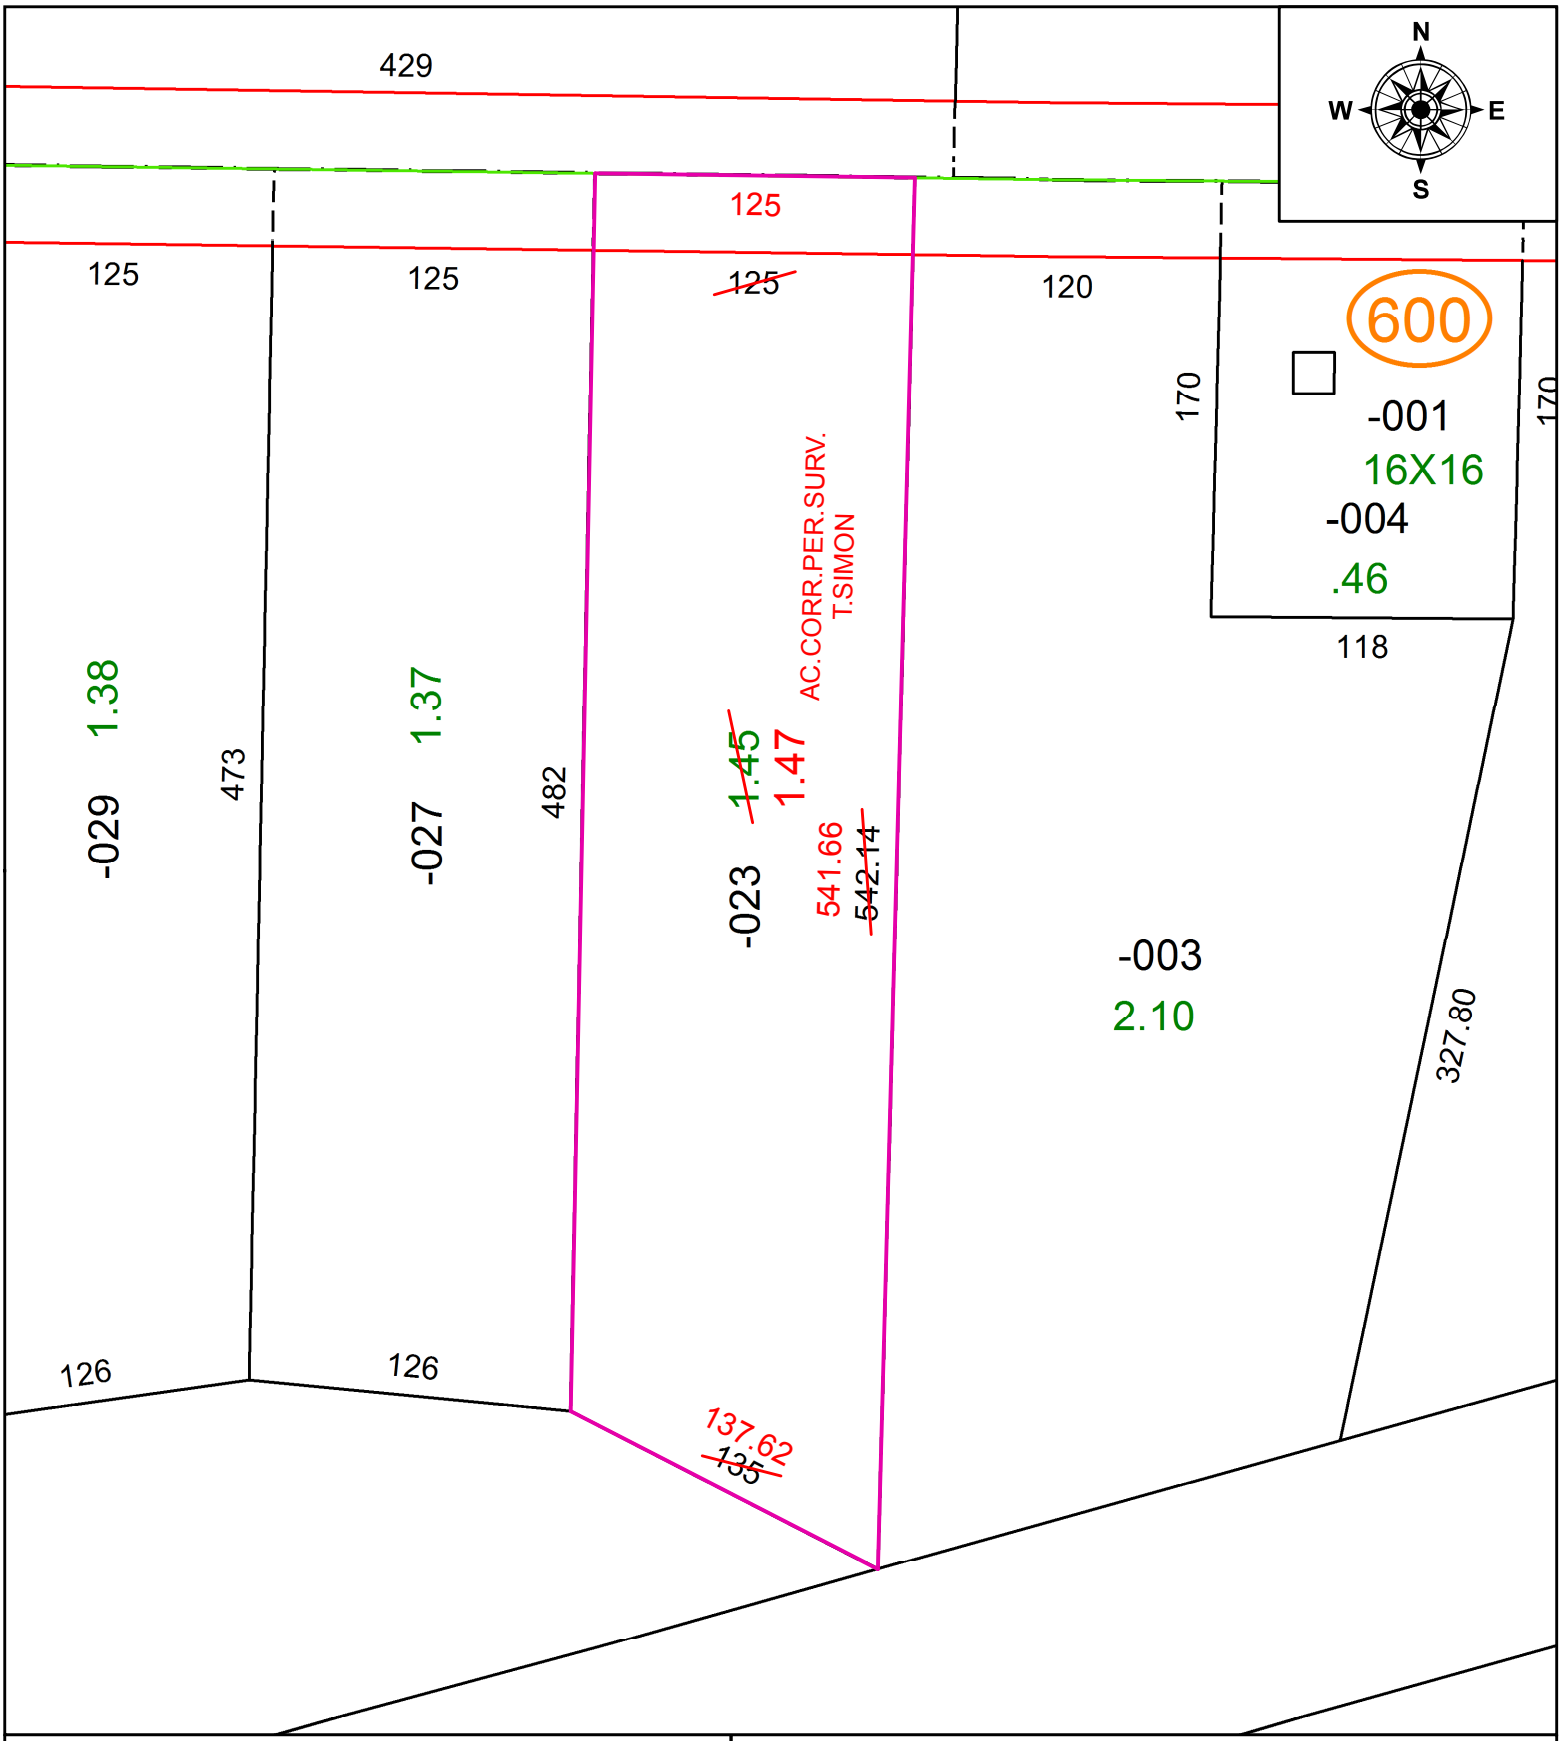


**SPLITS/DEEDS PROCESSED**

LORAIN COUNTY TAX MAP DEPARTMENT
226 MIDDLE AVE. ELYRIA, OH

**SURVEYED BY:** THOMAS A. SIMON
**CLOSURE:** 1: 270,801
**MAP PAGE(S):** 9-00-102
**APPOVED BY:** RRM **DATE:** 4-8-21
**SCALE:** 1" = 75 **PRIOR INSTRUMENT:** 20150553553