PARENT PARCEL: 04-00-028-102-186
CHILD PARCEL: 04-00-028-102-188 & -189
STARTING POINT: C/L OF JUST IMAGINE DR AND NAGEL RD

22-04524

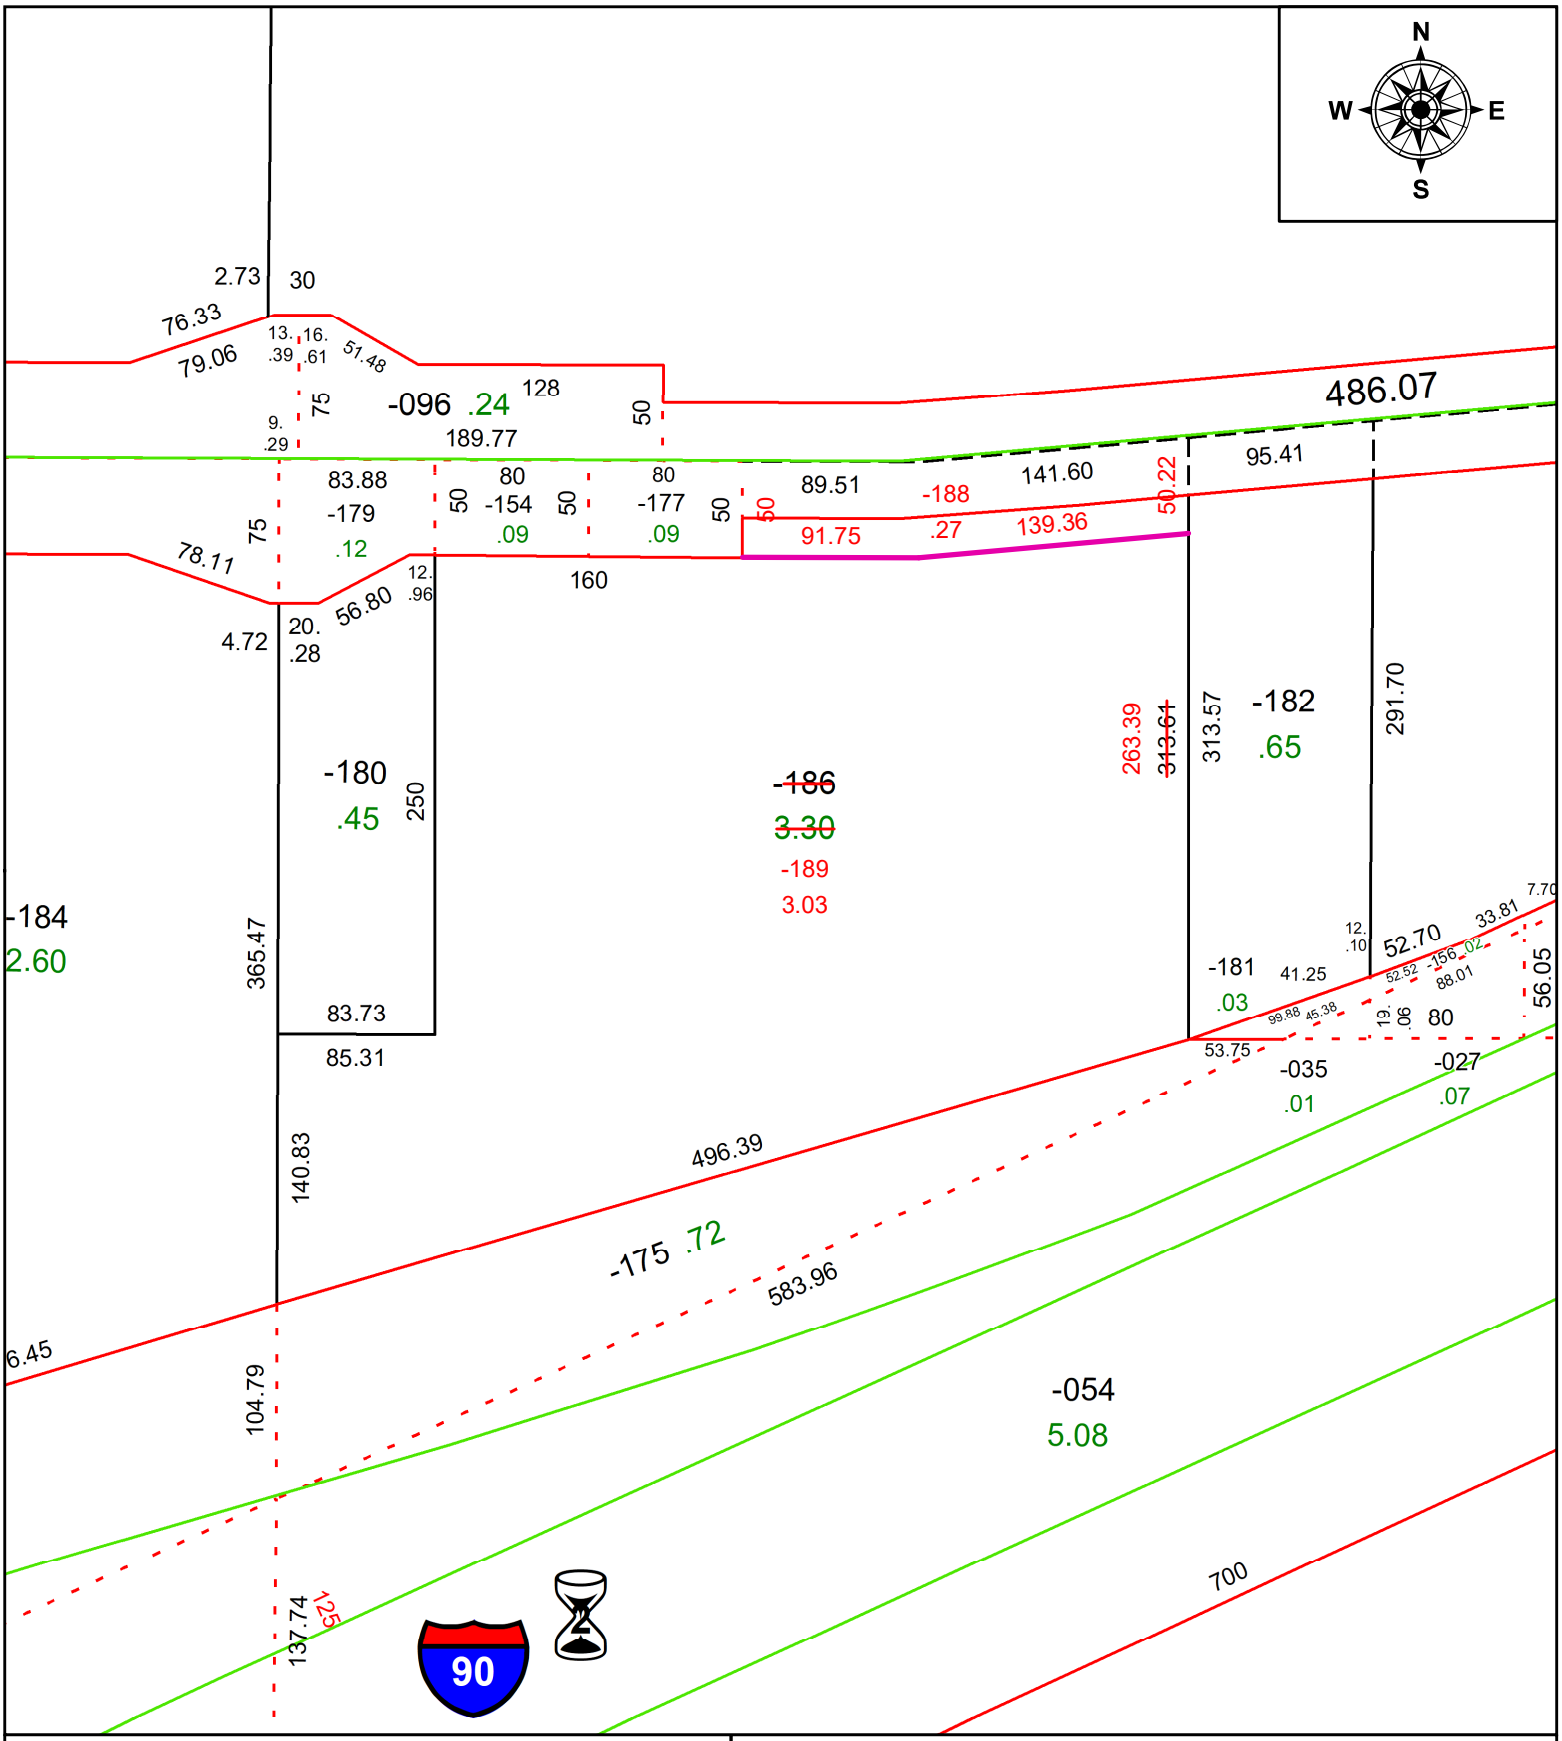

SPLITS/DEEDS PROCESSED

LORAIN COUNTY TAX MAP DEPARTMENT
226 MIDDLE AVE. ELYRIA, OH

SURVEYED BY: GUY P. HANEY
CLOSURE: 1: 52609
MAP PAGE(S): 04-00-028
APPOVED BY: AC **DATE:** July 13, 2022
SCALE: 1" = 100 **PRIOR INSTRUMENT:** 2019- 0709115