PARENT PARCEL: 18-00-028-114-001, -008
CHILD PARCEL: 18-00-028-114-009
STARTING POINT: SOUTHEAST CORNER OF LAND CONVEYED TO T.R. GRAHAM (2000-0668880)

21-04525-C

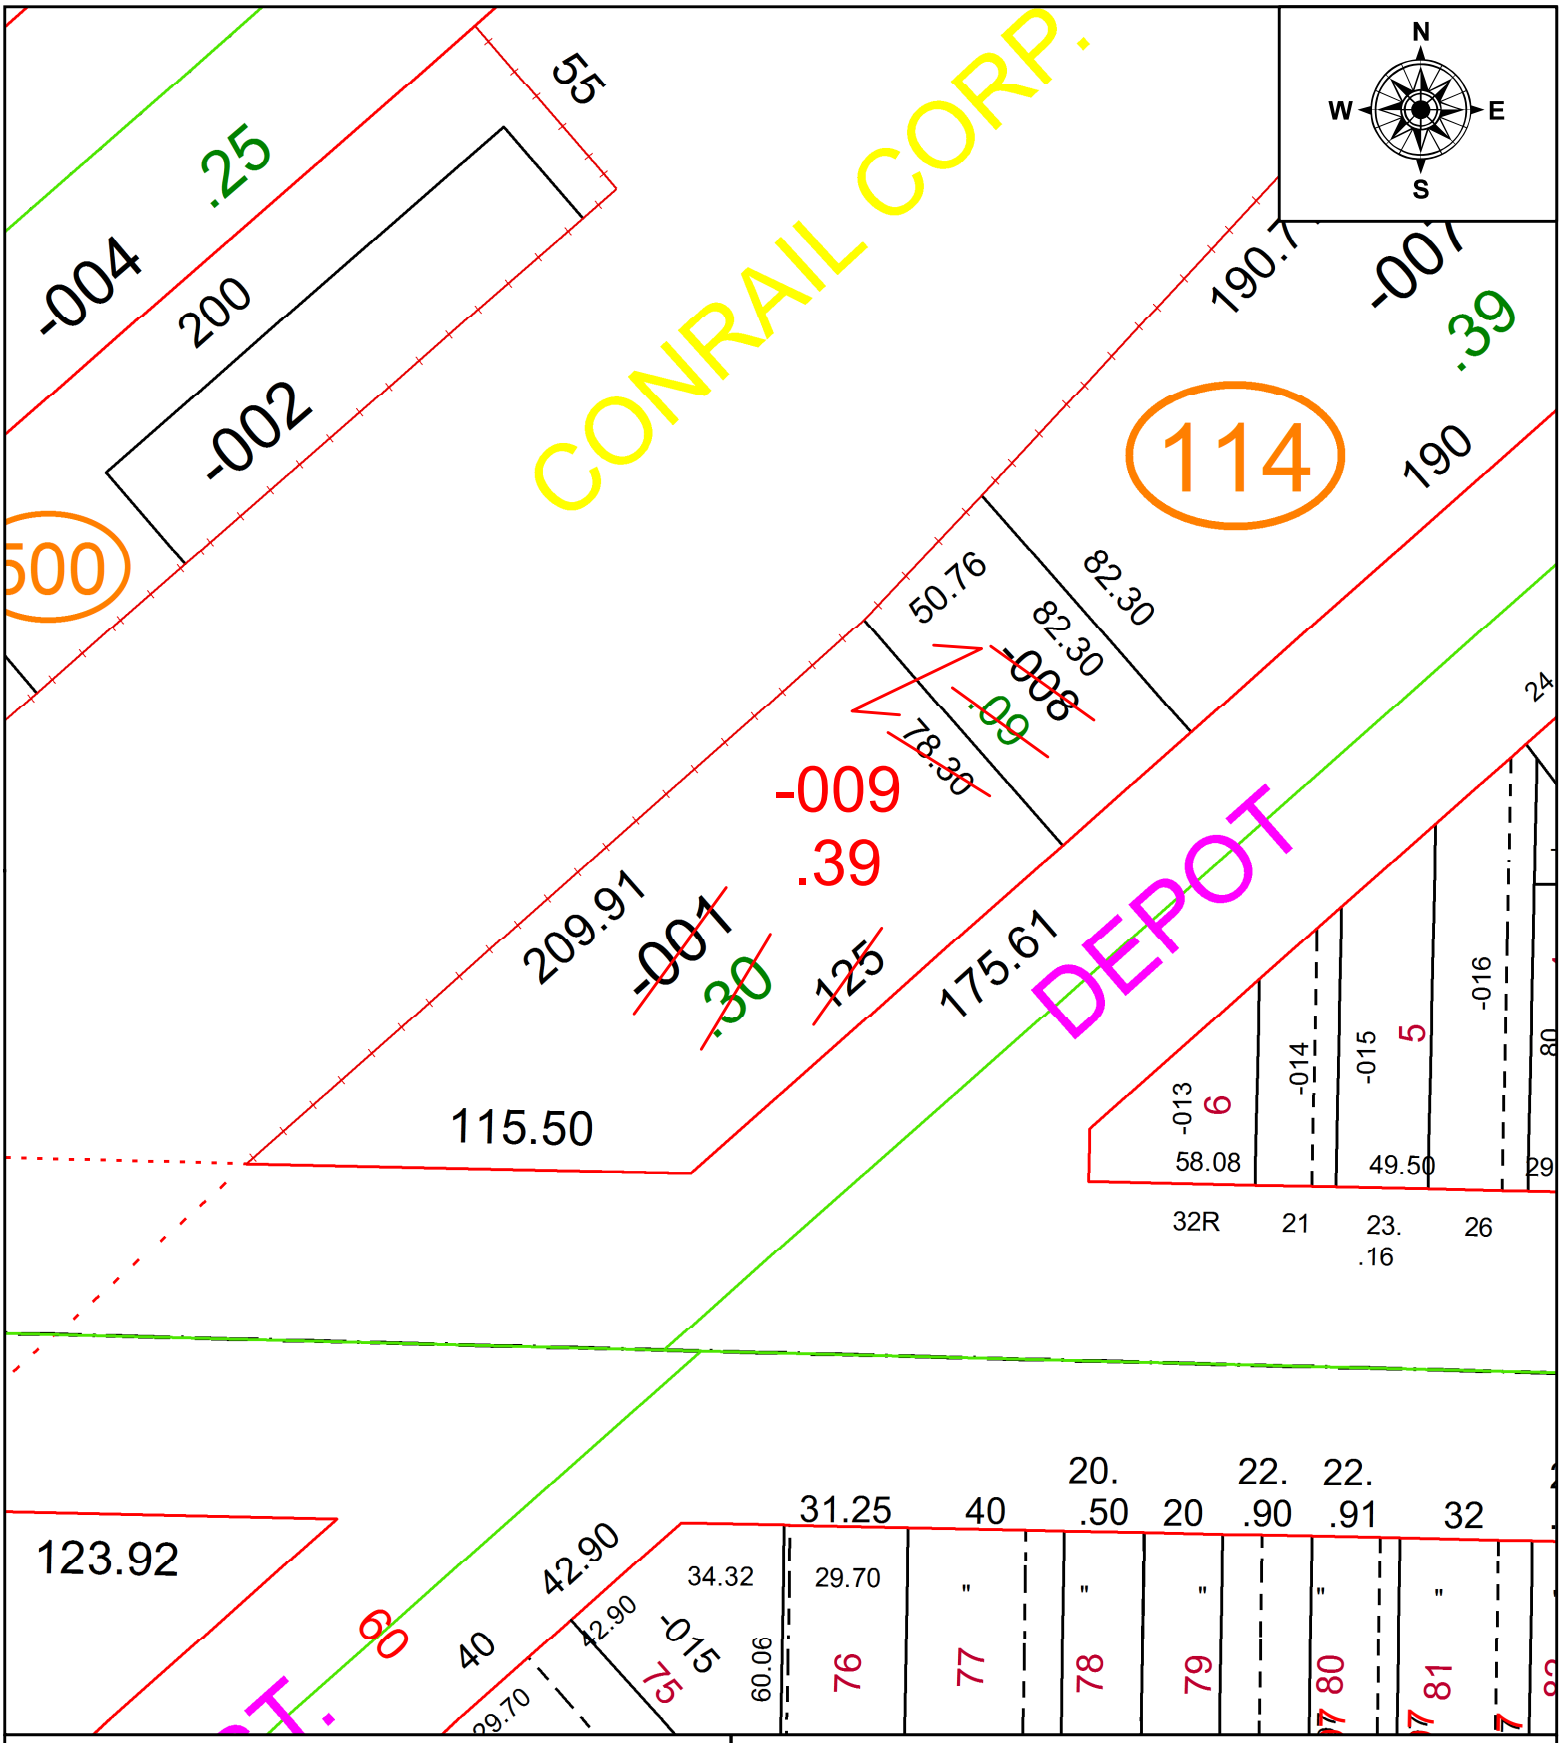

SPLITS/DEEDS PROCESSED
LORAIN COUNTY TAX MAP DEPARTMENT
226 MIDDLE AVE. ELYRIA, OH

SURVEYED BY: ALEX KELSER
CLOSURE: 1: 545,030
MAP PAGE(S): 18-00-028
APPOVED BY: RRM **DATE:** 4-20-21
SCALE: 1" = 50 **PRIOR INSTRUMENT:** 20210800629