PARENT PARCEL: 11-00-025-000-043

CHILD PARCEL: 11-00-025-000-045 THRU -047

STARTING POINT: I.P. MON. BOX, CL OF ELYRIA-TWINSBURG RD. (S.R. 82) & CL OF ISLAND RD.

22-04526

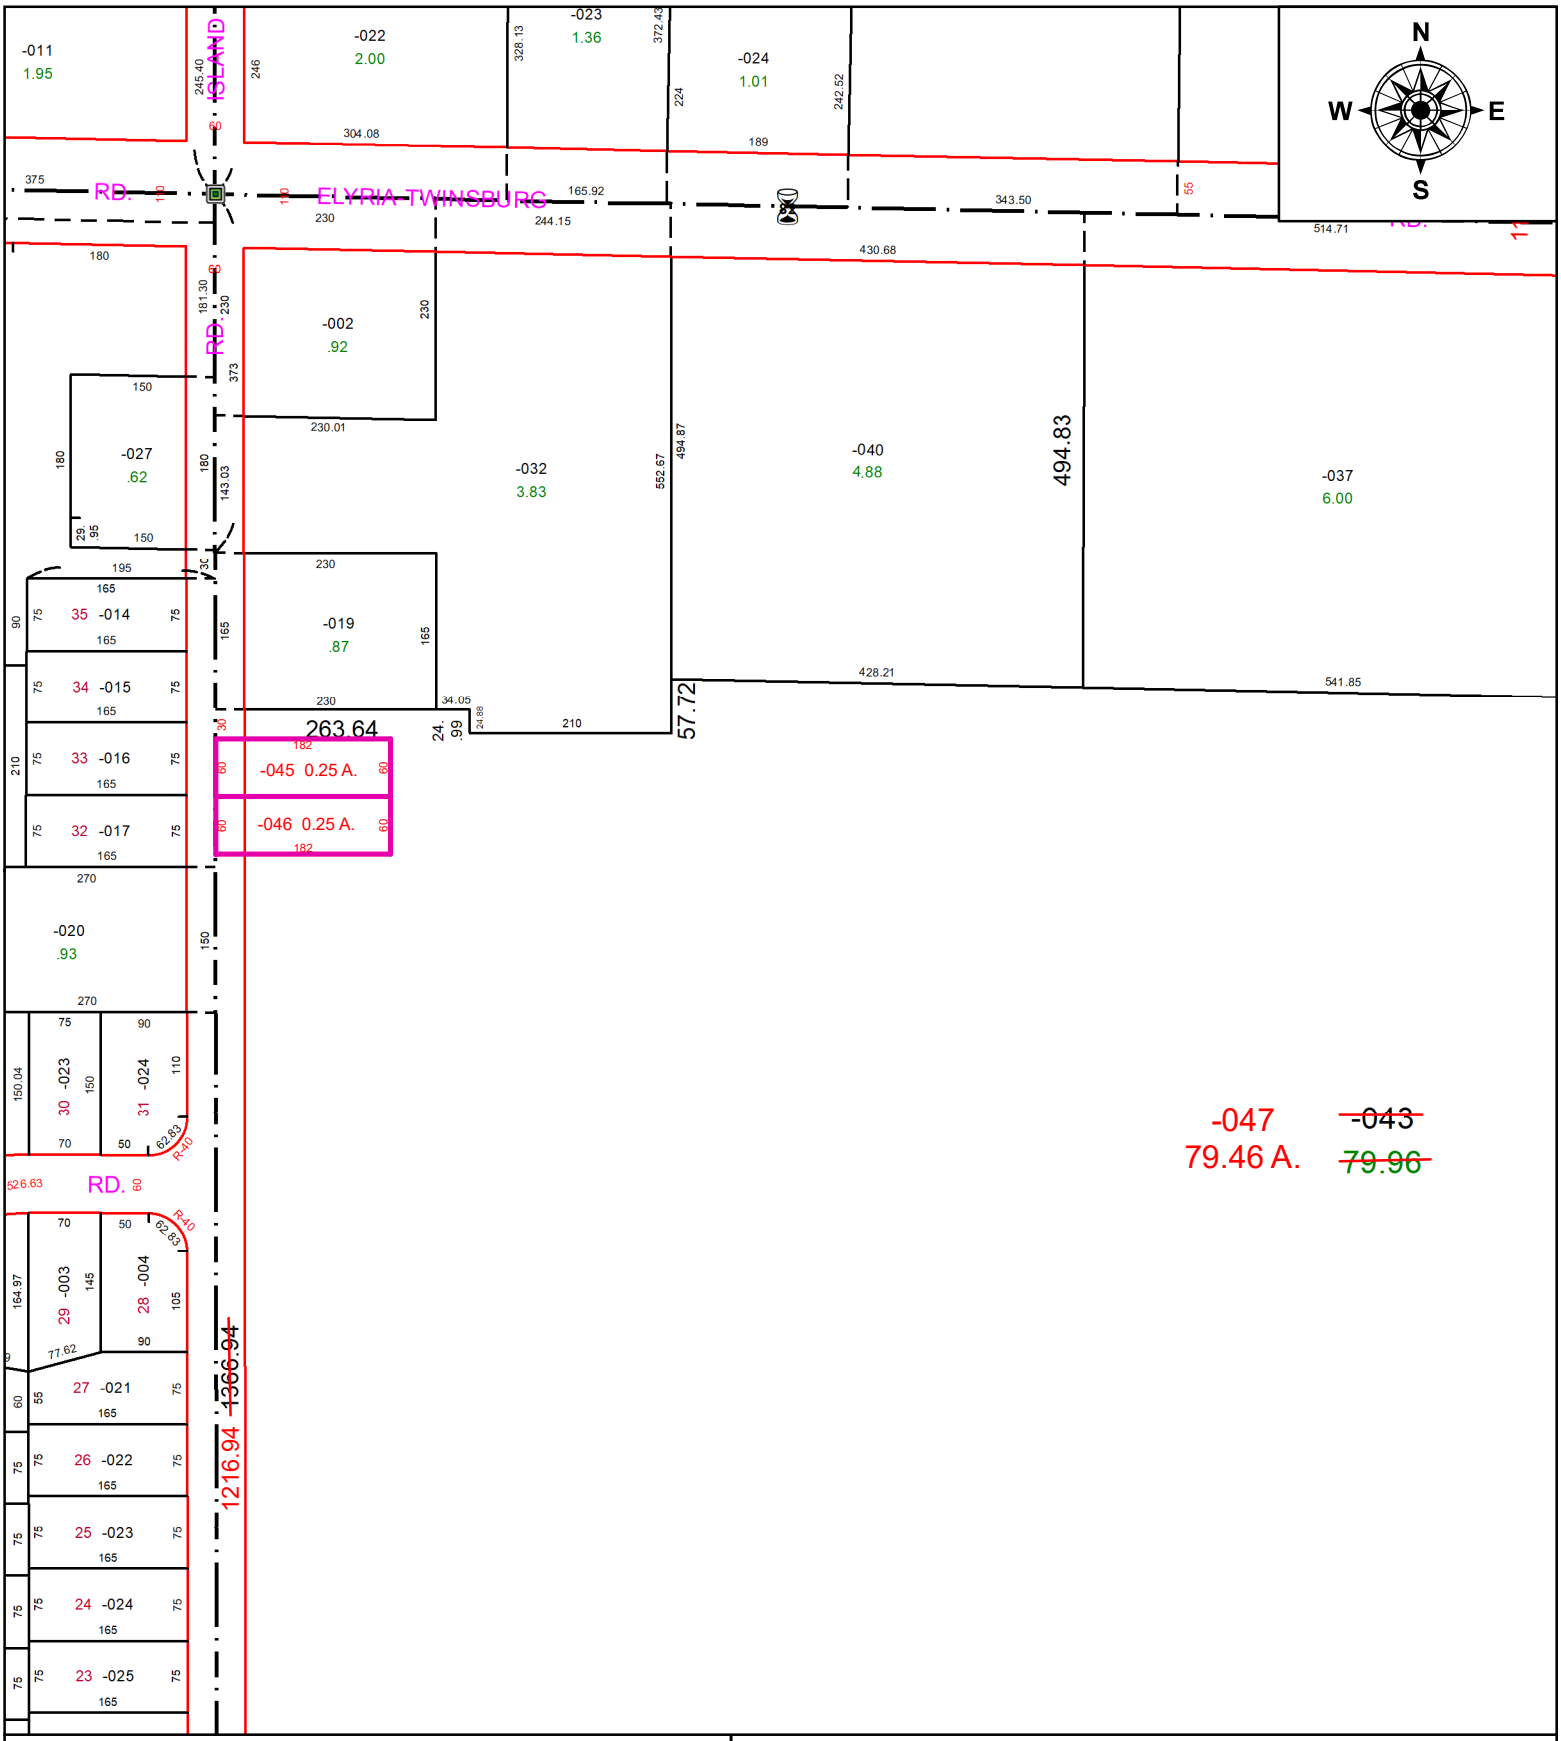

SPLITS/DEEDS PROCESSED

LORAIN COUNTY TAX MAP DEPARTMENT
226 MIDDLE AVE. ELYRIA, OH

SURVEYED BY: ALEX MARKS
CLOSURE: 1: INF
MAP PAGE(S): 11-00-025
APPOVED BY: TJS **DATE:** 7/17/2022
SCALE: 1" = 200 **PRIOR INSTRUMENT:** 2021-094378