PARENT PARCEL: 11-00-092-000-095

CHILD PARCEL: 11-00-092-000-100 & -101 AND 11-00-093-101-083 STR. TRNS.

STARTING POINT: CL OF DURKEE RD. & BUTTERNUT RIDGE RD.

22-04531

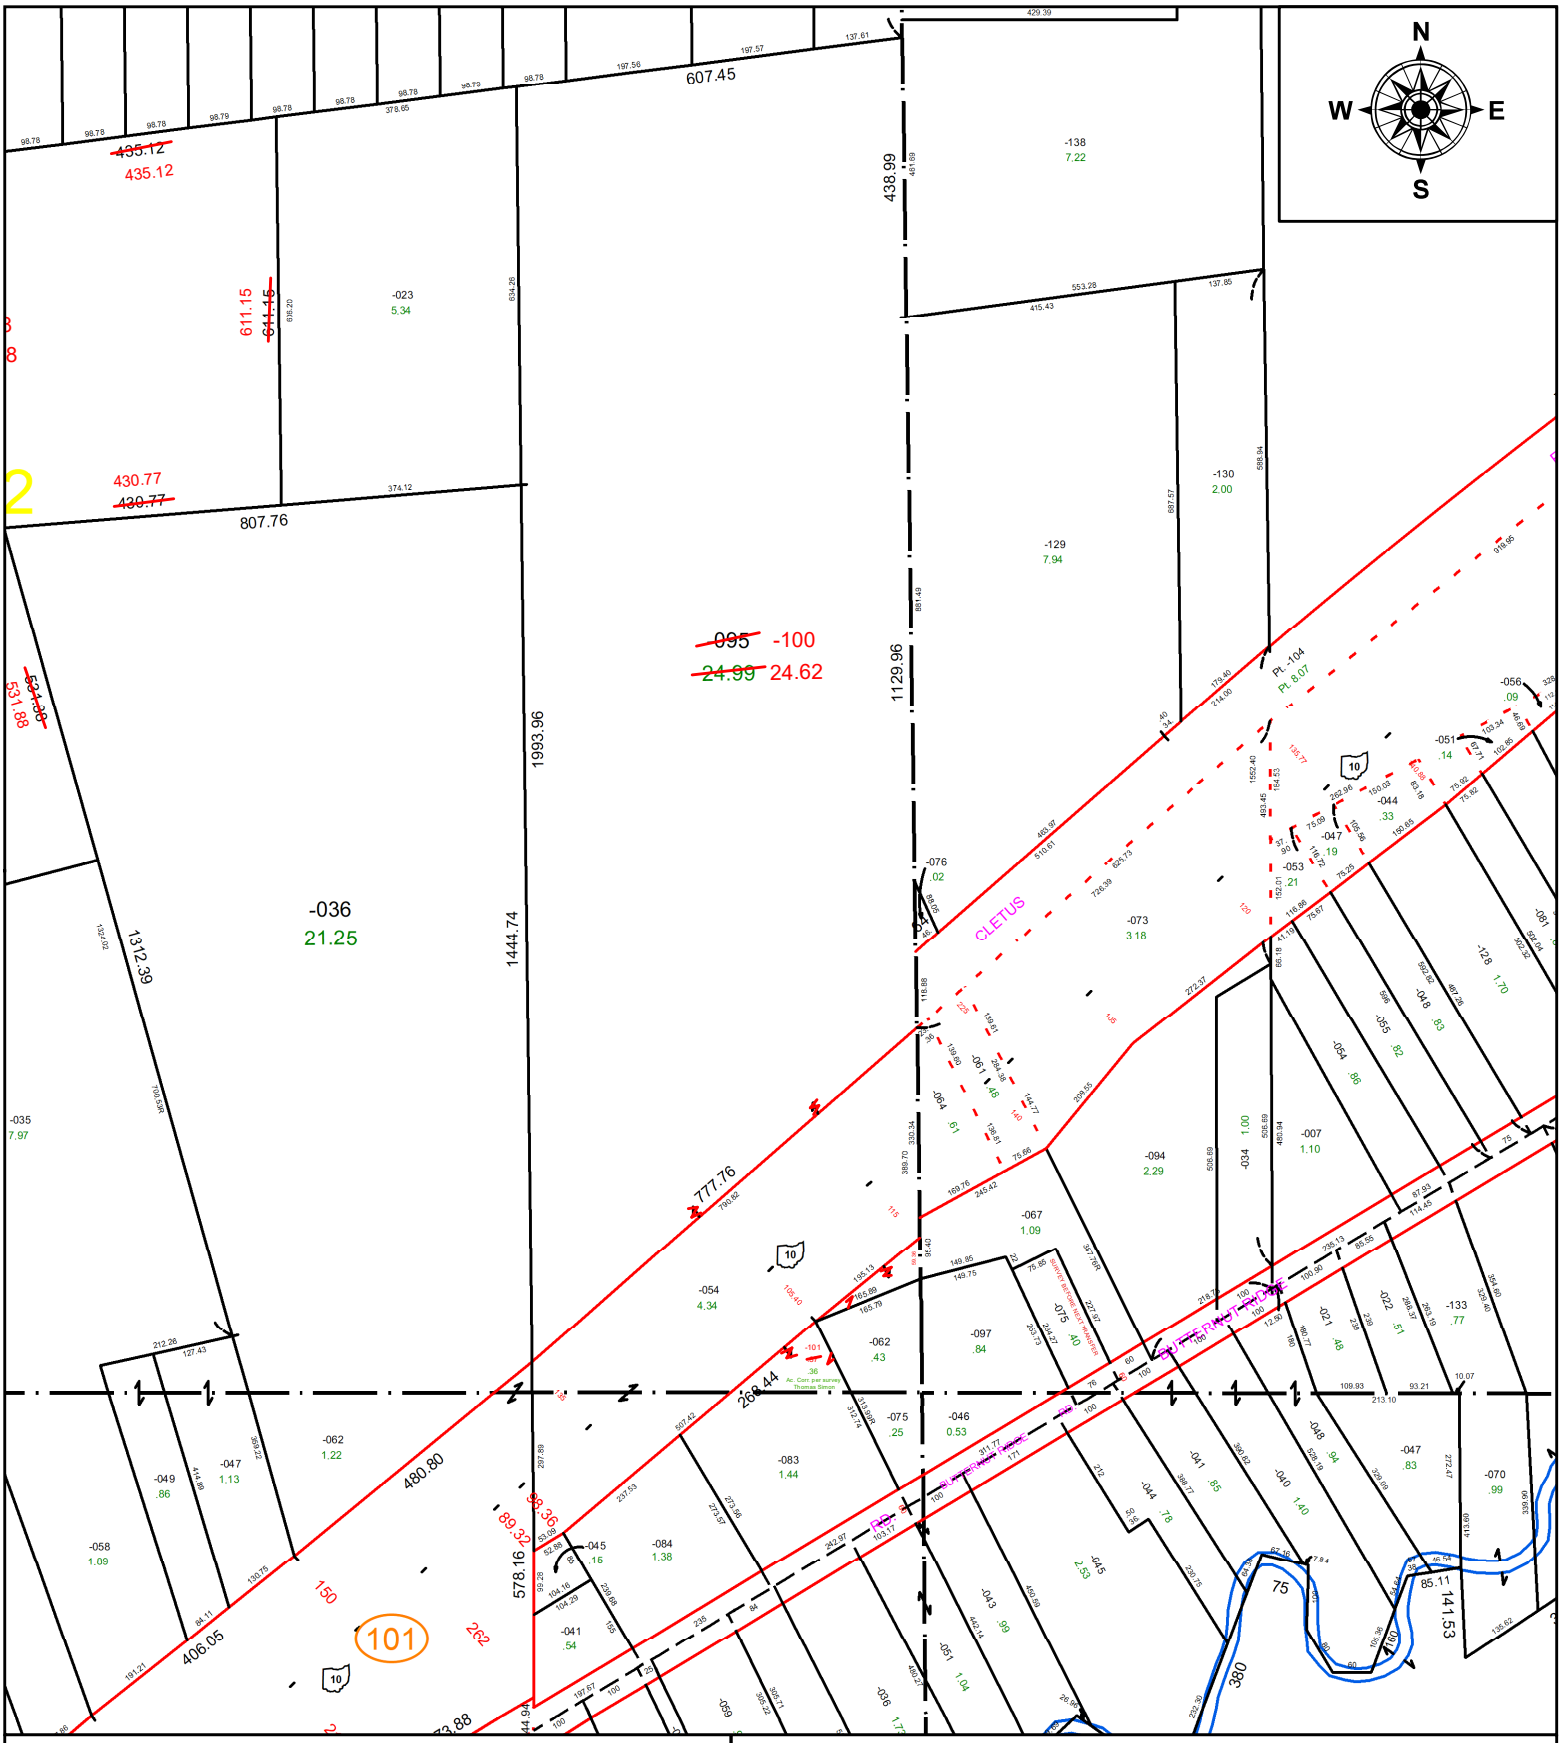

SPLITS/DEEDS PROCESSED

LORAIN COUNTY TAX MAP DEPARTMENT
226 MIDDLE AVE. ELYRIA, OH

SURVEYED BY: THOMAS SIMON **SURVEY #:** 50651

CLOSURE: 1:548476

MAP PAGE(S): 11-00-092

APPOVED BY: DMA **DATE:** 7/27/2022

SCALE: 1" = 300' **PRIOR INSTRUMENT:** 2022-0870067