PARENT PARCEL: 06-25-070-103-002

CHILD PARCEL:

STARTING POINT: INTERSECTION OF C/L OF CLARK ST. AND SUMNER ST.

21-04533-C

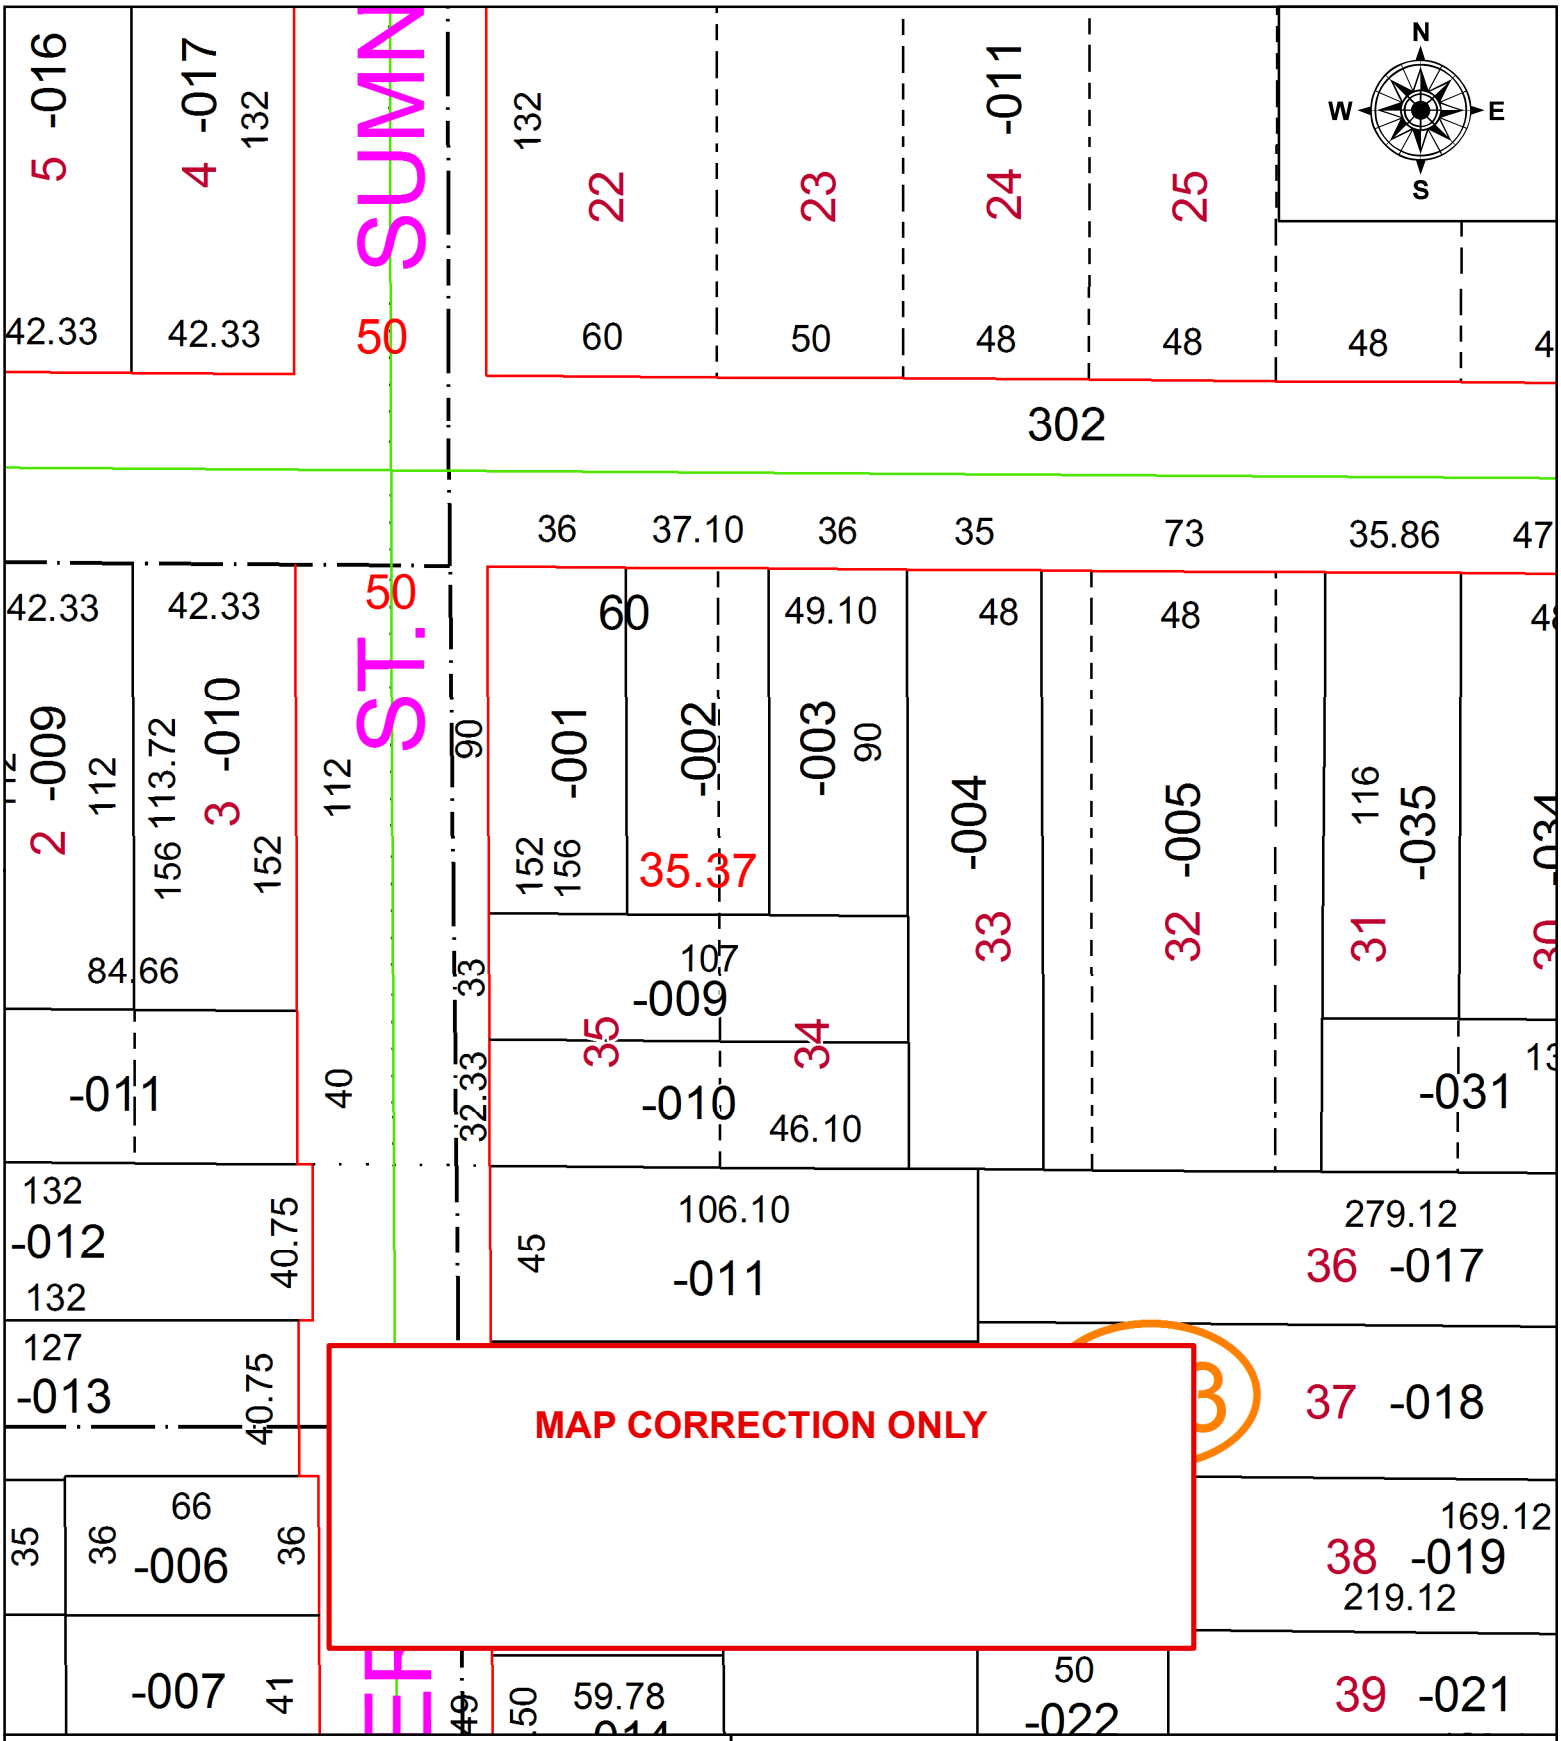

SPLITS/DEEDS PROCESSED

LORAIN COUNTY TAX MAP DEPARTMENT
226 MIDDLE AVE. ELYRIA, OH

SURVEYED BY: SCOTT CASEY
CLOSURE: 1: 72691
MAP PAGE(S): 6-25-070
APPOVED BY: WRZ **DATE:** 4-27-21
SCALE: 1" = 50 **PRIOR INSTRUMENT:** 2015-0566183