**PARENT PARCEL:** 05-00-090-000-012

**CHILD PARCEL:** 05-00-090-000-013 THRU -016

**STARTING POINT:** AC CORR PER SURV BY THOMAS A. SIMON

22-04535

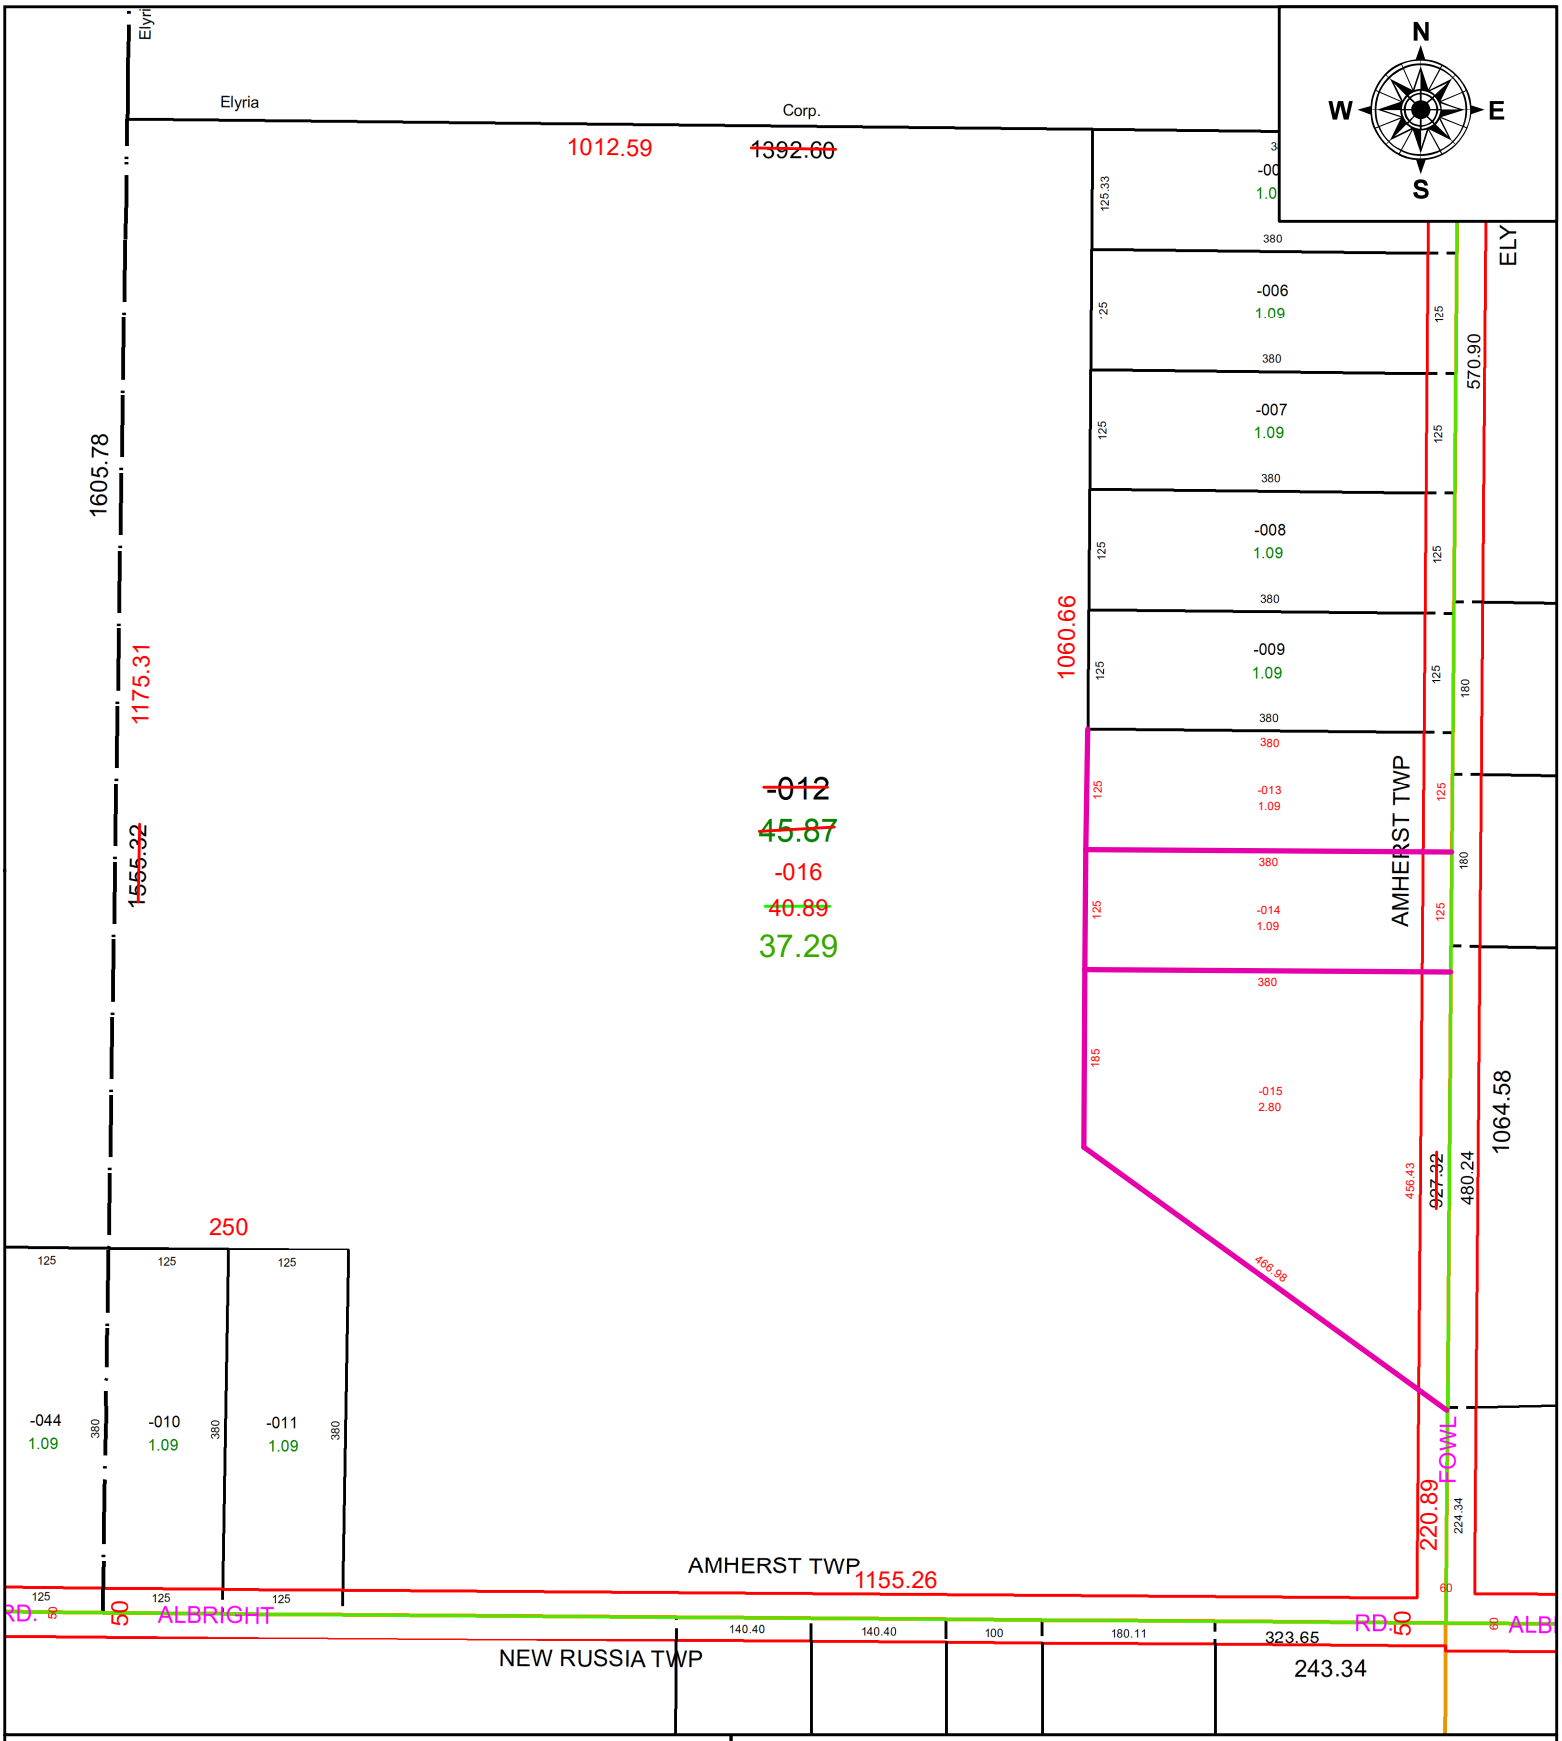


**SPLITS/DEEDS PROCESSED**

LORAIN COUNTY TAX MAP DEPARTMENT
226 MIDDLE AVE. ELYRIA, OH

**SURVEYED BY:** THOMAS A. SIMON
**CLOSURE:** 1: 2147483648
**MAP PAGE(S):** 05-00-090
**APPOVED BY:** AC **DATE:** August 02, 2022
**SCALE:** 1" = 200 **PRIOR INSTRUMENT:** 2020- 0789997