**PARENT PARCEL:** 07-00-017-126-040 & -097
**CHILD PARCEL:** 07-00-017-126-139 COMBIINATION
**STARTING POINT:** N/A

22-04537

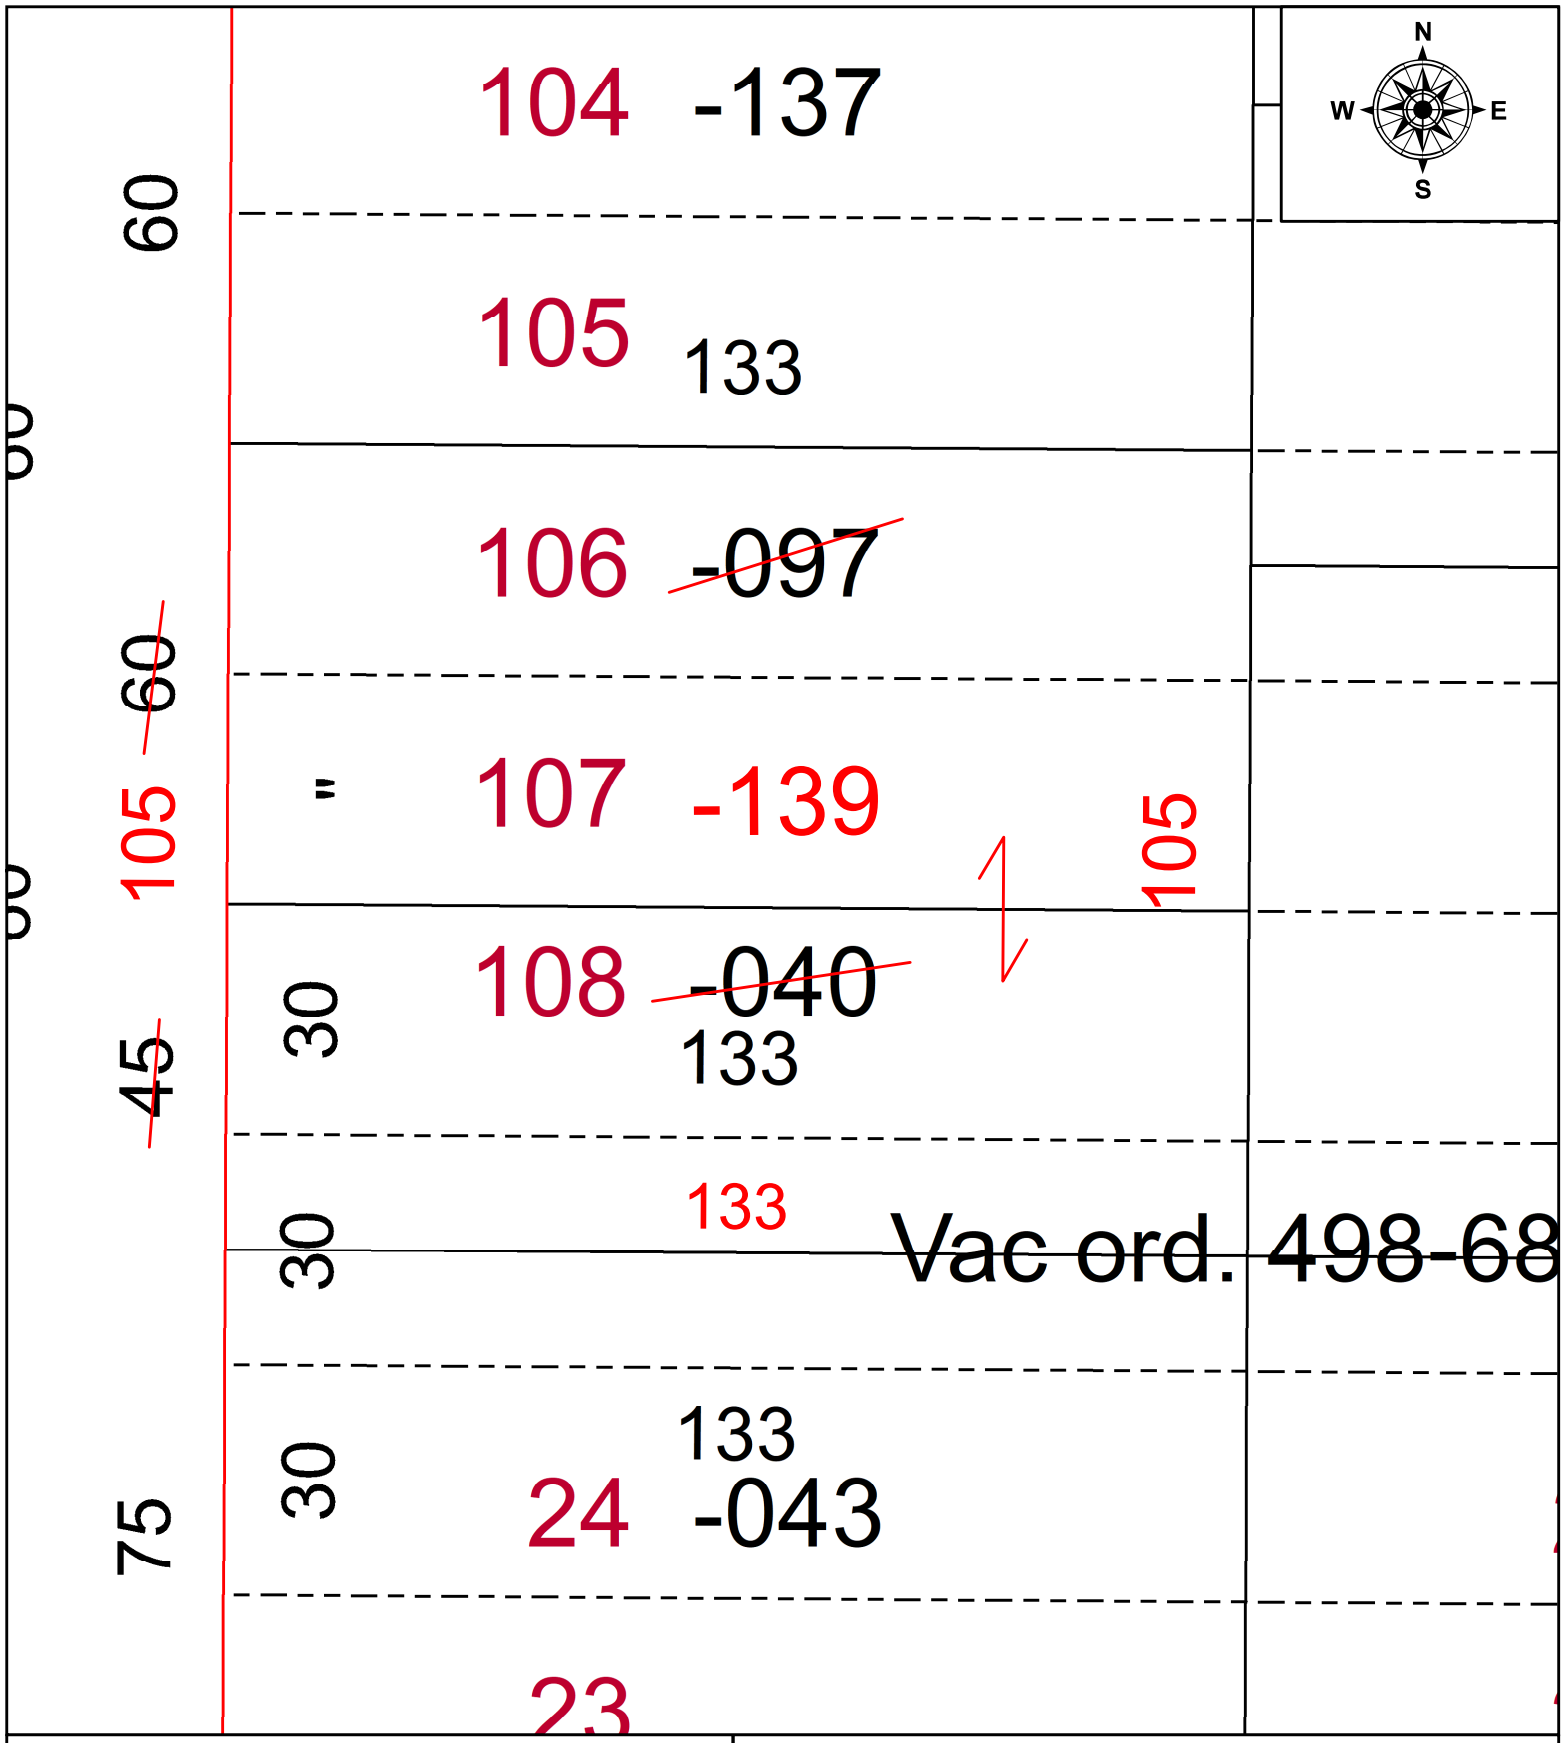


**SPLITS/DEEDS PROCESSED**
LORAIN COUNTY TAX MAP DEPARTMENT
226 MIDDLE AVE. ELYRIA, OH

**SURVEYED BY:** N/A **SURVEY #:** N/A
**CLOSURE:** N/A
**MAP PAGE(S):** 07-00-017
**APPOVED BY:** DMA **DATE:** 08/04/2022
**SCALE:** 1" = 25' **PRIOR INSTRUMENT:** 2019-0728224