PARENT PARCEL: 18-00-025-000-013

CHILD PARCEL: 18-00-025-000-014 & -015

STARTING POINT: C/L OF JONES RD AND SR 58 **AC CORR PER SURV BY JAMES D. WELLERT**

22-04538

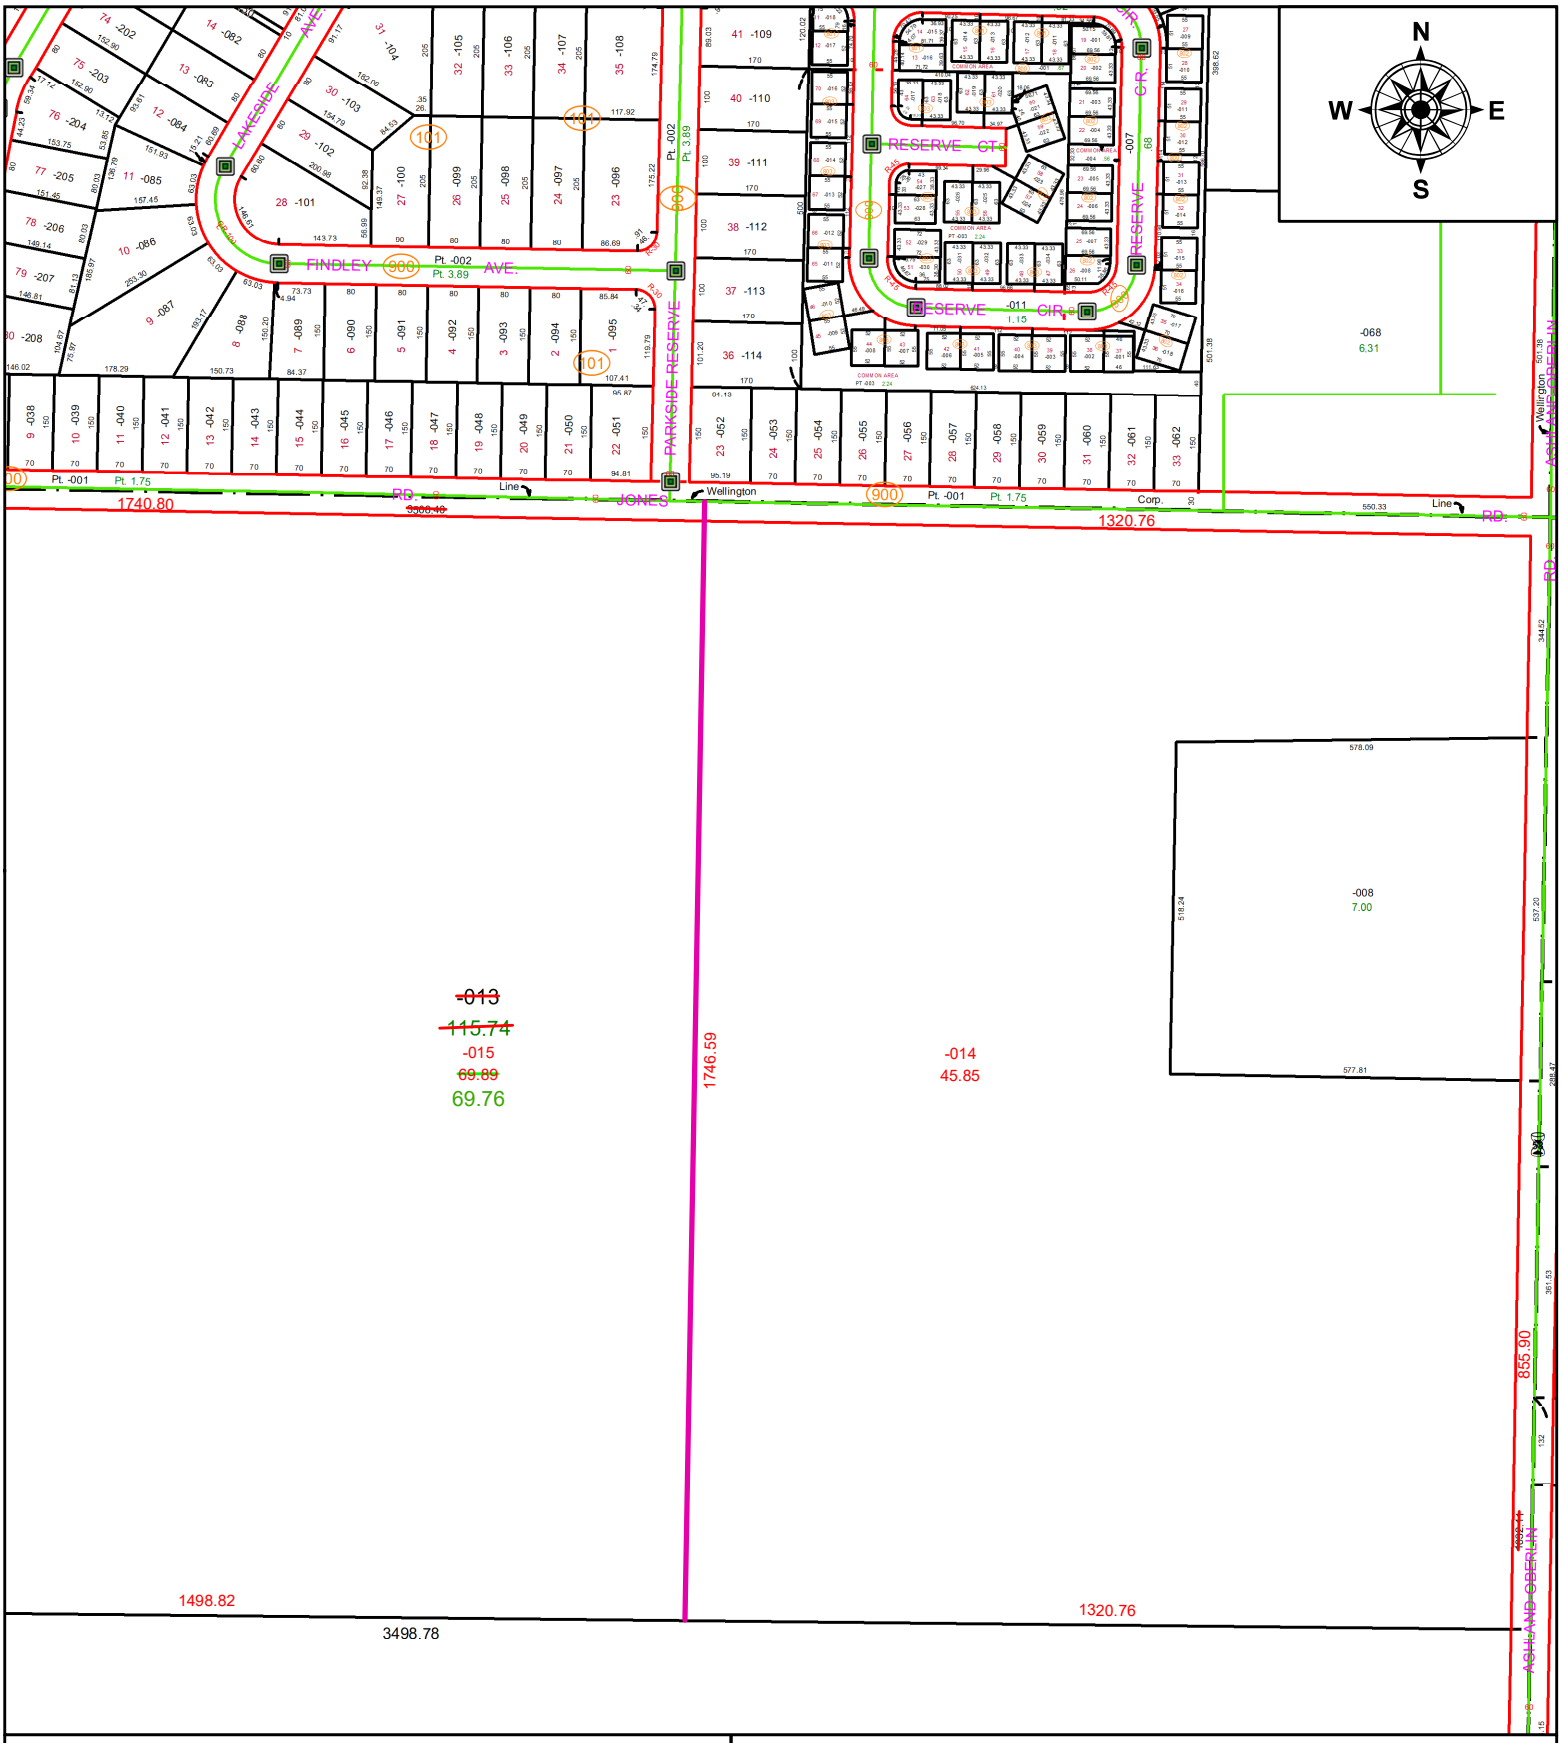

SPLITS/DEEDS PROCESSED

LORAIN COUNTY TAX MAP DEPARTMENT
226 MIDDLE AVE. ELYRIA, OH

SURVEYED BY: JAMES D. WELLERT
CLOSURE: 1: 2837462
MAP PAGE(S): 15-00-057-A
APPOVED BY: AC **DATE:** August 09, 2022
SCALE: 1" = 300 **PRIOR INSTRUMENT:** 1994- 51800004