PARENT PARCEL: 10-00-015-108-021
CHILD PARCEL:
STARTING POINT: INTERSECTION OF C/L OF EDGEWOOD AND LAKEVIEW DRIVE

21-04541-D

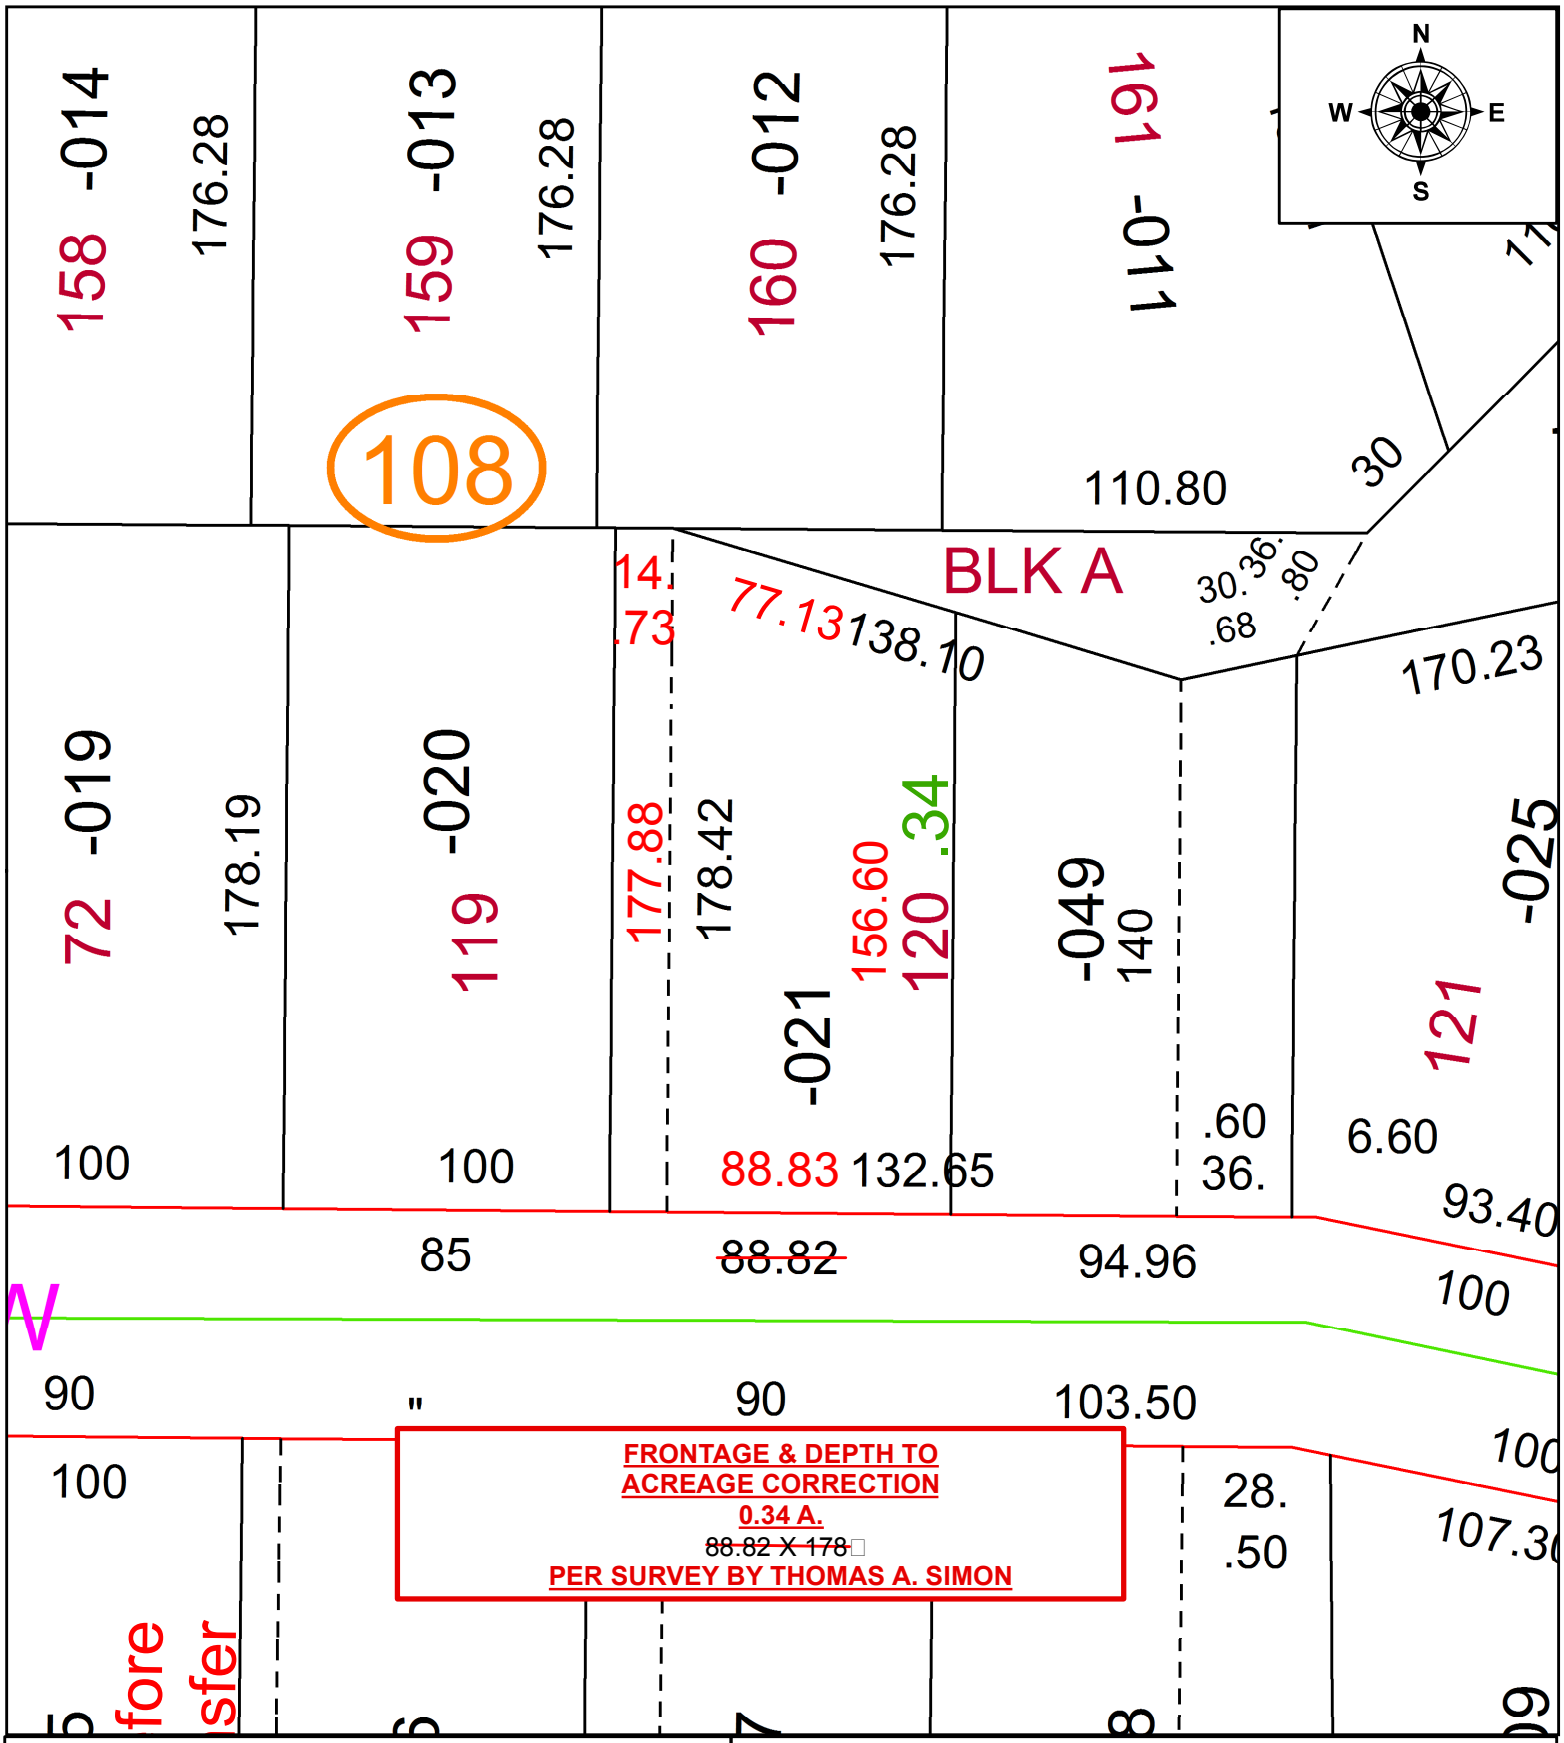

SPLITS/DEEDS PROCESSED
LORAIN COUNTY TAX MAP DEPARTMENT
226 MIDDLE AVE. ELYRIA, OH

SURVEYED BY: THOMAS A. SIMON
CLOSURE: 1: 76766
MAP PAGE(S): 10-00-005
APPOVED BY: AC **DATE:** 5/5/21
SCALE: 1" = 50 **PRIOR INSTRUMENT:** 2016-0597305