PARENT PARCEL: 01-00-027-000-045 & -058
CHILD PARCEL: 01-00-027-000-086
STARTING POINT: CL OF COOPER FOSTER PARK RD. & BAUMHART RD.

22-04541

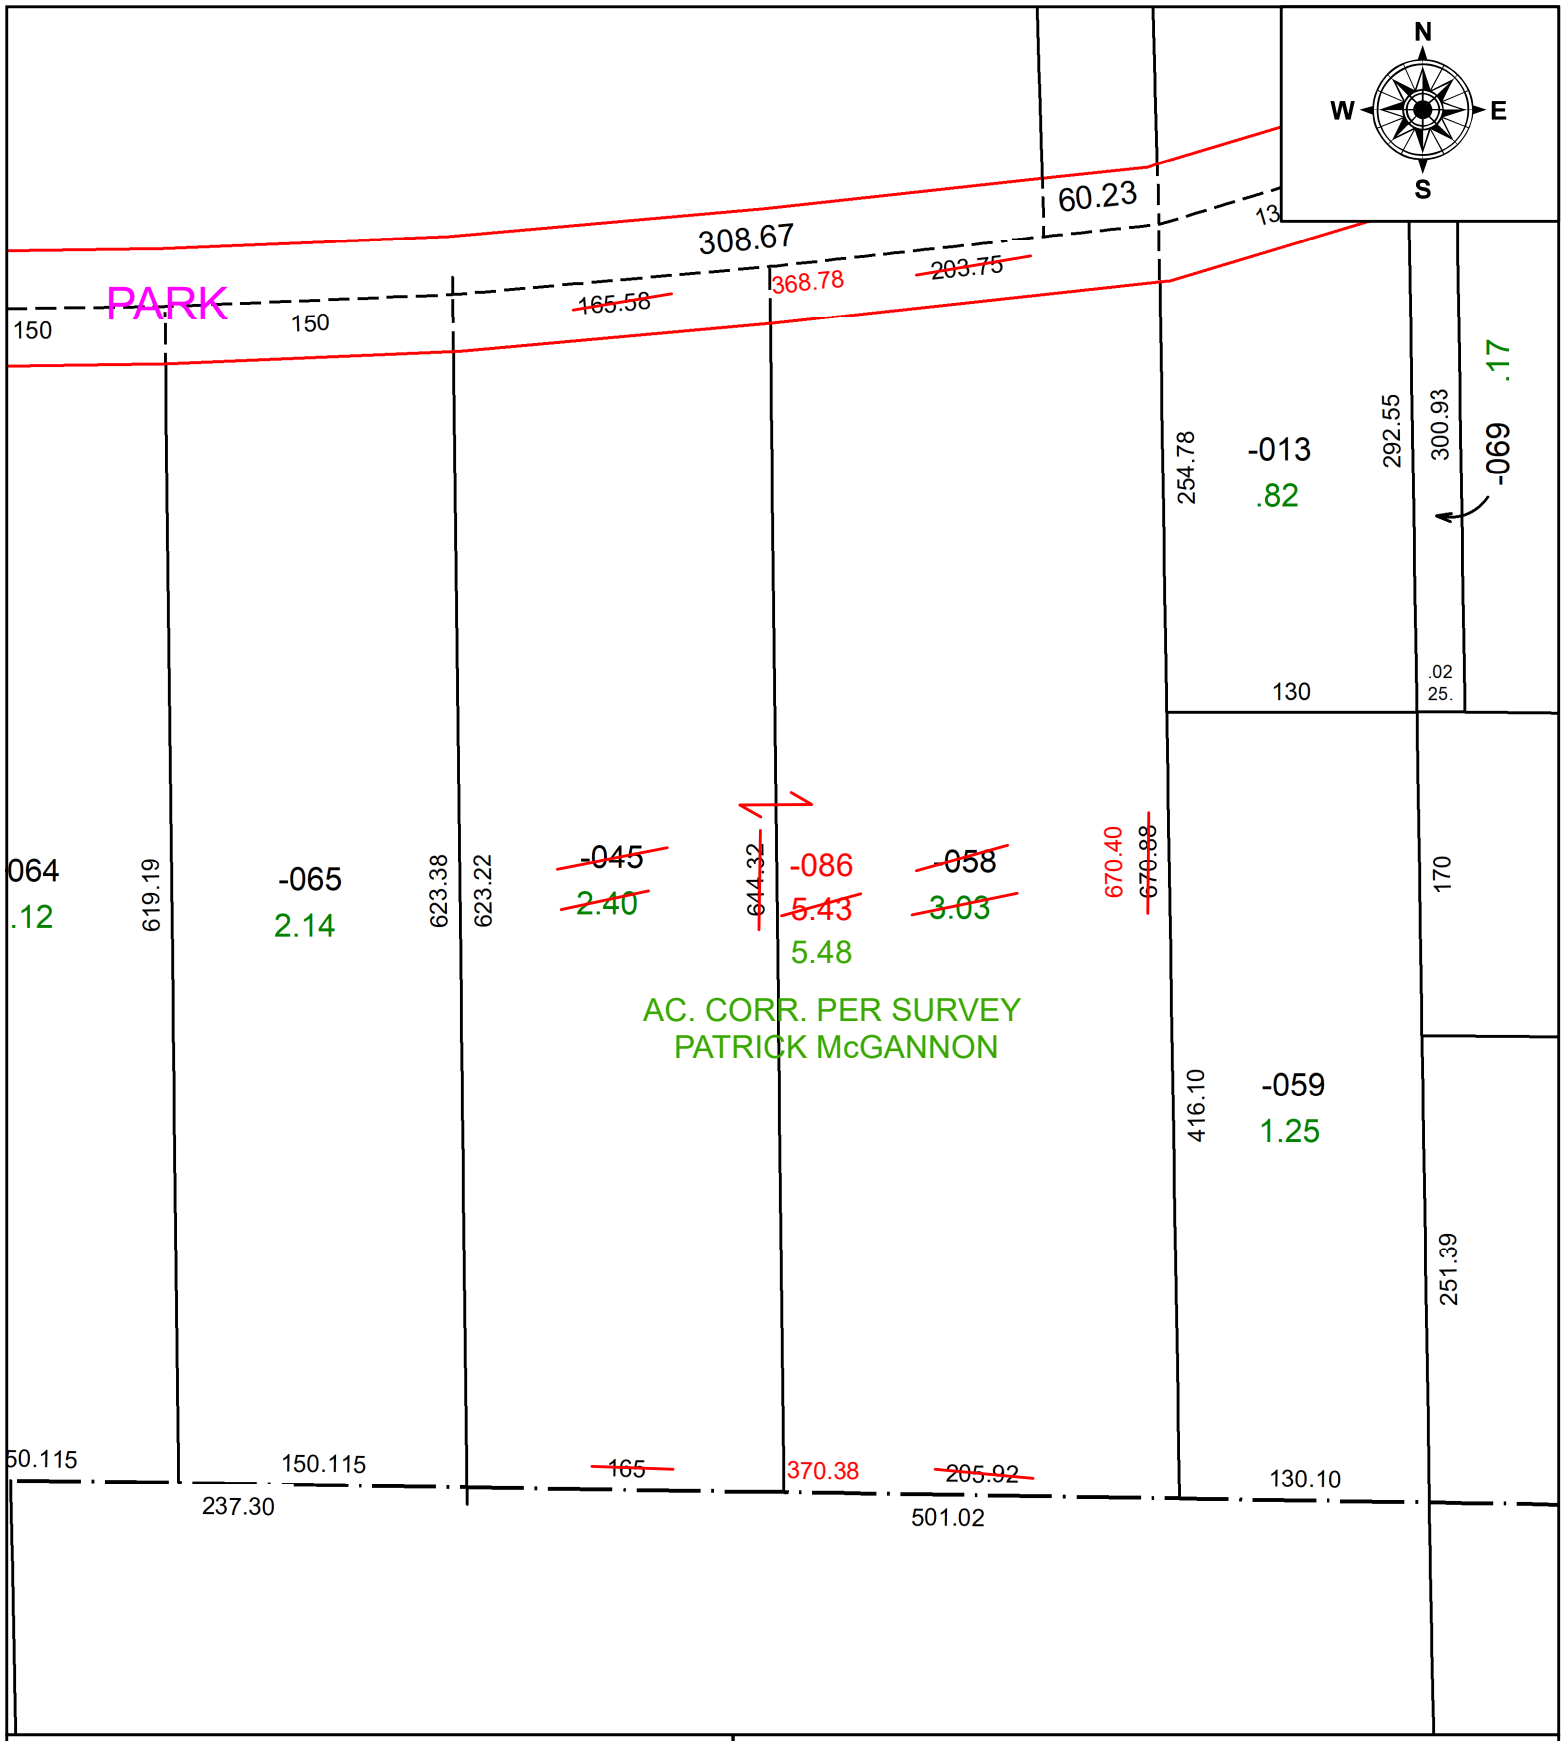

SPLITS/DEEDS PROCESSED
LORAIN COUNTY TAX MAP DEPARTMENT
226 MIDDLE AVE. ELYRIA, OH

SURVEYED BY: PATRICK MCGANNON **SURVEY #:** 50673
CLOSURE: 1:277281
MAP PAGE(S): 01-00-027
APPOVED BY: DMA **DATE:** 8/18/2022
SCALE: 1" = 100' **PRIOR INSTRUMENT:** 2013-0481192