PARENT PARCEL: 06-23-019-000-035
CHILD PARCEL:
STARTING POINT: SOUTHEAST CORNER OF SUBLOT # 13

21-04542-D

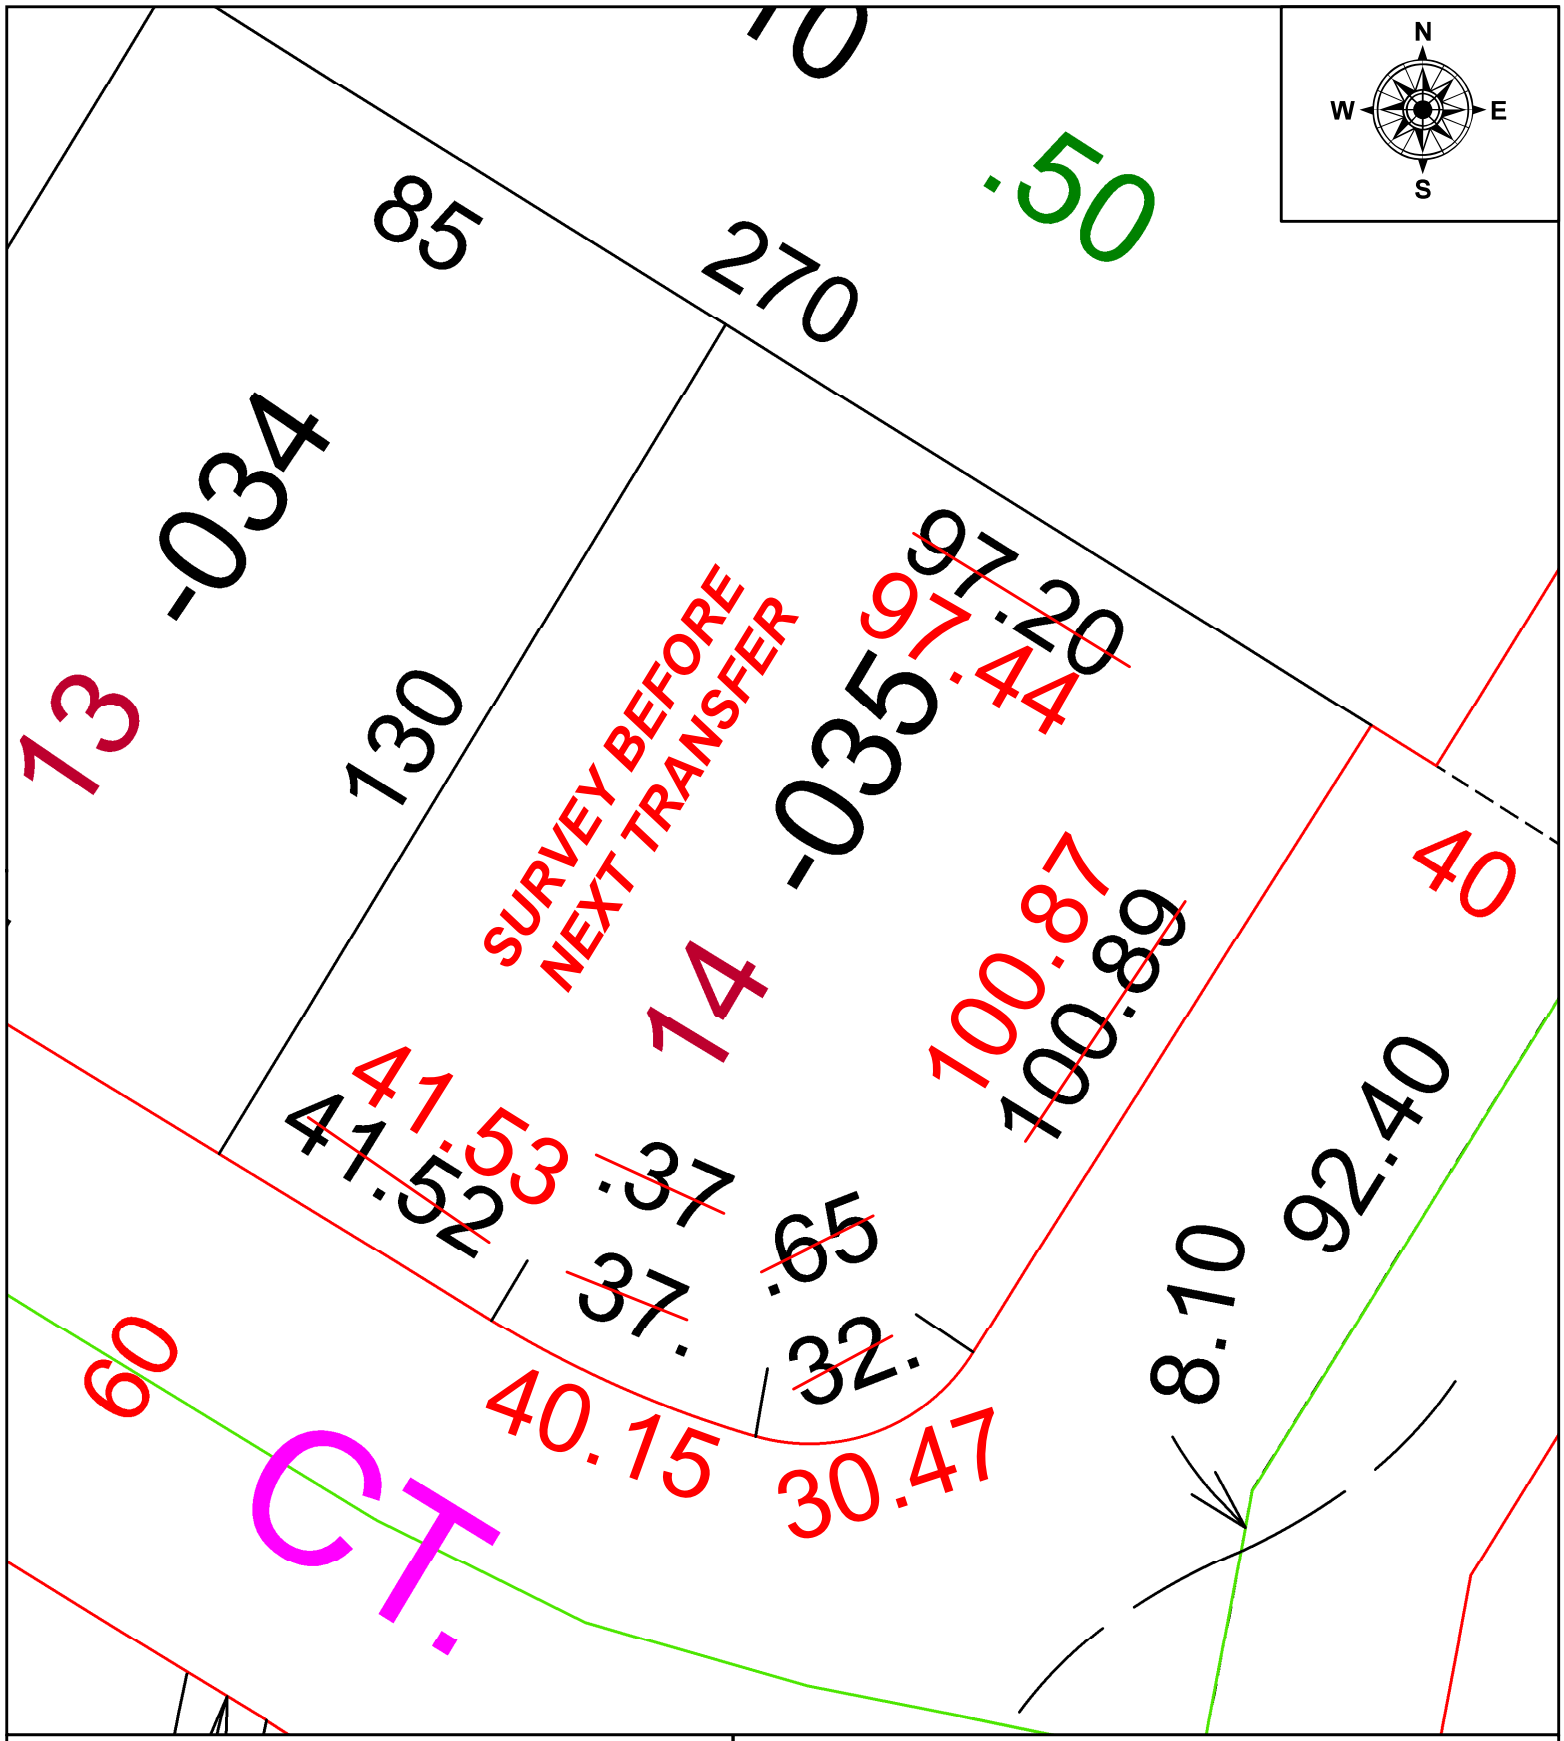

SPLITS/DEEDS PROCESSED
LORAIN COUNTY TAX MAP DEPARTMENT
226 MIDDLE AVE. ELYRIA, OH

SURVEYED BY: THOMAS A. SIMON
CLOSURE: 1:291,578
MAP PAGE(S): 6-23-019
APPOVED BY: WRZ **DATE:** 5-6-21
SCALE: 1" = 25 **PRIOR INSTRUMENT:** 2012-0412798