PARENT PARCEL: 17-08-033-000-007 & -005

CHILD PARCEL: 17-08-033-000-013 ACREAGE CORRECTION PER TIMOTHY HOZALSKI

STARTING POINT: INTERSECTION OF C/LS OF PECK WADSWORTH RD & SR 511

22-04542

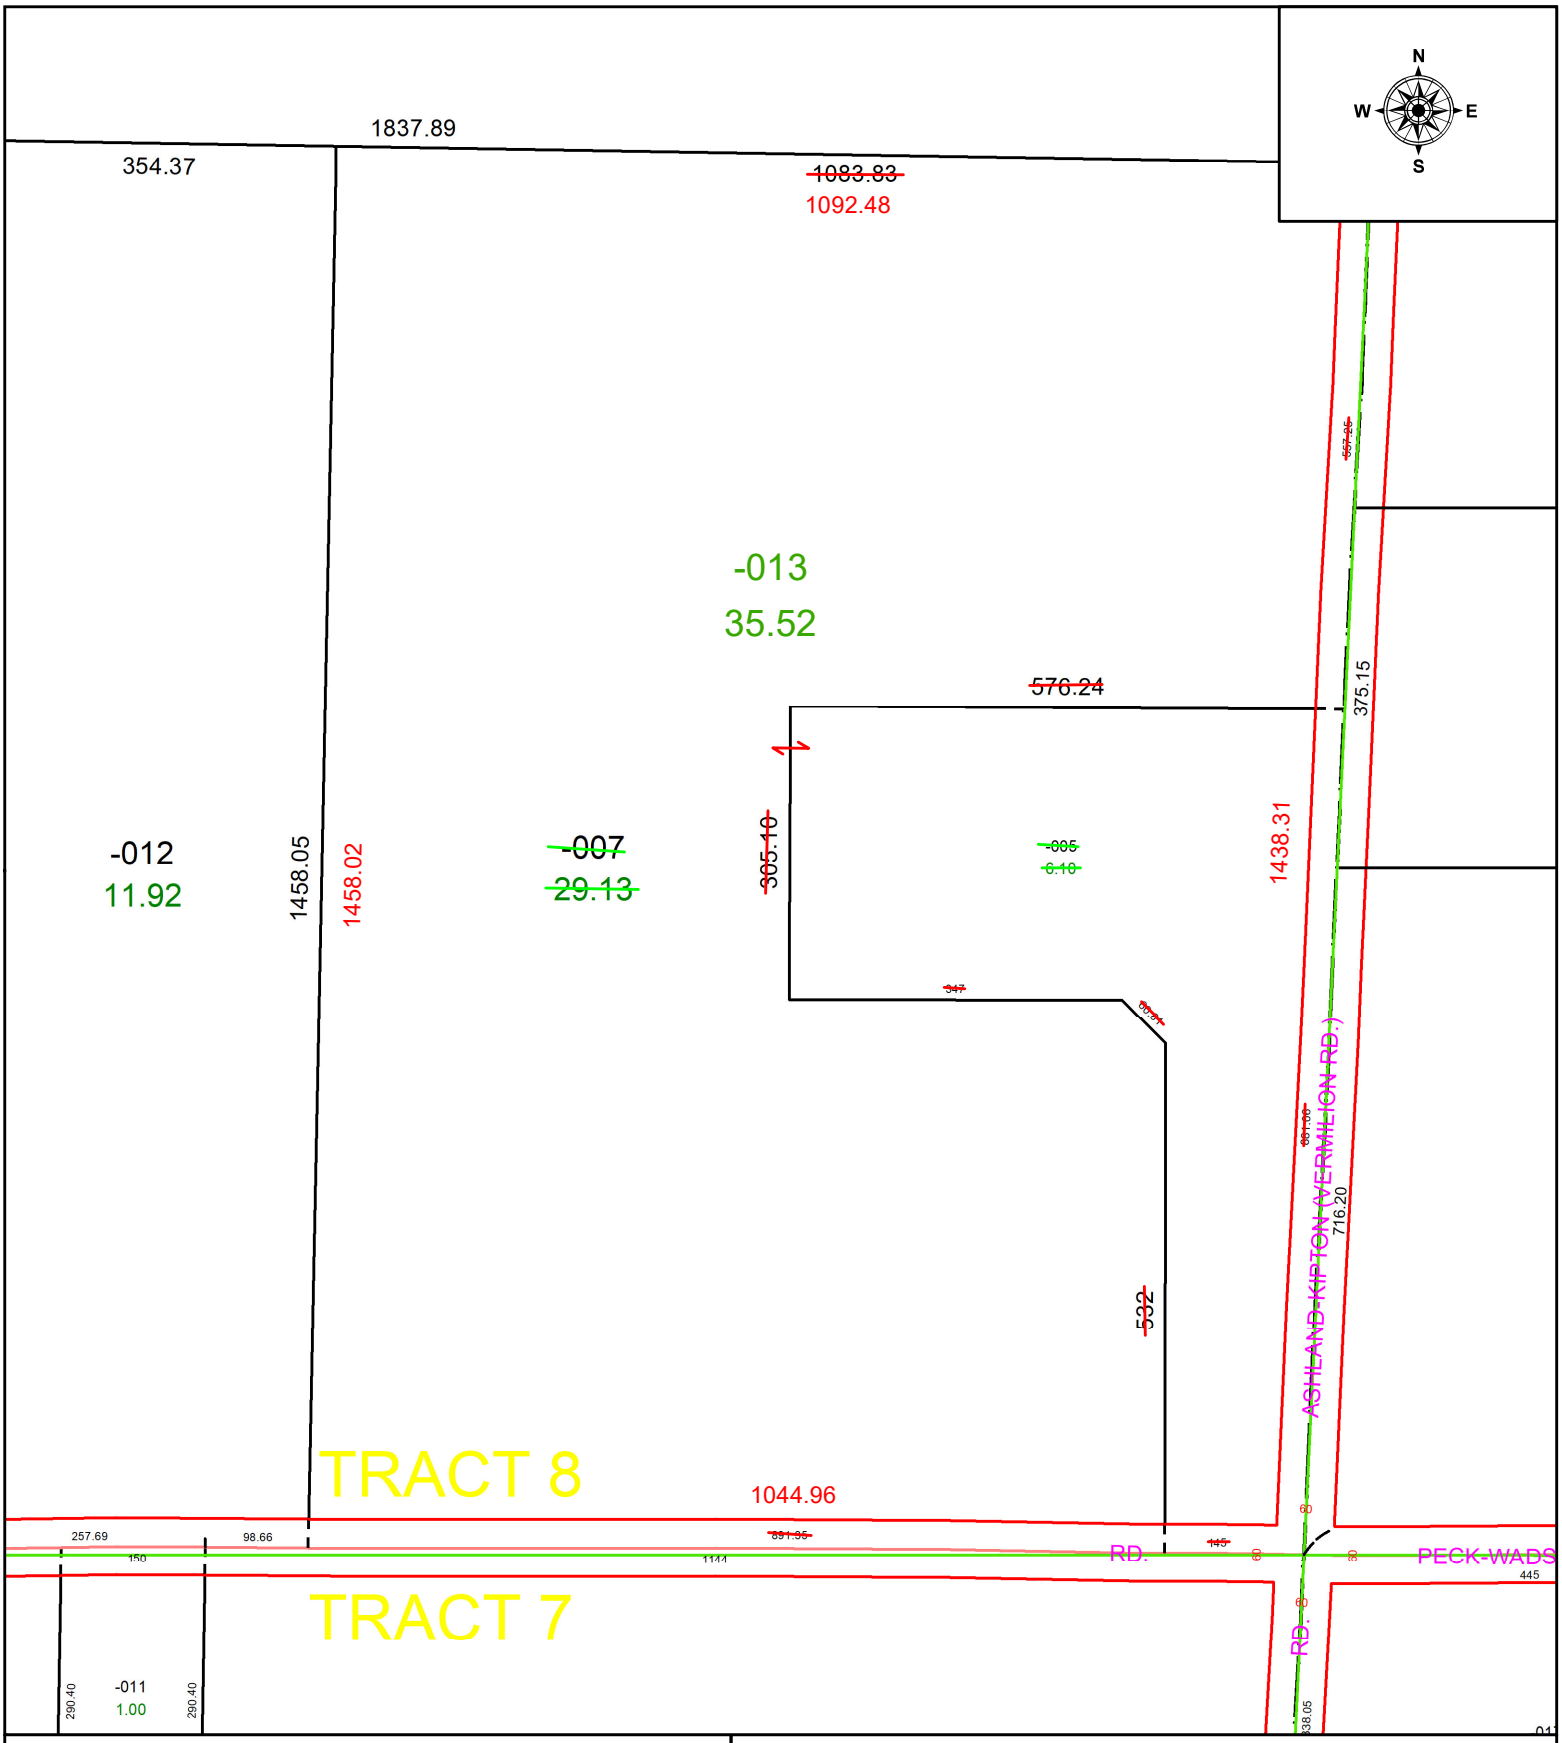

SPLITS/DEEDS PROCESSED

LORAIN COUNTY TAX MAP DEPARTMENT
226 MIDDLE AVE. ELYRIA, OH

SURVEYED BY: TIMOTHY HOZALSKI SURVEY # 50674

CLOSURE: 1: 576953

MAP PAGE(S): 17-08-033

APPOVED BY: WRZ **DATE:** 8/18/2022

SCALE: 1" = 200 **PRIOR INSTRUMENT:** 2004-0003153