PARENT PARCEL: 04-00-002-102-019 & -020

CHILD PARCEL: 04-00-002-102-376 & -377 ACREAGE CORRECTION PER SURVEYOR LOUIS GIFFELS

STARTING POINT: MONUMENT BOX @ INTERSECTION OF C/LS OF DETROIT RD & VETERAN'S MEMORIAL PKWY

22-04543

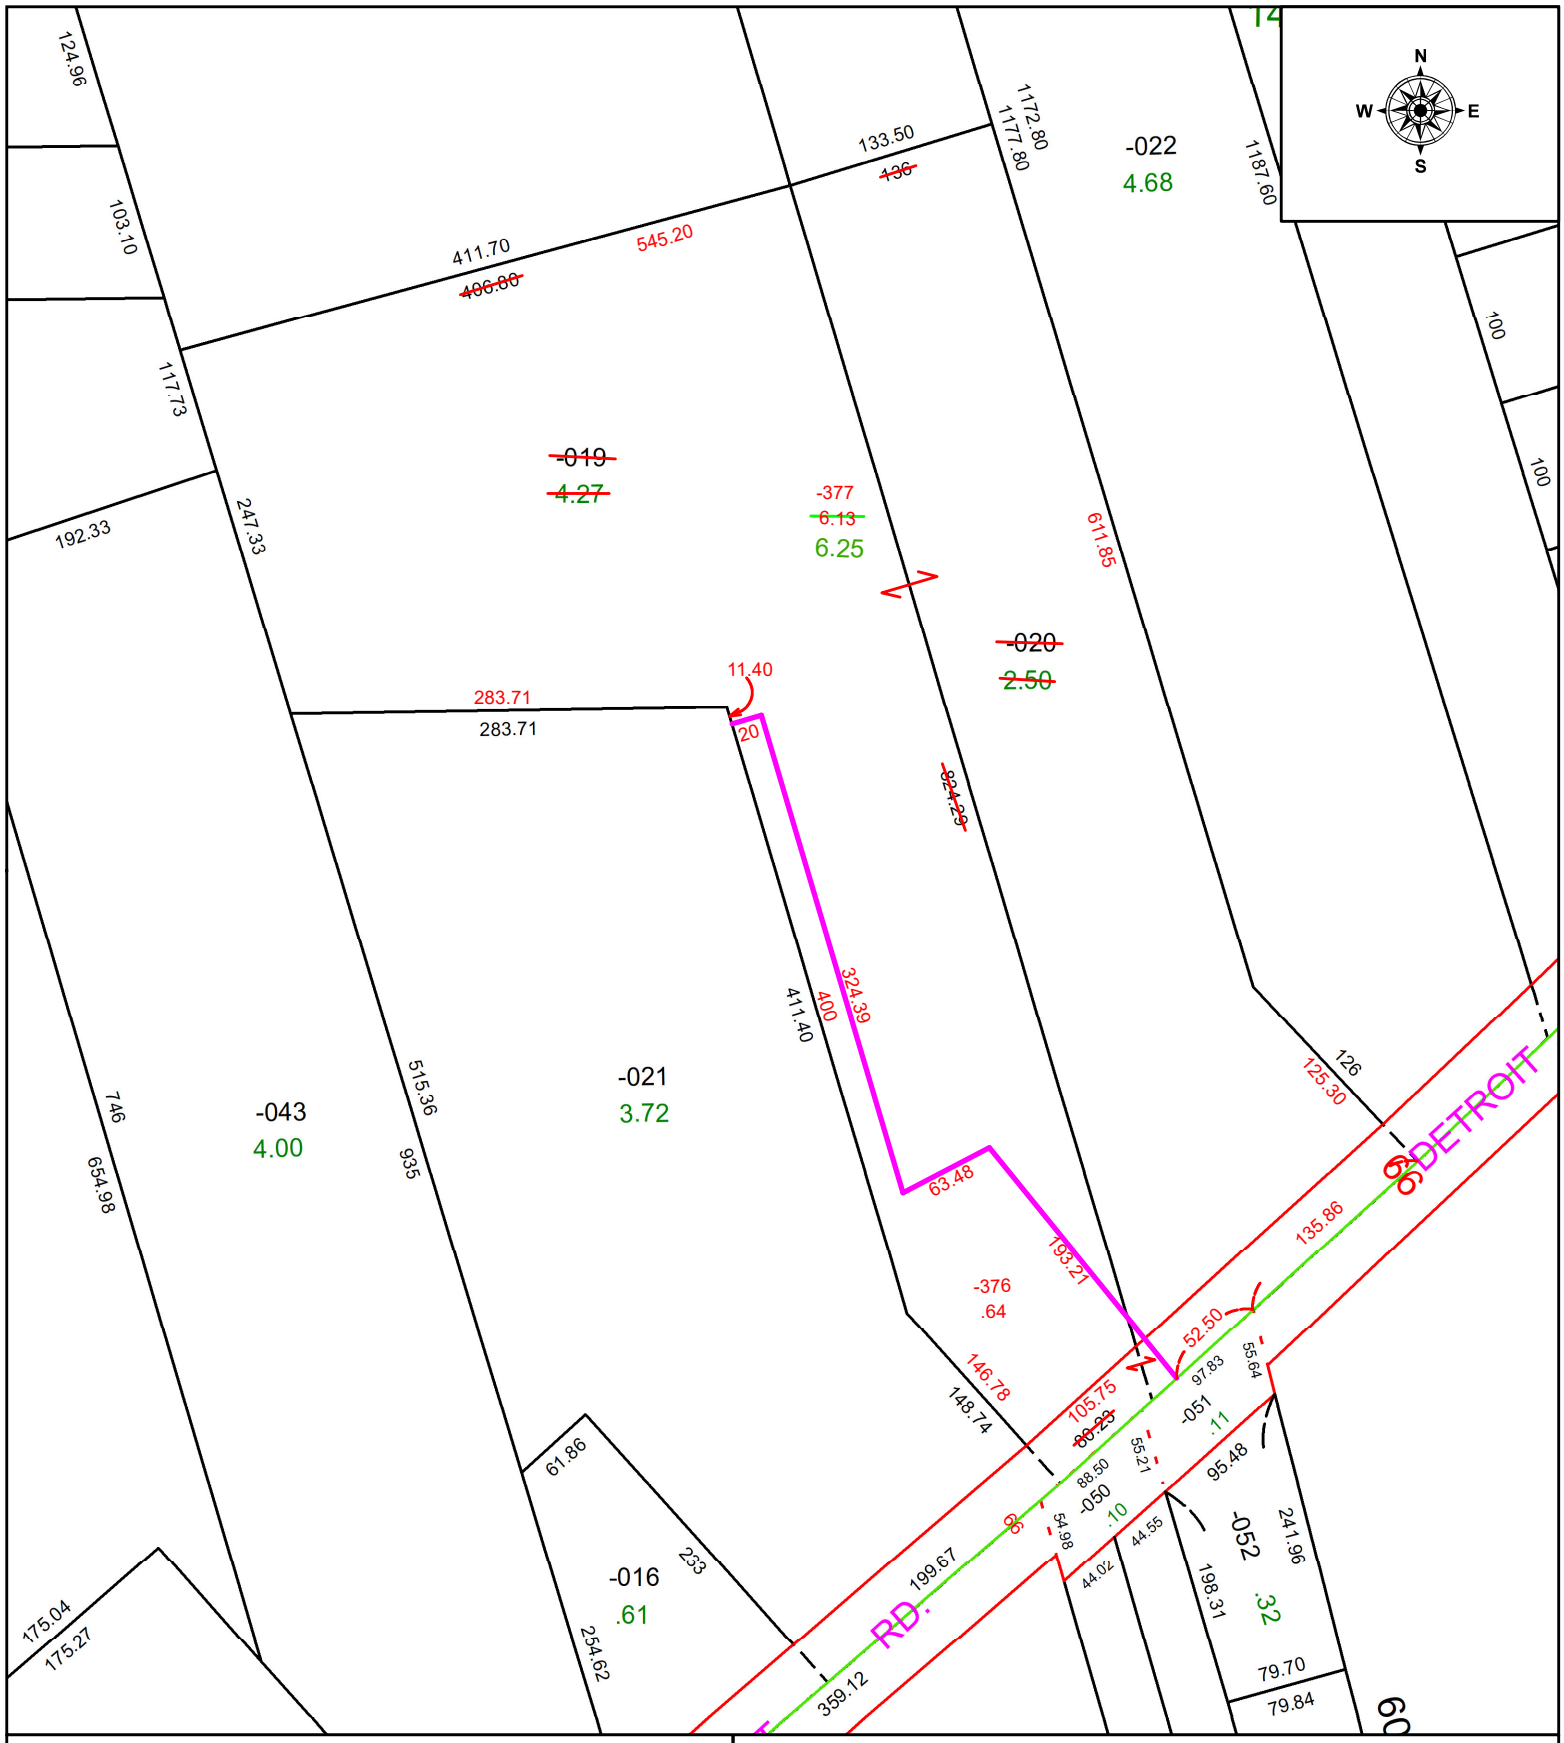

SPLITS/DEEDS PROCESSED

LORAIN COUNTY TAX MAP DEPARTMENT
226 MIDDLE AVE. ELYRIA, OH

SURVEYED BY: LOUIS GIFFELS SURVEY # 50676

CLOSURE: 1: 245630

MAP PAGE(S): 04-00-002

APPOVED BY: WRZ **DATE:** 8/23/2022

SCALE: 1" = 125 **PRIOR INSTRUMENT:** 2021-0852012