PARENT PARCEL: 05-00-017-000-033 & -153

CHILD PARCEL: 05-00-017-000-267 **AC CORR PER SURV BY JOHN A. DECHANT JR.**

STARTING POINT: C/L OF S LAKE ST AND VAN OAKS DR

22-04547

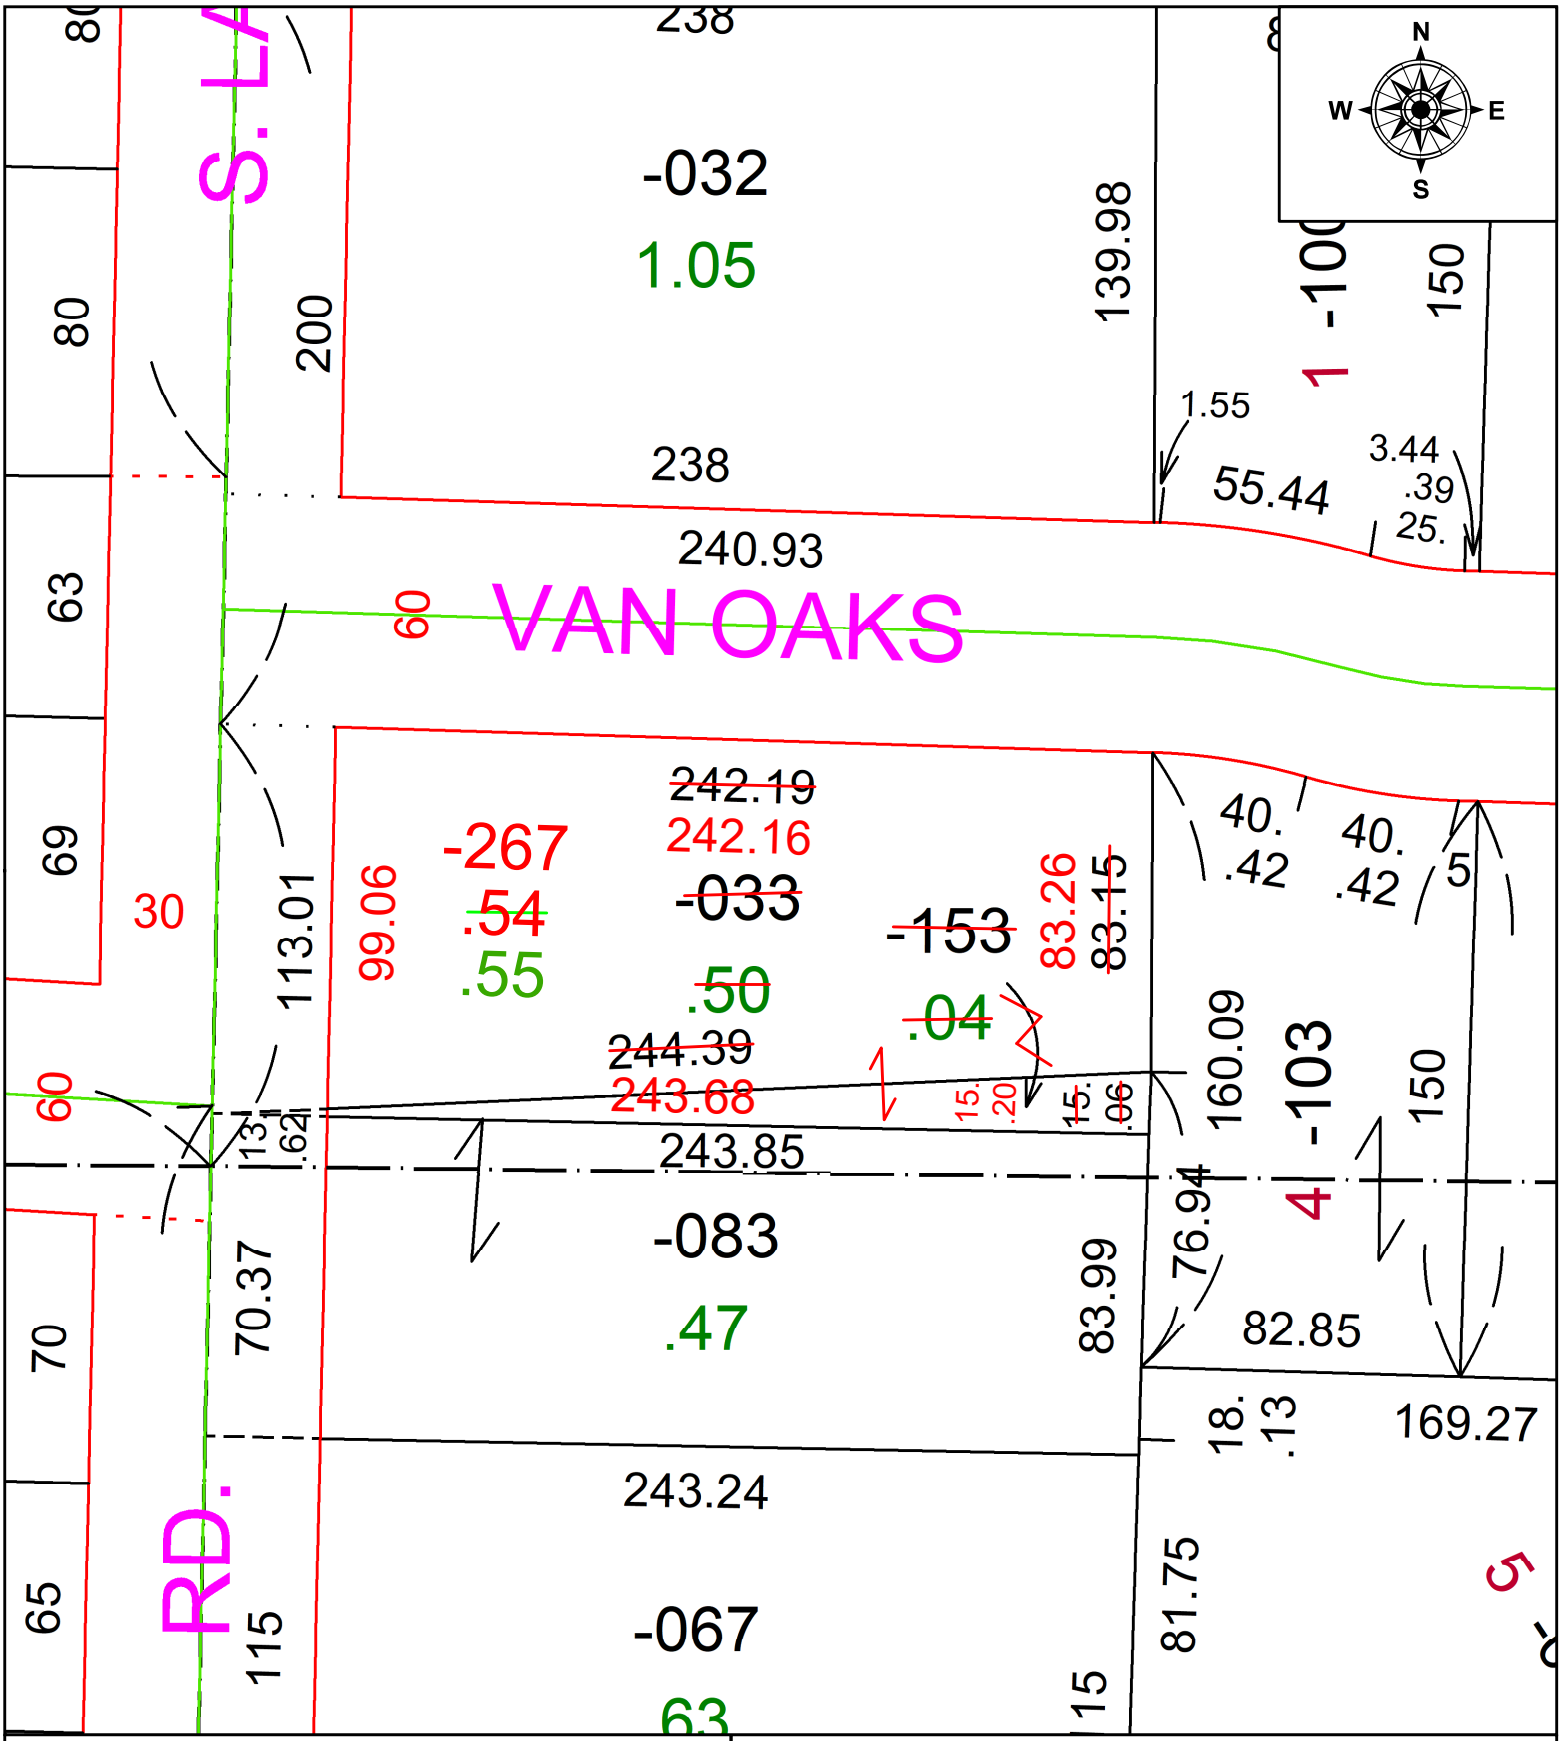

SPLITS/DEEDS PROCESSED

LORAIN COUNTY TAX MAP DEPARTMENT
226 MIDDLE AVE. ELYRIA, OH

SURVEYED BY: JOHN A. DECHANT JR. SURV # 50680

CLOSURE: 1: 87366

MAP PAGE(S): 05-00-017-A

APPOVED BY: AC **DATE:** August 26, 2022

SCALE: 1" = 50 **PRIOR INSTRUMENT:** 2005- 0066157