PARENT PARCEL: ADD TO DUPLICATE & FRONTAGE / DEPTH CORRECTIONS

CHILD PARCEL: 09-00-085-109-041 16.50 X 99.00 DV. 24/405 & DV. 170/271

DEPTH CORRECTION: 09-00-085-109-011 99.00 X 260.00, -012 99.00 X 243.50, & -022 66.00 X 170.25

21-04549-C

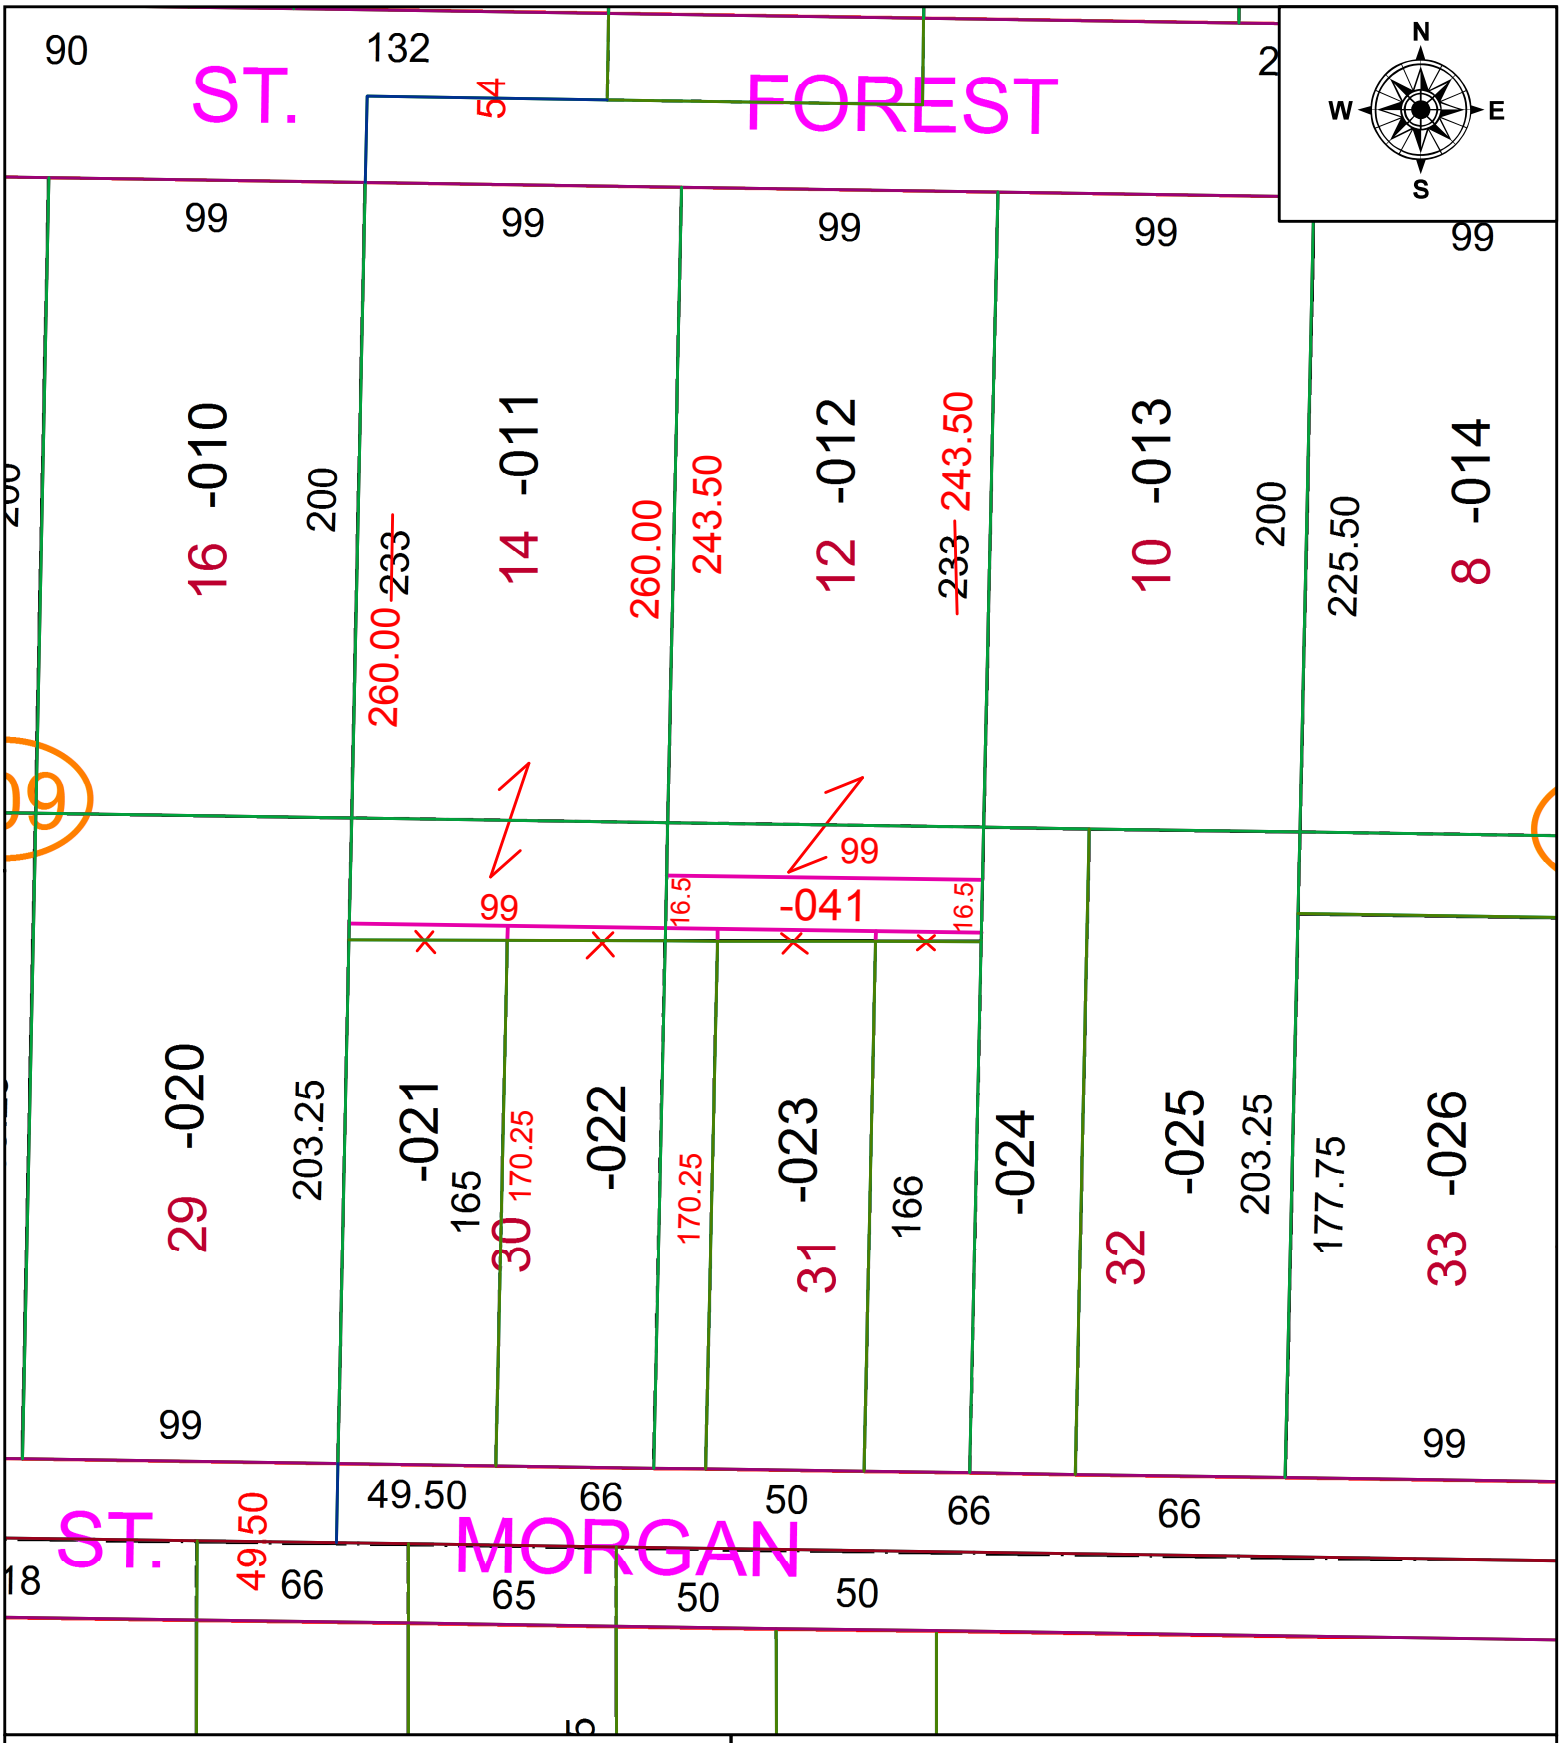

SPLITS/DEEDS PROCESSED

LORAIN COUNTY TAX MAP DEPARTMENT
226 MIDDLE AVE. ELYRIA, OH

SURVEYED BY: NA
CLOSURE: 1: 33,000
MAP PAGE(S): 09-00-085
APPOVED BY: TJS **DATE:** 5/10/2021
SCALE: 1" = 60' **PRIOR INSTRUMENT:** DV 24/405