PARENT PARCEL: 13-11-006-000-016
CHILD PARCEL: 13-11-006-000-018, -019 & -020
STARTING POINT: CL OF U.S. 20 & S.R. 511

22-04549

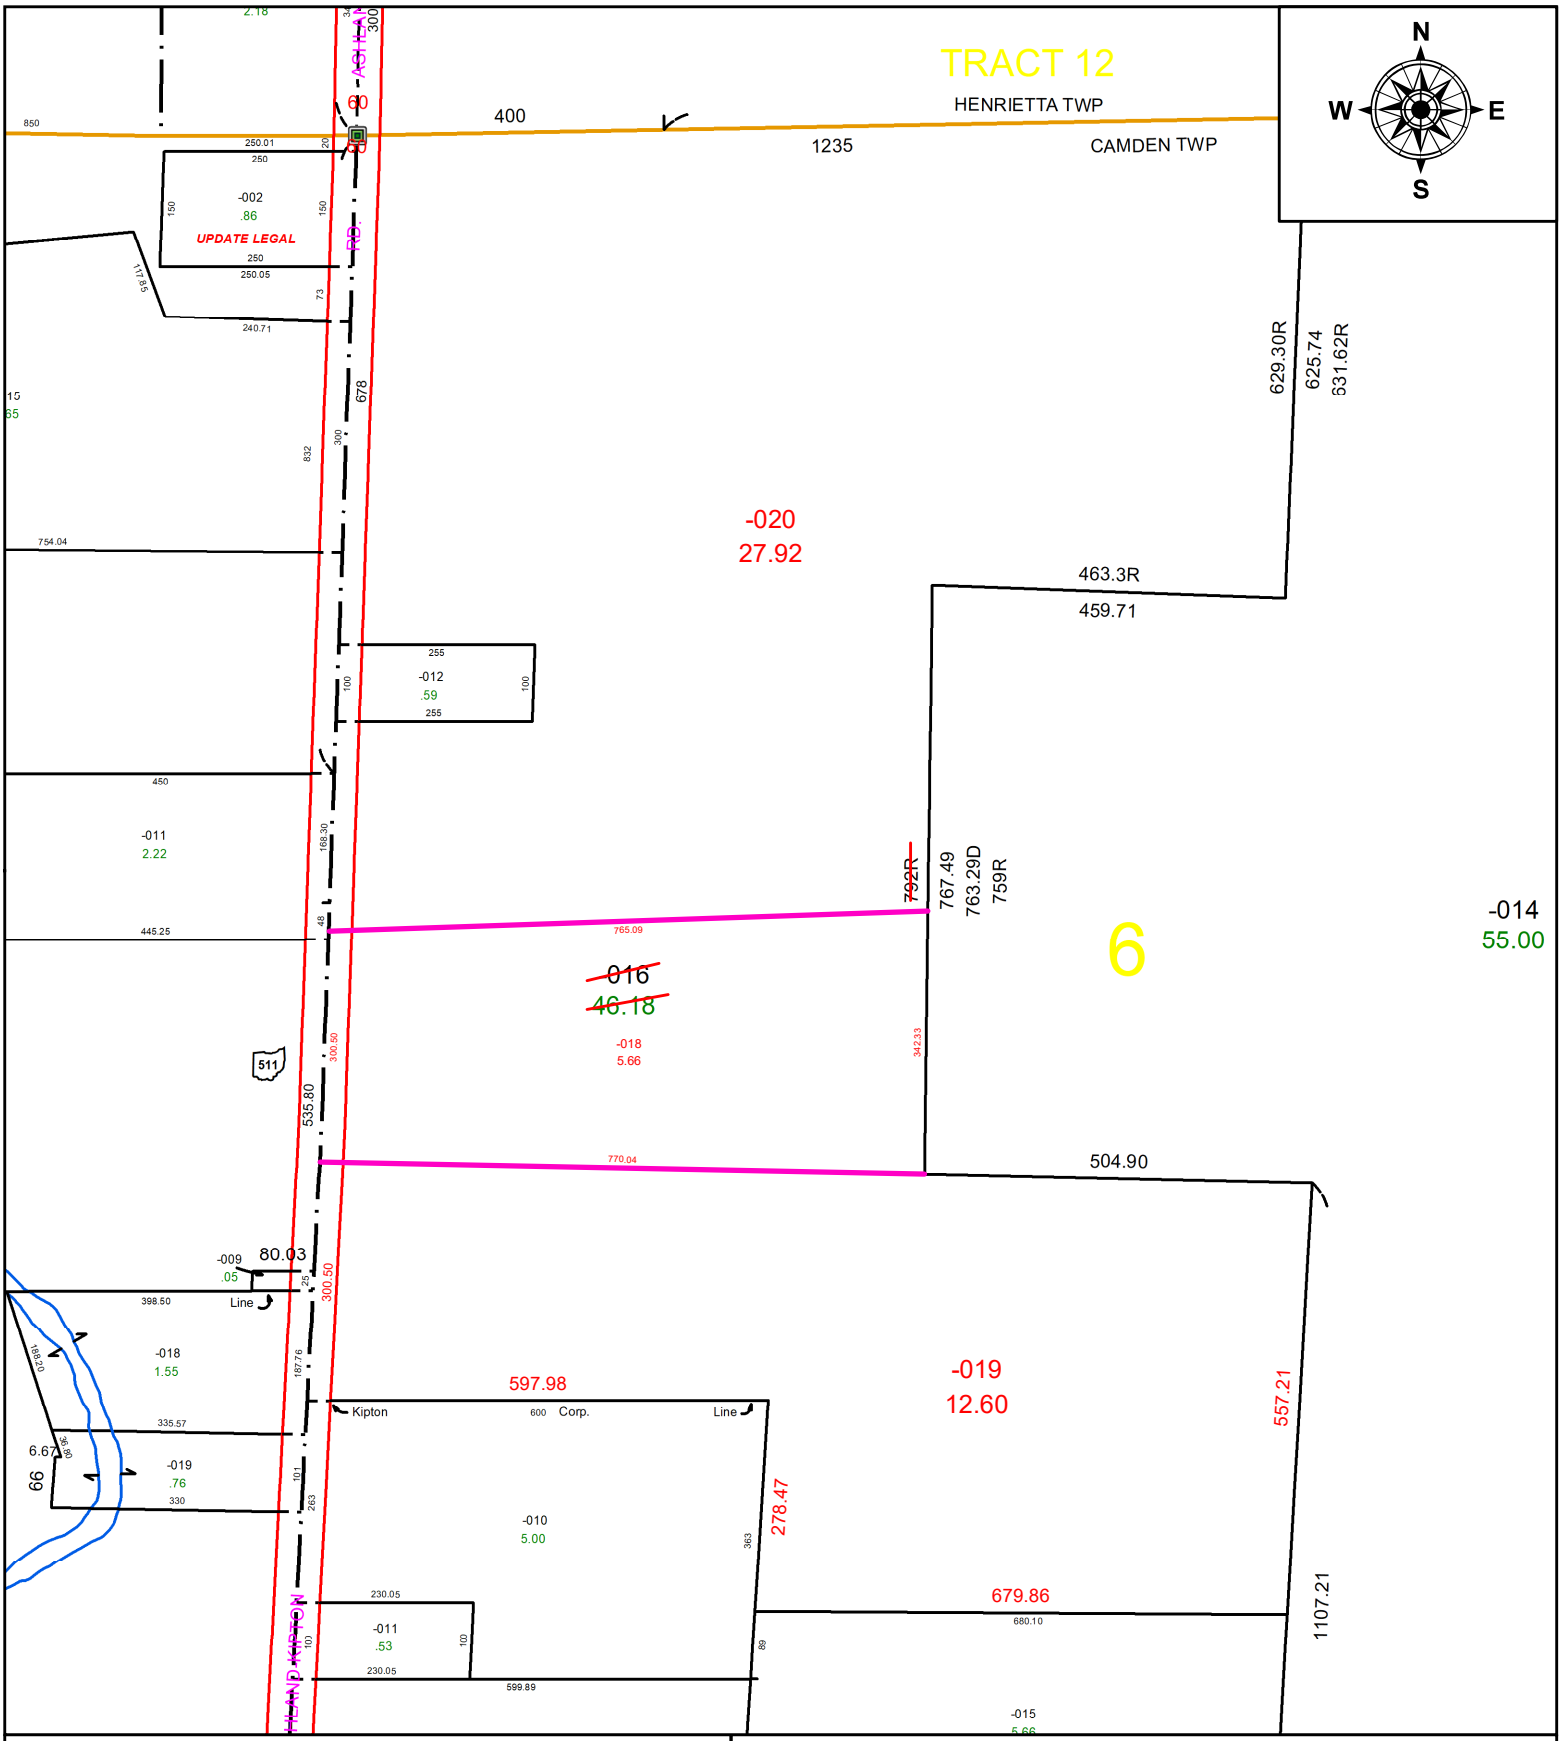

SPLITS/DEEDS PROCESSED

LORAIN COUNTY TAX MAP DEPARTMENT
226 MIDDLE AVE. ELYRIA, OH

SURVEYED BY: TIMOTHY HOZALSKI **SURVEY #:** 50684
CLOSURE: 1:252662
MAP PAGE(S): 13-11-006
APPOVED BY: DMA **DATE:** 8/31/2022
SCALE: 1" = 250' **PRIOR INSTRUMENT:** 2022-0886195