PARENT PARCEL: 07-00-030-000-047

CHILD PARCEL:

STARTING POINT: WEST LINE OF WOOSTER-AVON LAKE ROAD AT NE CORNER OF LAND CONVEYED IN VOL 1174, PG 703 OF LC RECORDS

21-04553-A

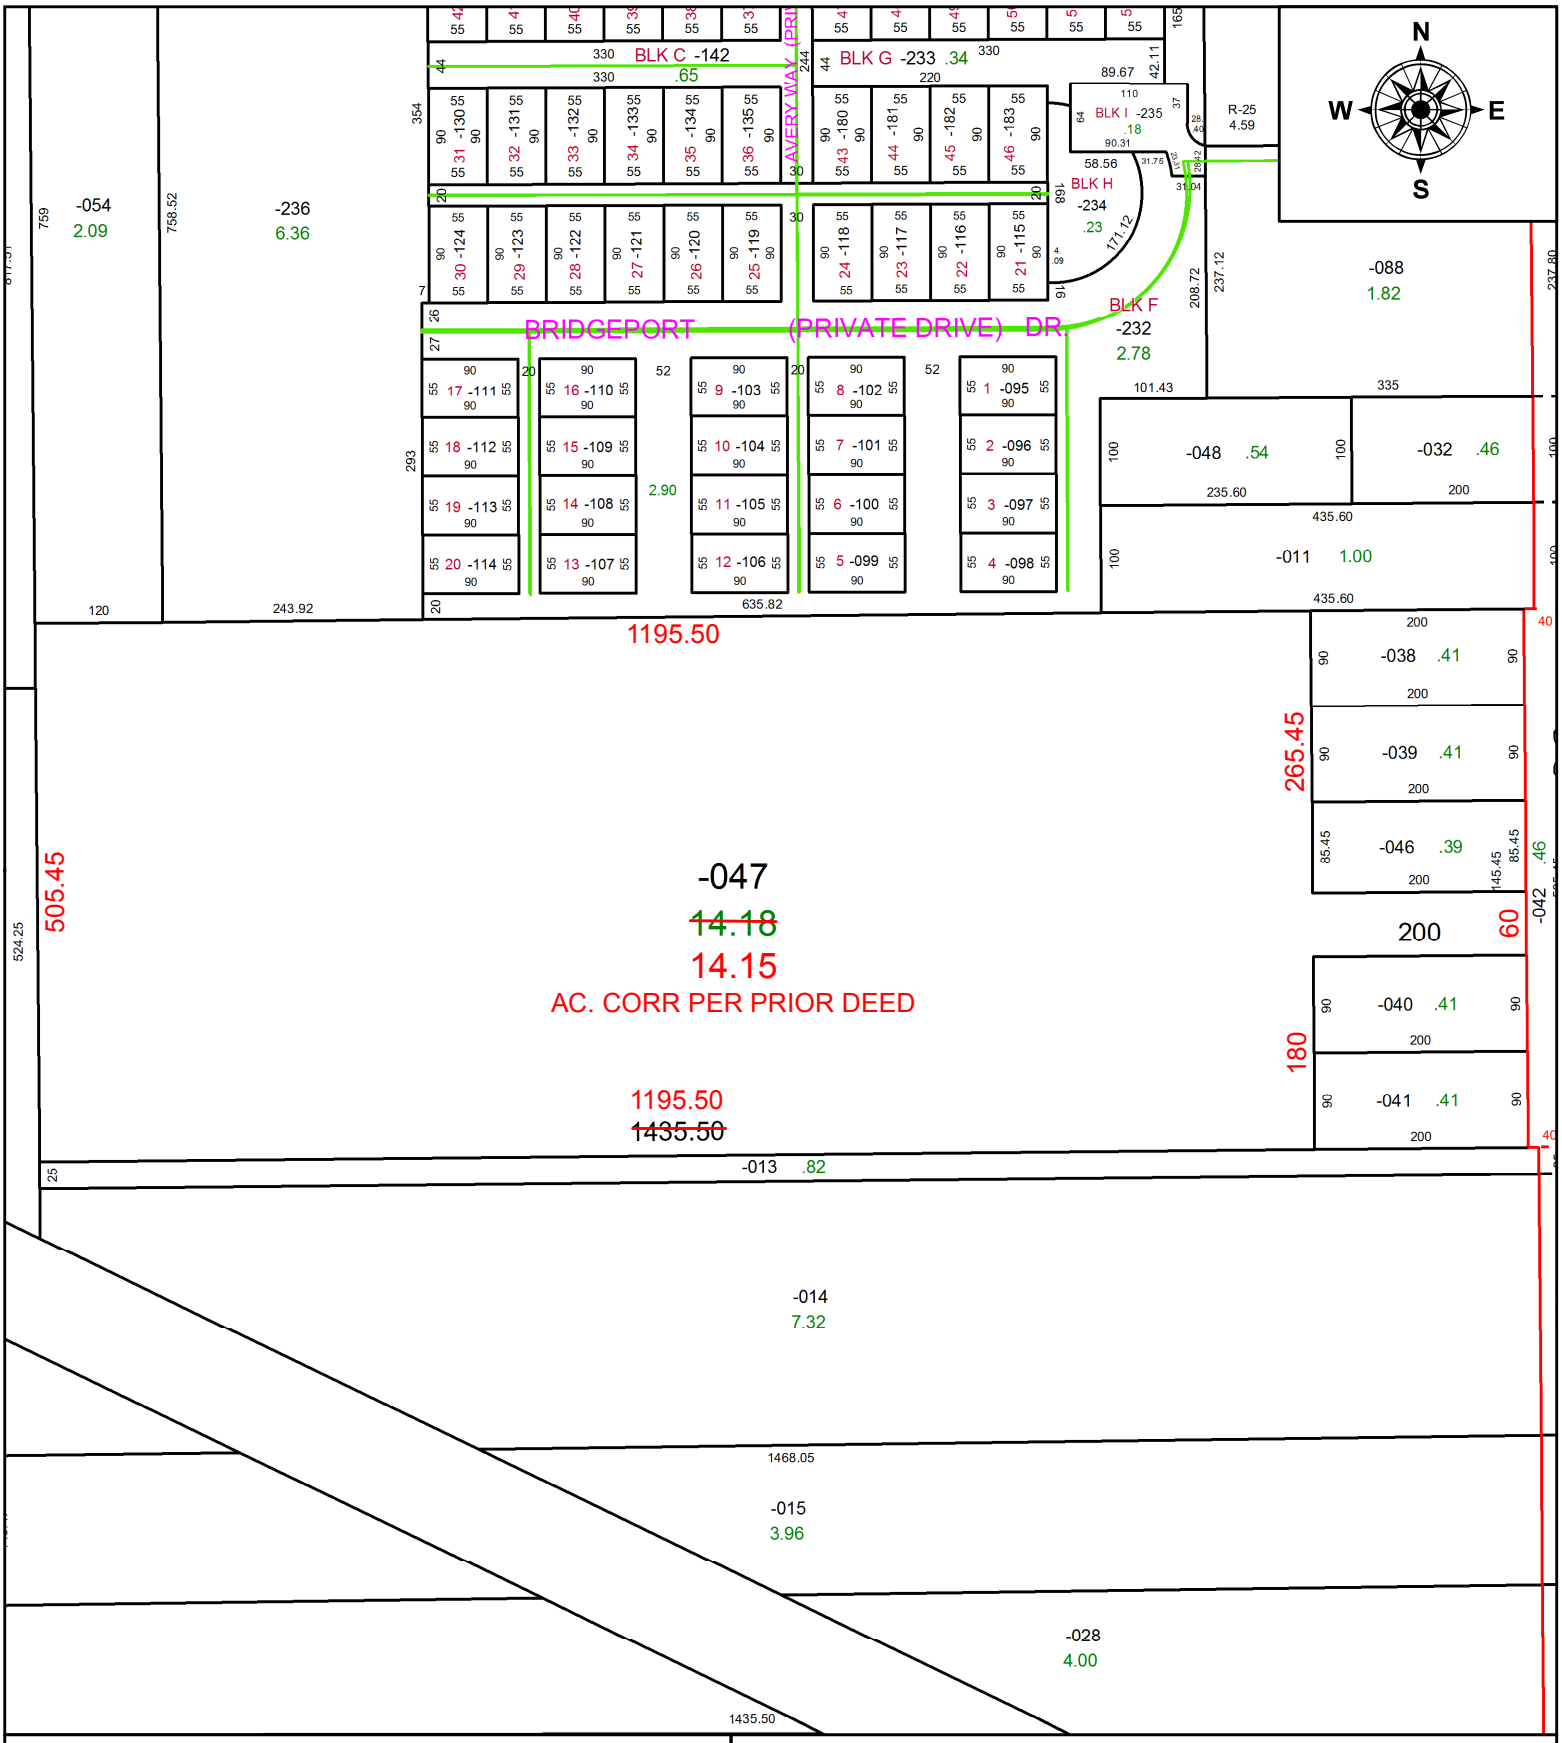

SPLITS/DEEDS PROCESSED

LORAIN COUNTY TAX MAP DEPARTMENT
226 MIDDLE AVE. ELYRIA, OH

SURVEYED BY: N/A
CLOSURE: 1: 2457248231
MAP PAGE(S): 07-00-030-B
APPOVED BY: AC **DATE:** 5/13/2021
SCALE: 1" = 180 **PRIOR INSTRUMENT:** 1988-0040083