PARENT PARCEL: 03-00-075-109-025 & -026

CHILD PARCEL: 03-00-075-109-039

STARTING POINT: SW CORNER OF S/L 18 **FRONT & DEPTH TO AC CORR PER SURV BY WIL BARBOSA**

22-04555

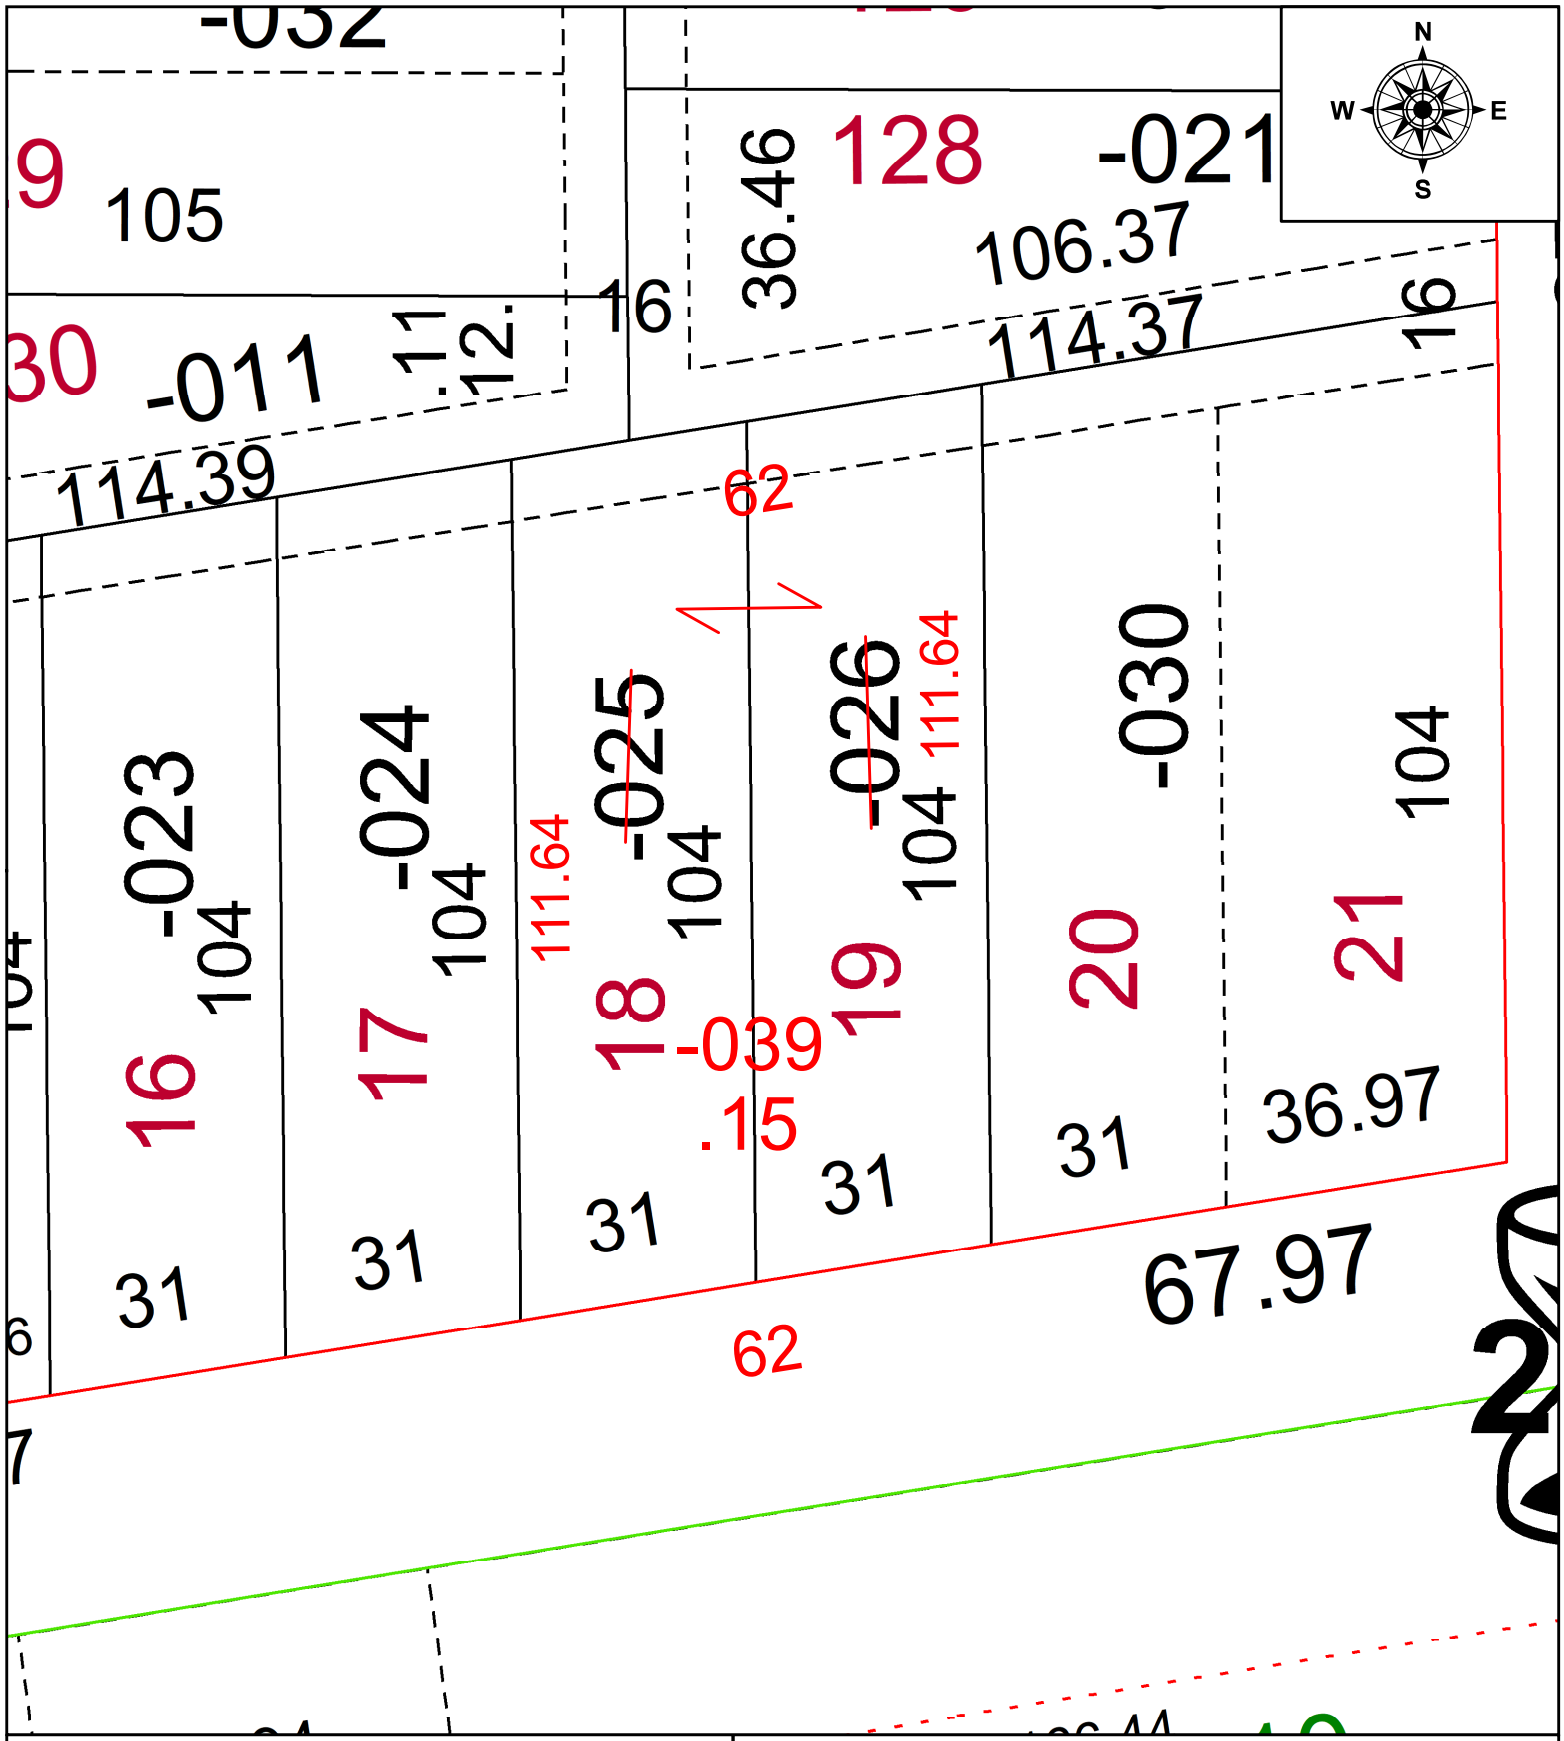

SPLITS/DEEDS PROCESSED

LORAIN COUNTY TAX MAP DEPARTMENT
226 MIDDLE AVE. ELYRIA, OH

SURVEYED BY: WILFREDO BARBOSA **SURV # 50692**

CLOSURE: 1: 2147483648

MAP PAGE(S): 03-00-075

APPOVED BY: AC **DATE:** September 20, 2022

SCALE: 1 in = 25 ft **PRIOR INSTRUMENT:** 2000- 0684061