PARENT PARCEL: 06-24-082-000-001, -002, -003

CHILD PARCEL: 06-24-082-000-006

STARTING POINT: FRONT & DEPTH TO AC CORR PER SURV BY JOHN A. DECHANT JR

22-04561

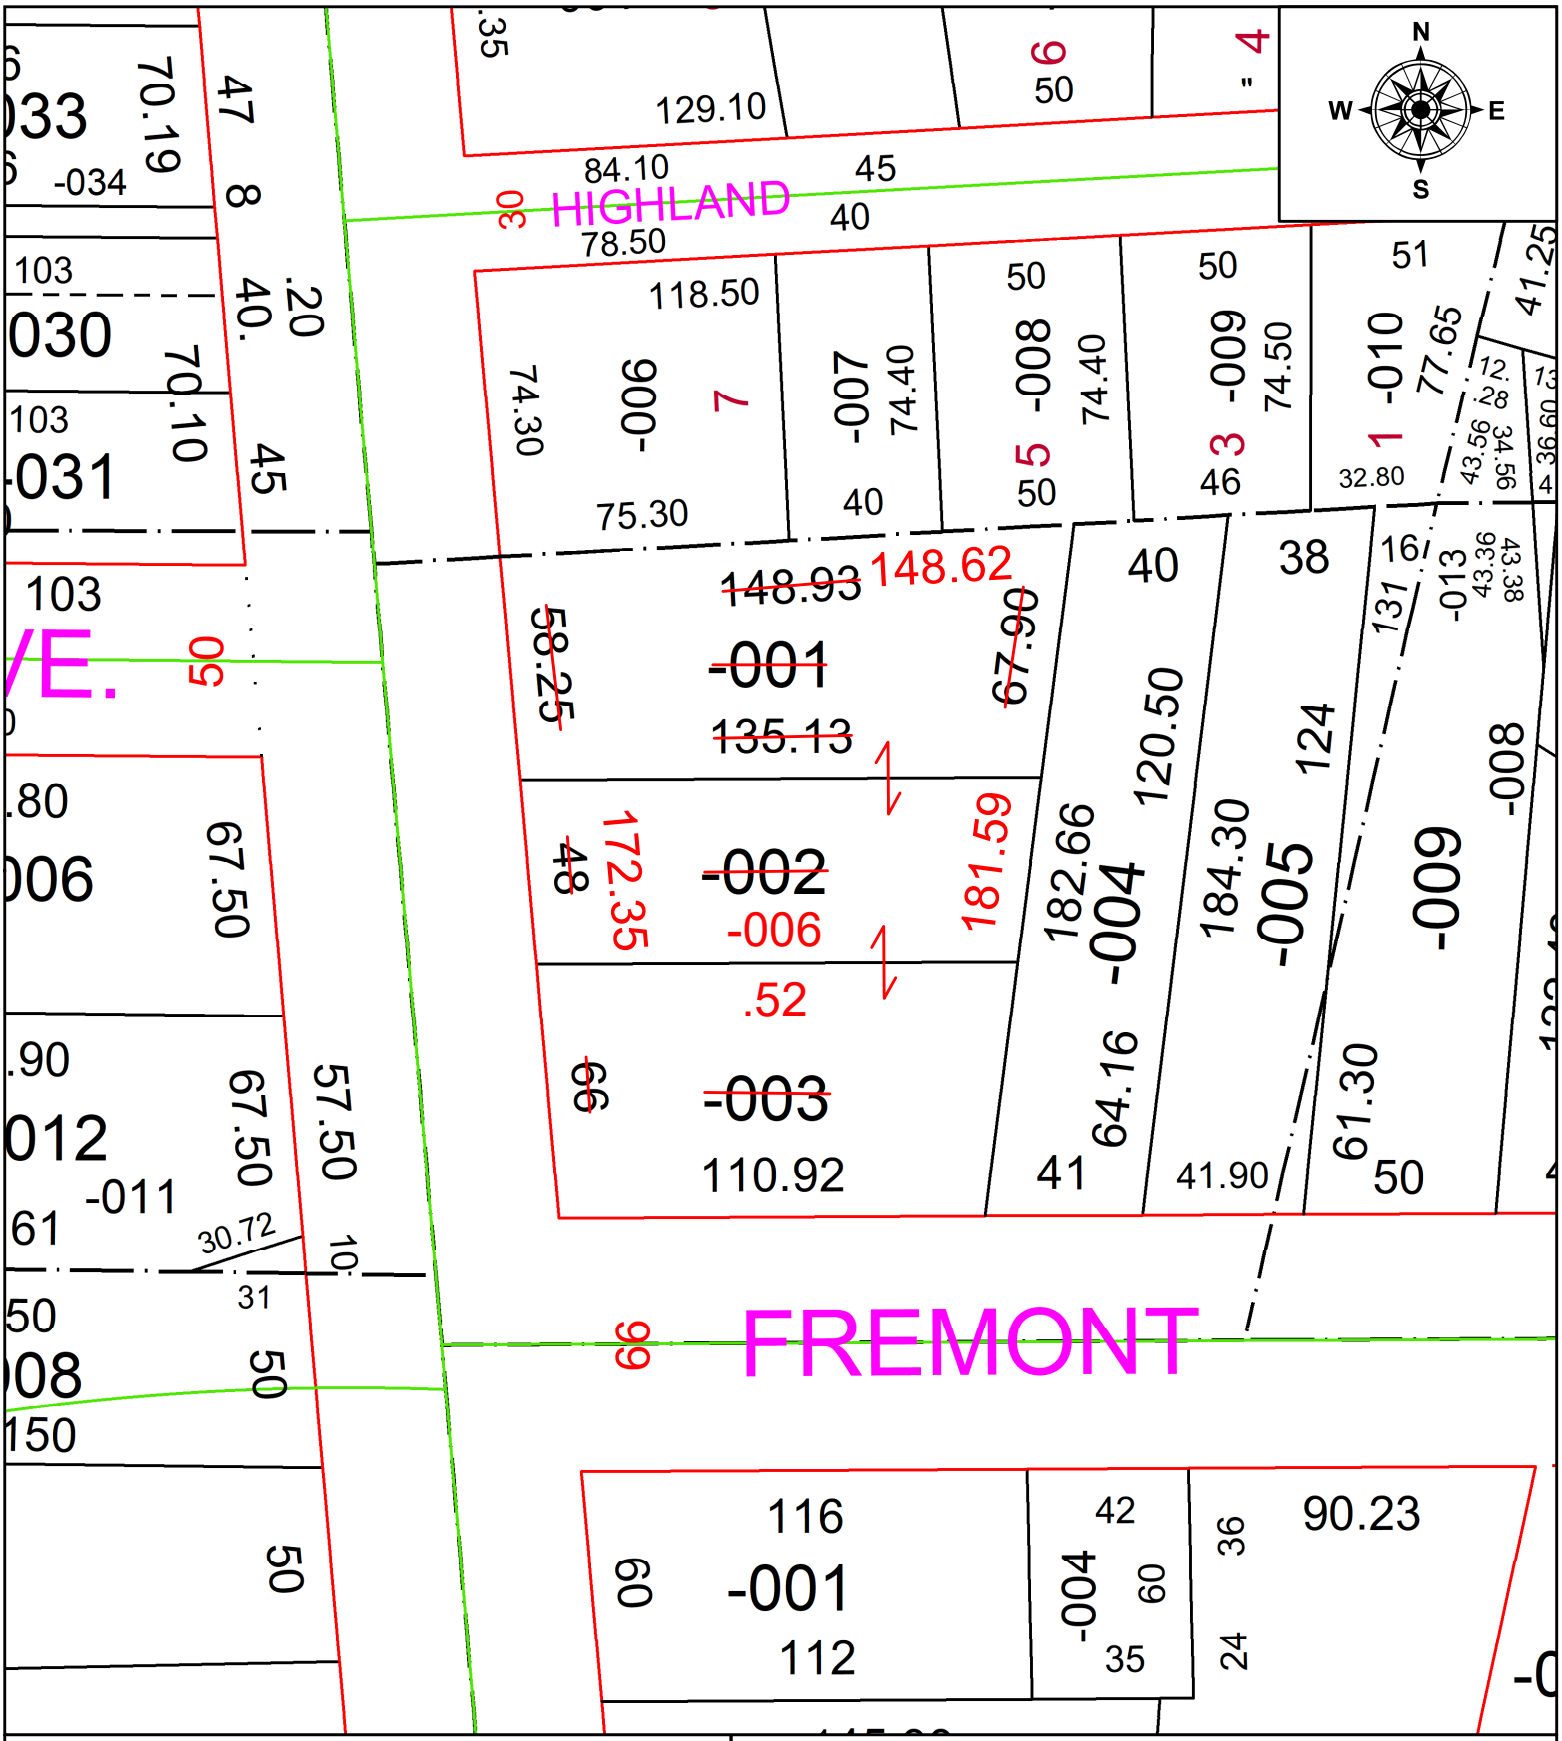

SPLITS/DEEDS PROCESSED

LORAIN COUNTY TAX MAP DEPARTMENT
226 MIDDLE AVE. ELYRIA, OH

SURVEYED BY: JOHN A. DECHANT JR **SURV # 50700**

CLOSURE: 1: 134641

MAP PAGE(S): 06-183

APPOVED BY: AC **DATE:** September 28, 2022

SCALE: 1 in = 50 ft **PRIOR INSTRUMENT:** 2022- 0890351