PARENT PARCEL: 09-00-083-101-003, -004, -006, & -083

CHILD PARCEL: ACREAGE & MAP CORRECTION PER SURVEY T. BIXLER

STARTING POINT: MAG. NAIL SET, CL OF PYLE SOUTH AMHERST RD. & CL OF WEST LORAIN ST. (S.R. 511)

21-04563-A

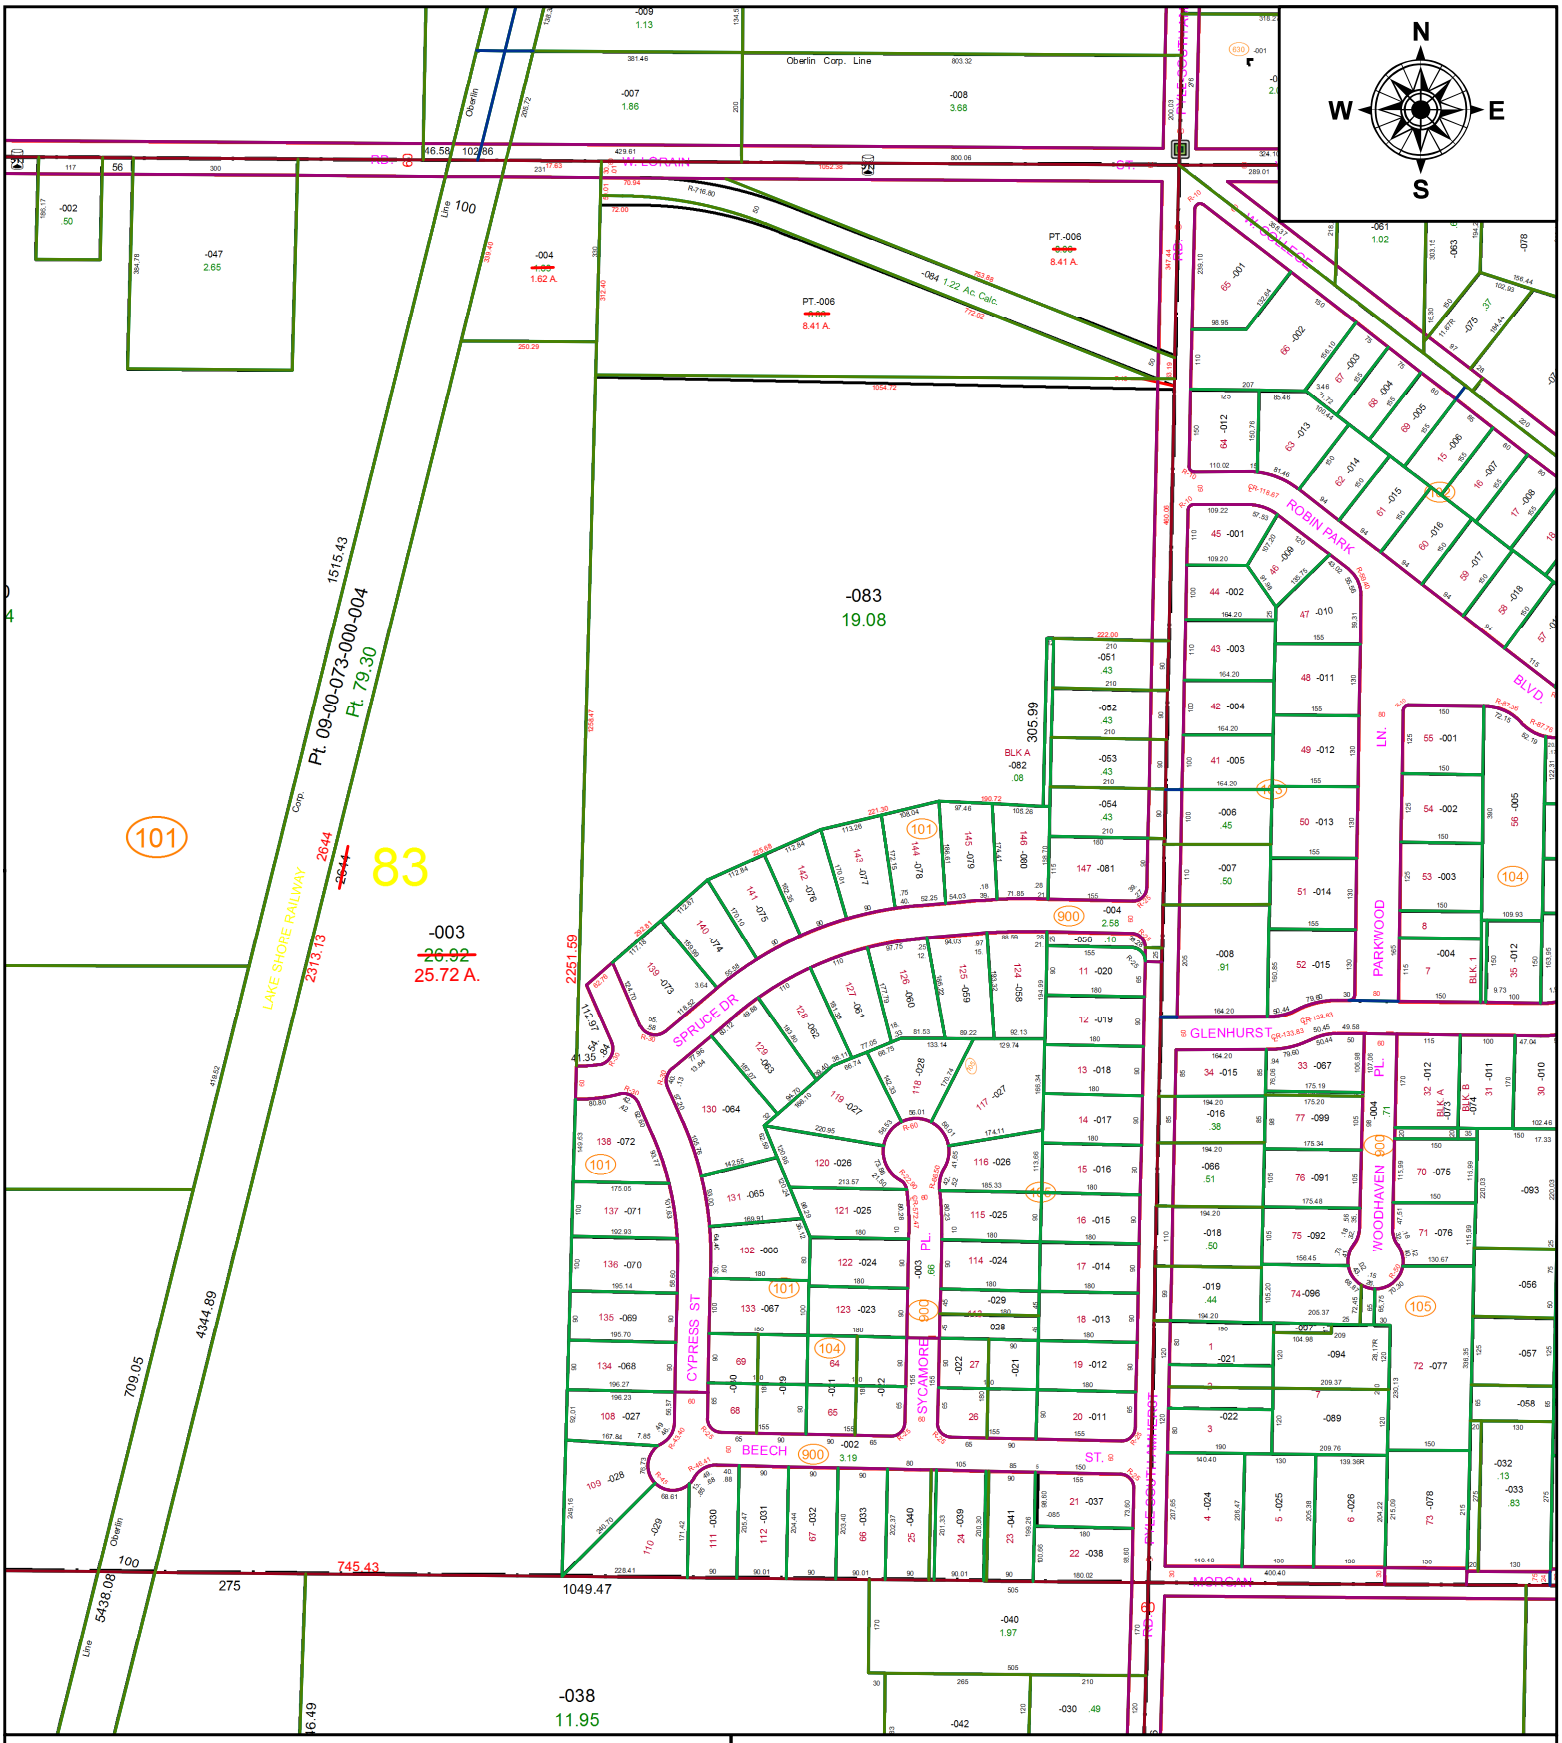

SPLITS/DEEDS PROCESSED

LORAIN COUNTY TAX MAP DEPARTMENT
226 MIDDLE AVE. ELYRIA, OH

SURVEYED BY: T. BIXLER
CLOSURE: 1: 33,000
MAP PAGE(S): 09-00-083
APPOVED BY: TJS **DATE:** 5/26/2021
SCALE: 1" = 350' **PRIOR INSTRUMENT:** DV 905/568 & 1060/330