PARENT PARCEL: 06-21-001-101-065

CHILD PARCEL: 06-21-001-101-067 & -068 ACREAGE CORRECTION PER SURVEYOR TREVOR BIXLER

STARTING POINT: MONUMENT BOX @ INTERSECTION OF C/LS OF COOPER FOSTER RD & SOUTH BROADWAY AVE

22-04565

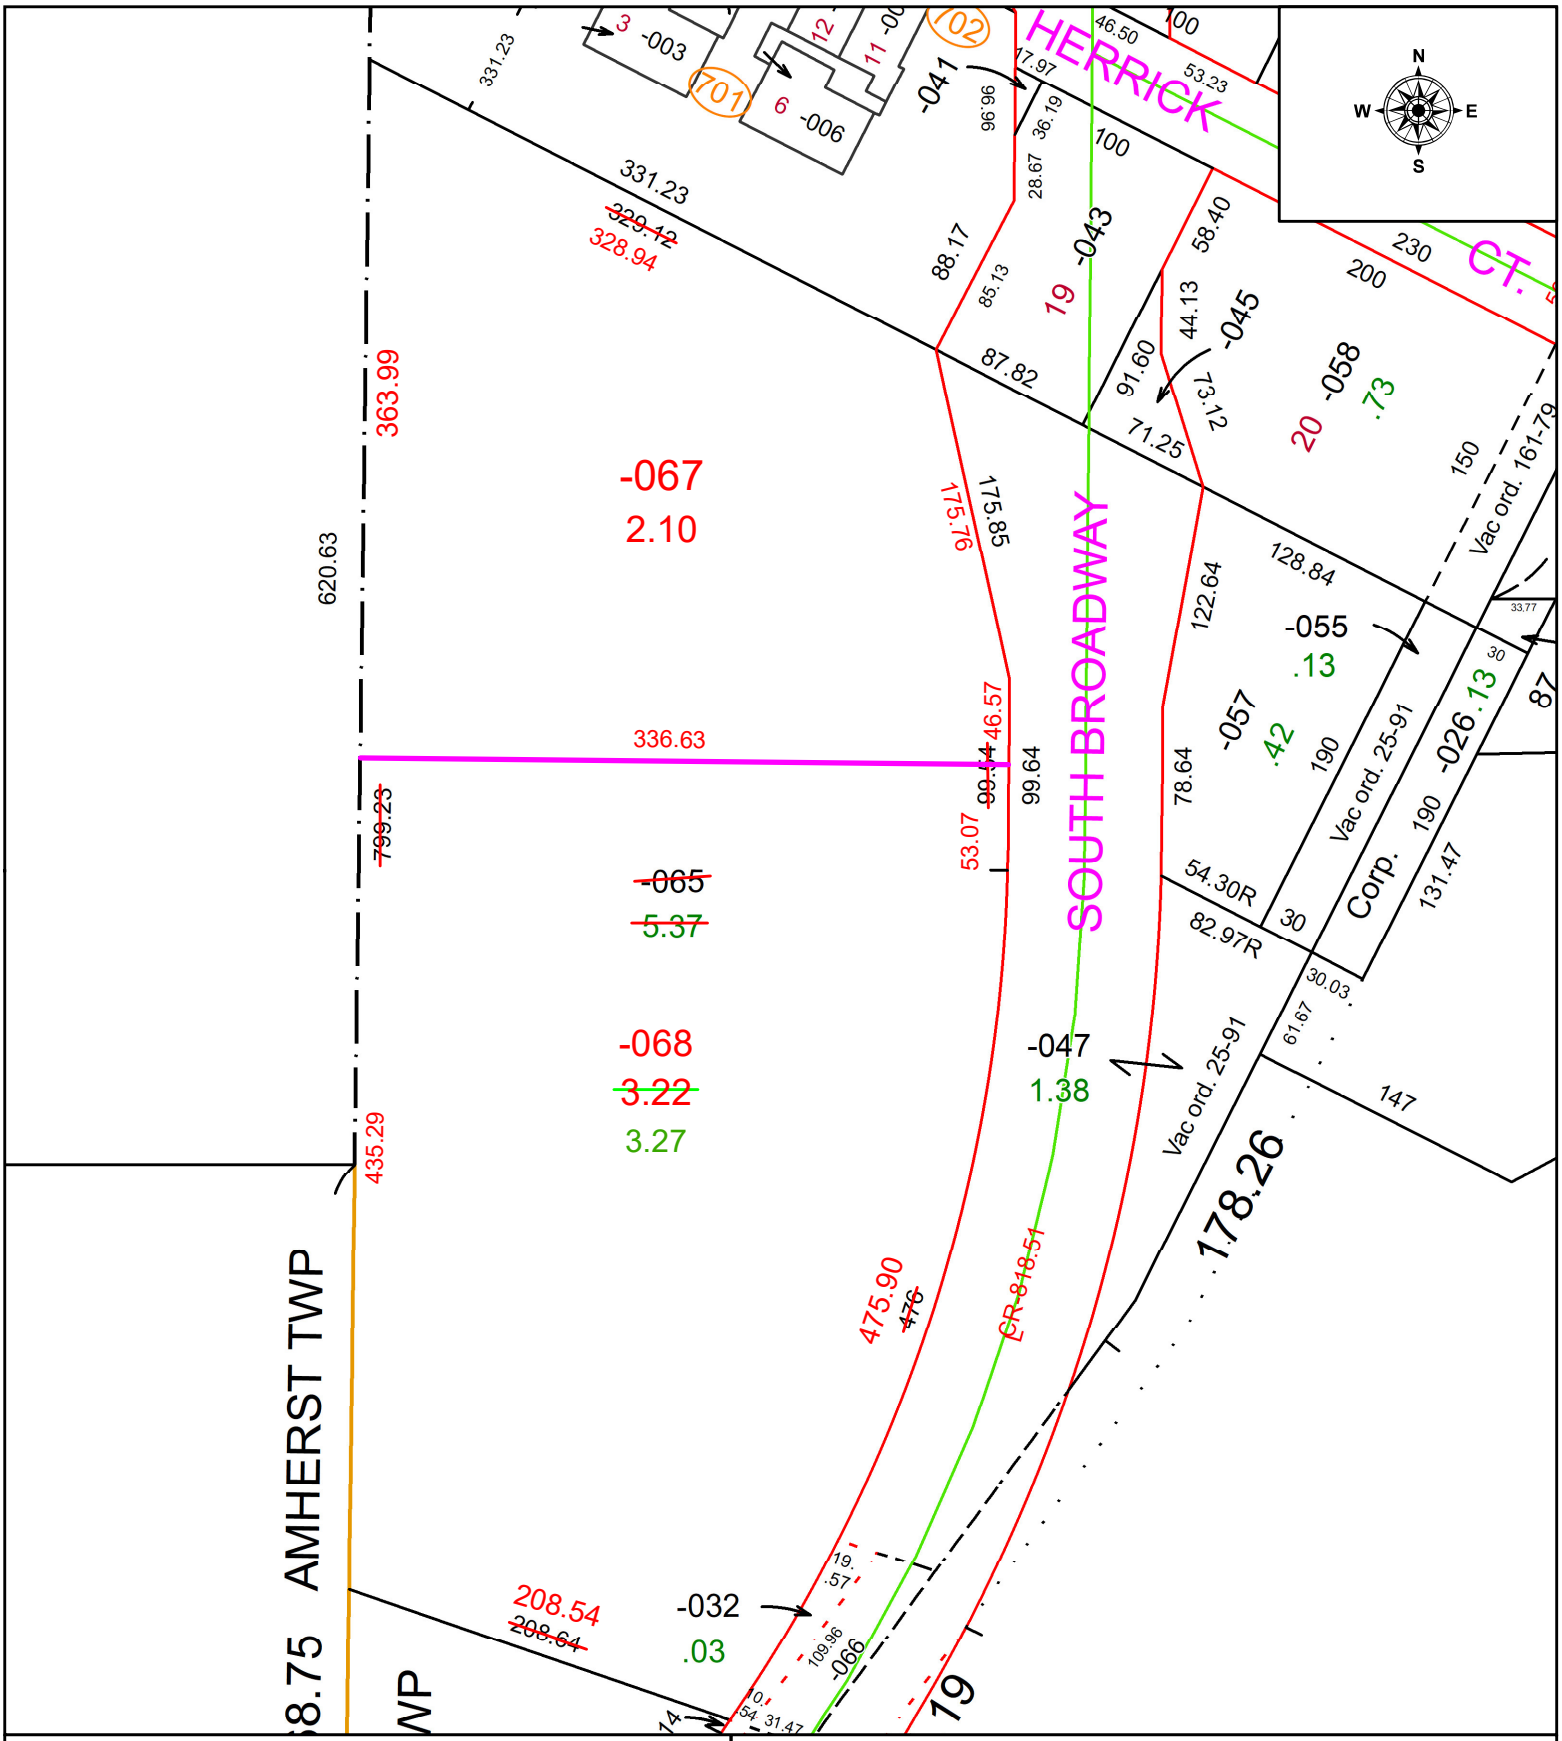

SPLITS/DEEDS PROCESSED

LORAIN COUNTY TAX MAP DEPARTMENT
226 MIDDLE AVE. ELYRIA, OH

SURVEYED BY: TREVOR BIXLER SURVEY # 50703

CLOSURE: 1: 611781

MAP PAGE(S): 06-21-001

APPOVED BY: WRZ **DATE:** 10/4/2022

SCALE: 1" = 100 **PRIOR INSTRUMENT:** #2016-0593857