**PARENT PARCEL:** 04-00-008-104-196
**CHILD PARCEL:** 04-00-008-104-202 & -203
**STARTING POINT:** CL OF AVON BELDON RD. & WEBBER RD.

# 22-04566

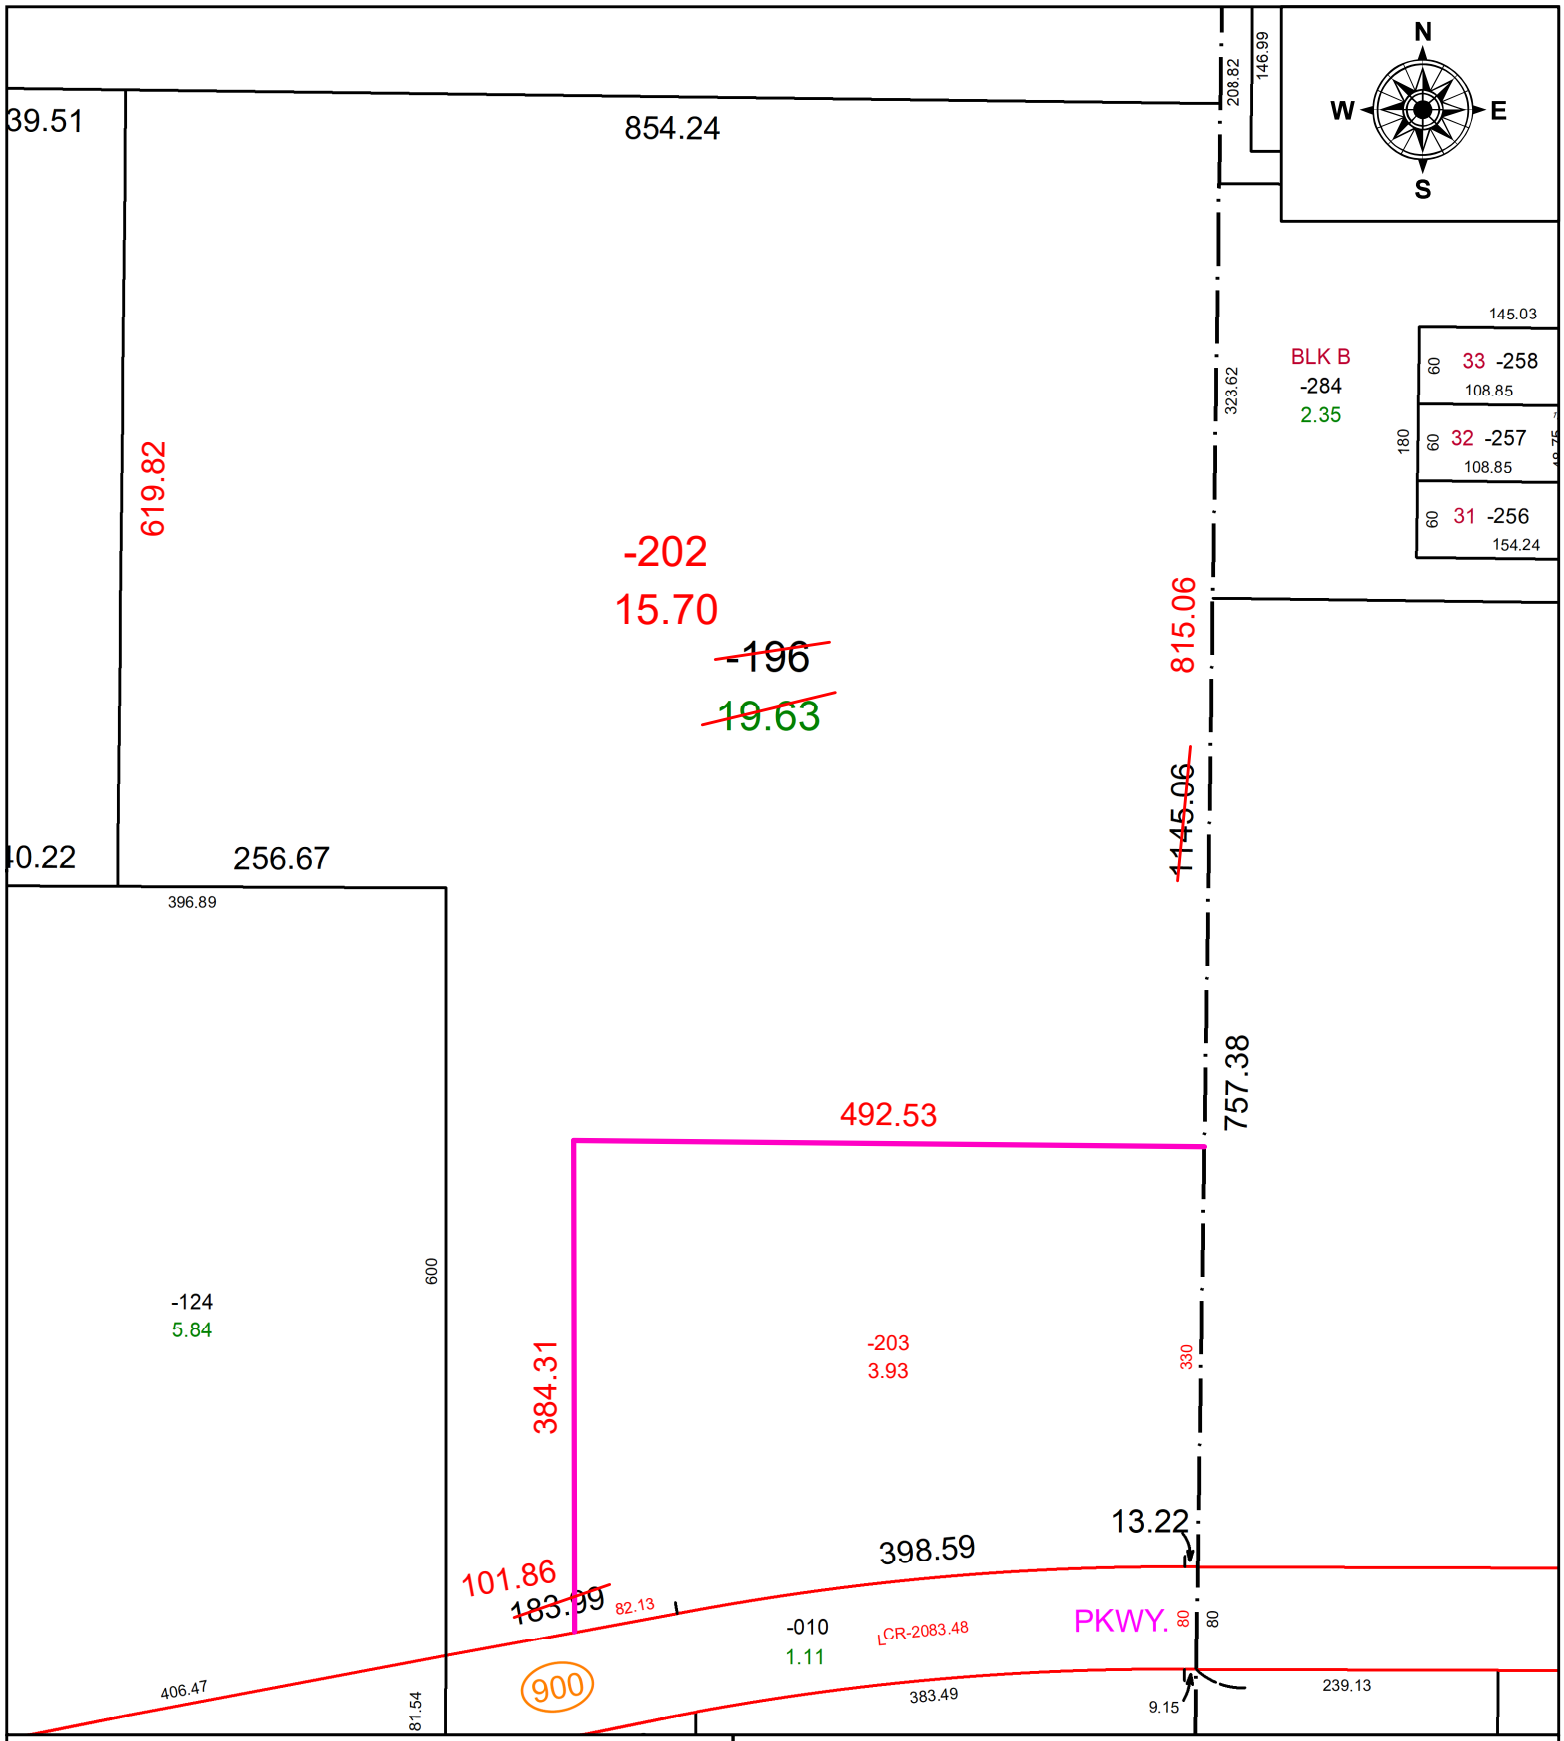


**SPLITS/DEEDS PROCESSED**

LORAIN COUNTY TAX MAP DEPARTMENT
226 MIDDLE AVE. ELYRIA, OH

**SURVEYED BY:** JAMES SAYLER **SURVEY #:** 50704
**CLOSURE:** 1:399763
**MAP PAGE(S):** 04-00-008
**APPOVED BY:** DMA **DATE:** 10/4/2022
**SCALE:** 1" = 150' **PRIOR INSTRUMENT:** 2021-0821675