PARENT PARCEL: 07-00-003-101-010, 07-00-004-109-043

CHILD PARCEL: 07-00-003-101-022, -023, & 07-00-004-109-064, -065

STARTING POINT: C/L OF LORAIN AND LEAR NAGLE RD **AC CORR PER SURV BY AMY M. KELLY**

22-04572

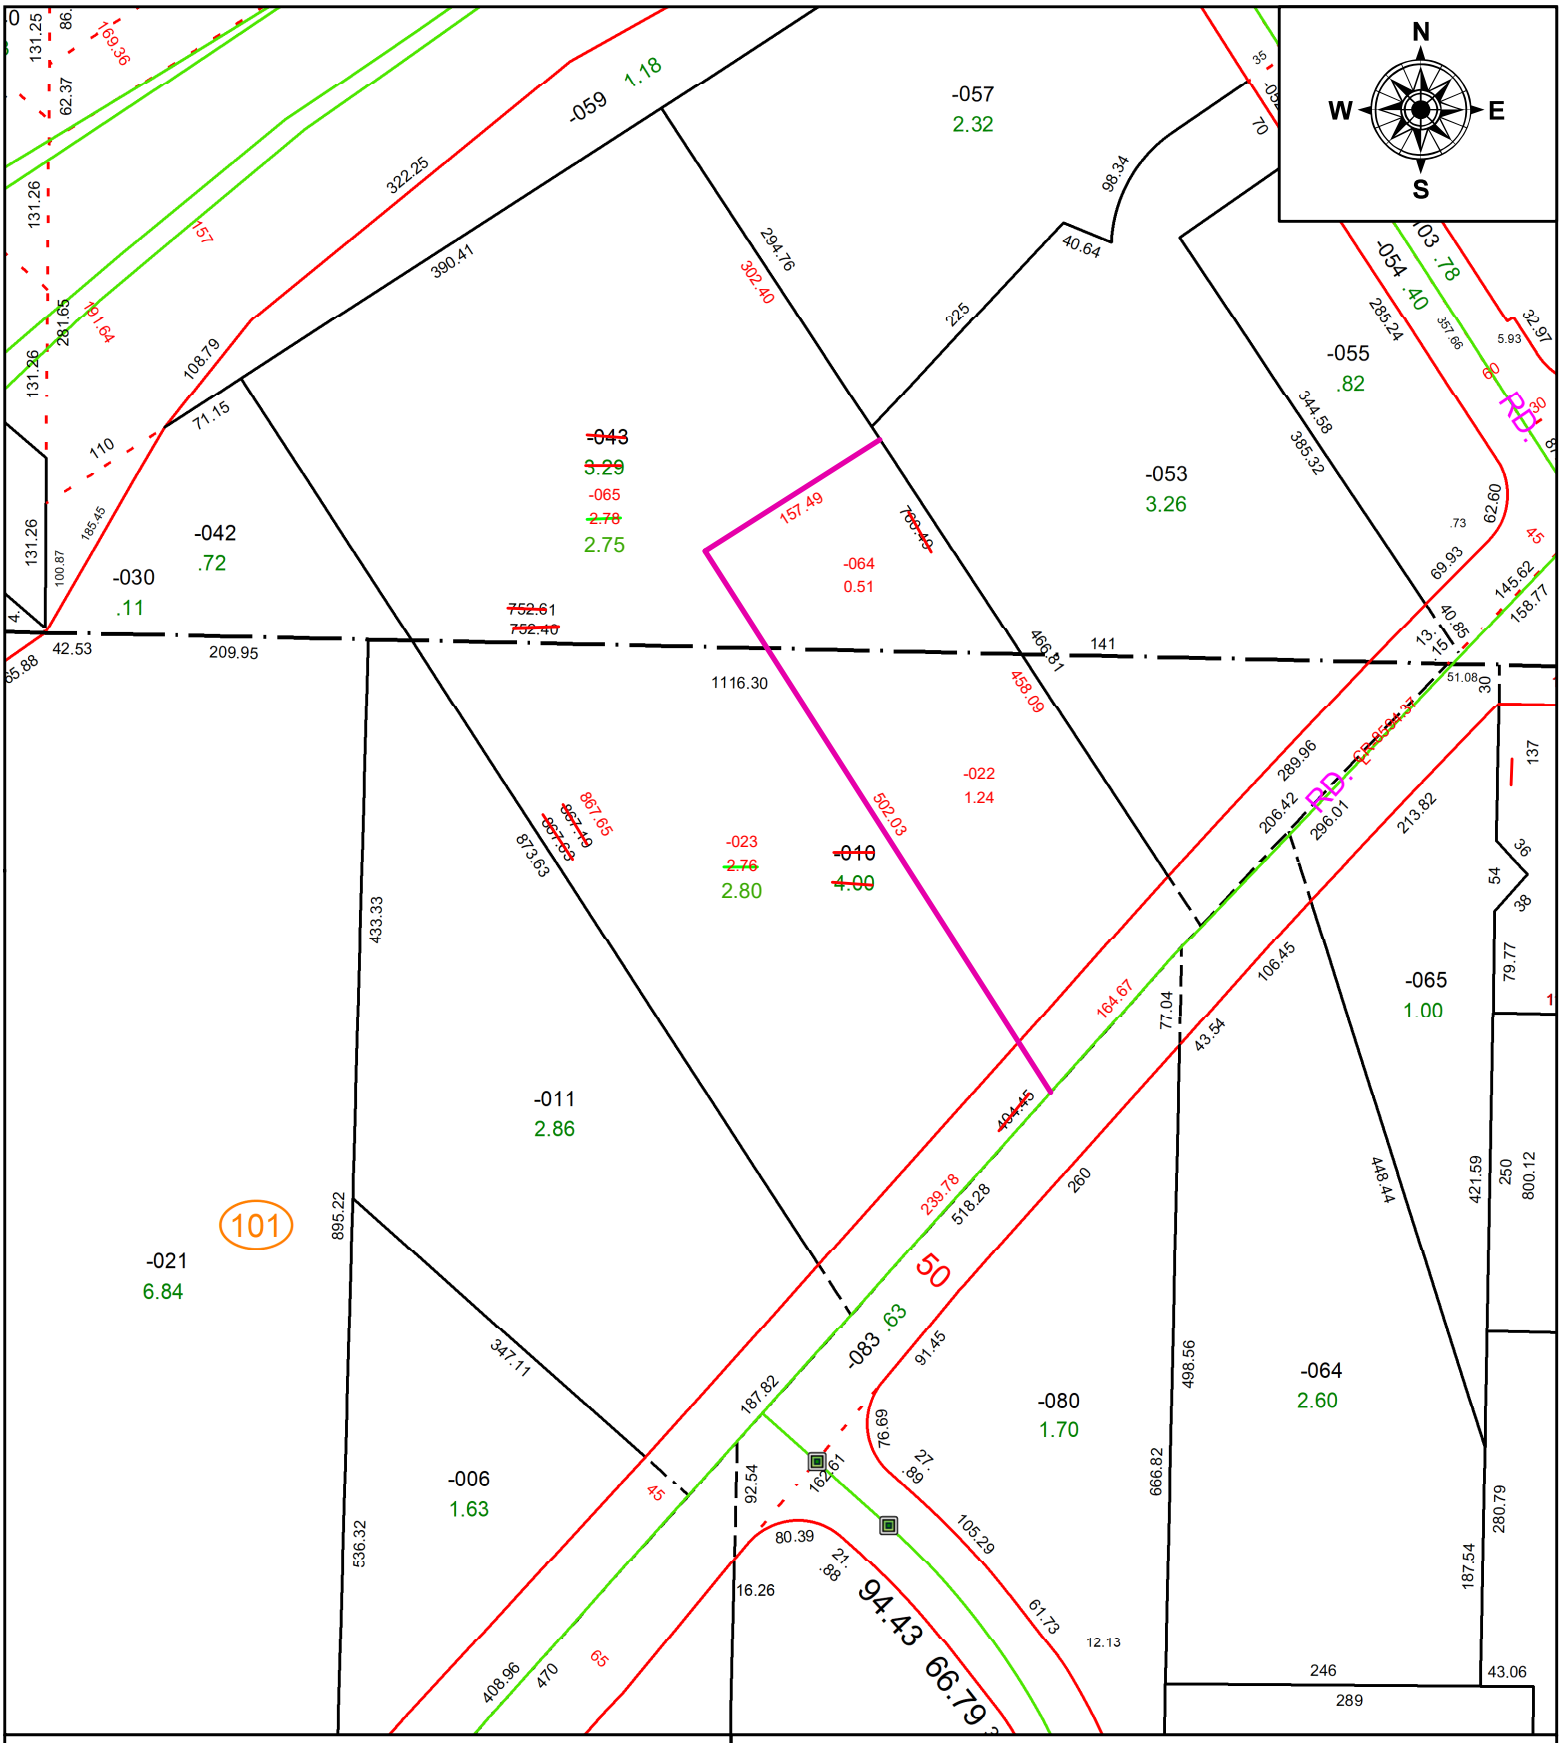

SPLITS/DEEDS PROCESSED

LORAIN COUNTY TAX MAP DEPARTMENT
226 MIDDLE AVE. ELYRIA, OH

SURVEYED BY: AMY M. KELLY **SURV # 50711**

CLOSURE: 1: 100789

MAP PAGE(S): 07-00-003, -004

APPOVED BY: AC **DATE:** October 12, 2022

SCALE: 1 in = 150 ft **PRIOR INSTRUMENT:** 1999- 0621362