PARENT PARCEL: 19-05-009-000-010
CHILD PARCEL: 19-05-009-000-017 & -018
STARTING POINT: CL OF S.R. 301 & PECK WADSWORTH RD.

22-04576

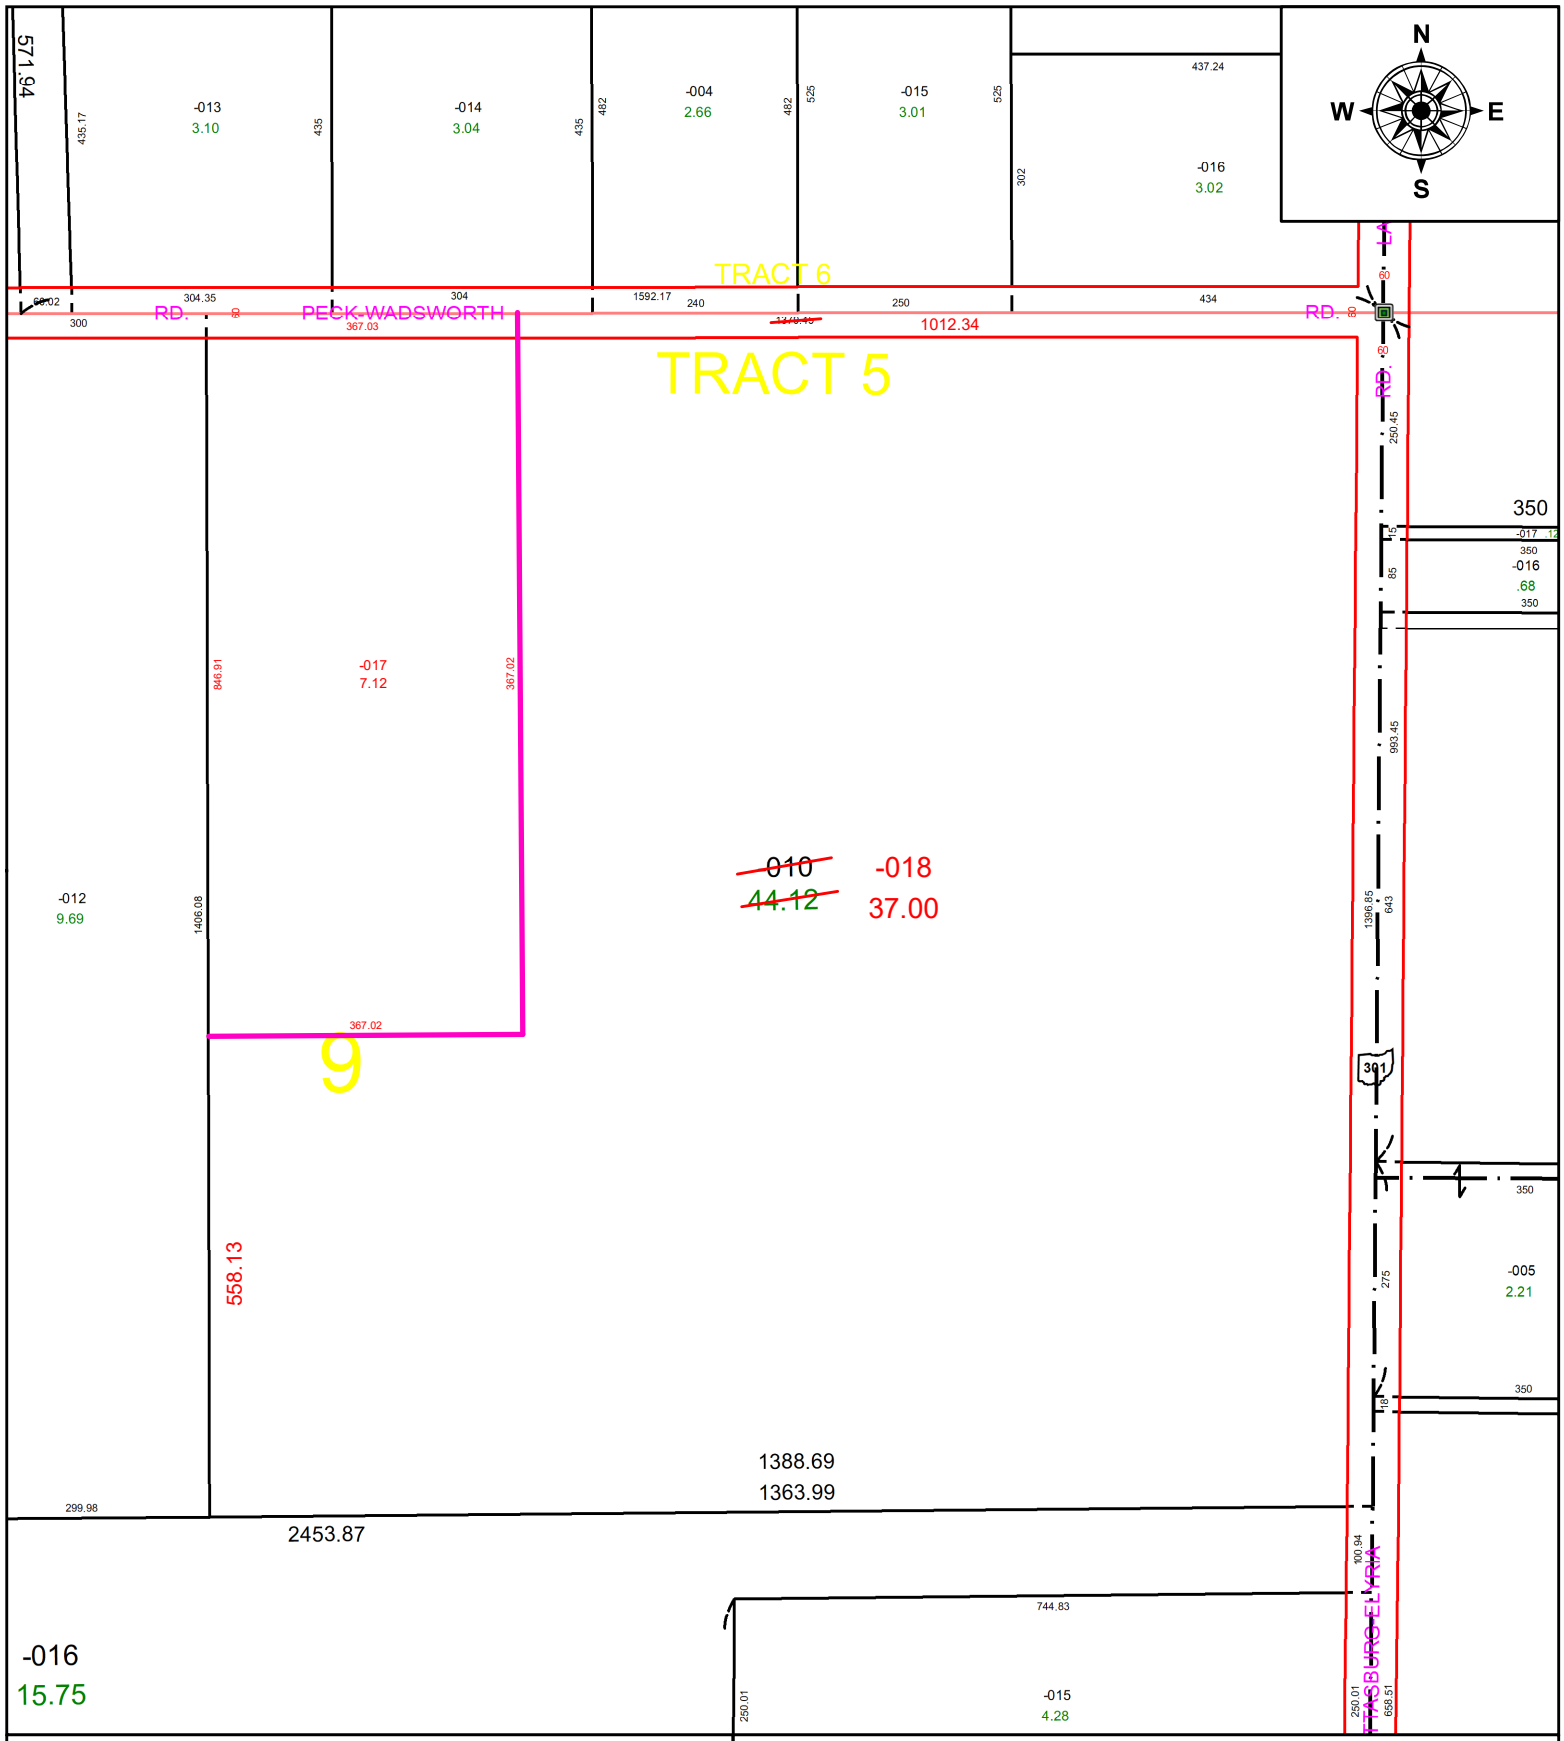

SPLITS/DEEDS PROCESSED

LORAIN COUNTY TAX MAP DEPARTMENT
226 MIDDLE AVE. ELYRIA, OH

SURVEYED BY: TIMOTHY HOZALSKI **SURVEY #:** 50654
CLOSURE: 1:649526
MAP PAGE(S): 19-05-009
APPOVED BY: DMA **DATE:** 10/20/2022
SCALE: 1" = 225' **PRIOR INSTRUMENT:** 2013-0446802