PARENT PARCEL: 19-03-002-000-014, -015, -017 & -022

CHILD PARCEL: 19-03-002-000-023

STARTING POINT: CL OF S.R. 18 & N.W CORNER OF O.L. 2

22-04578

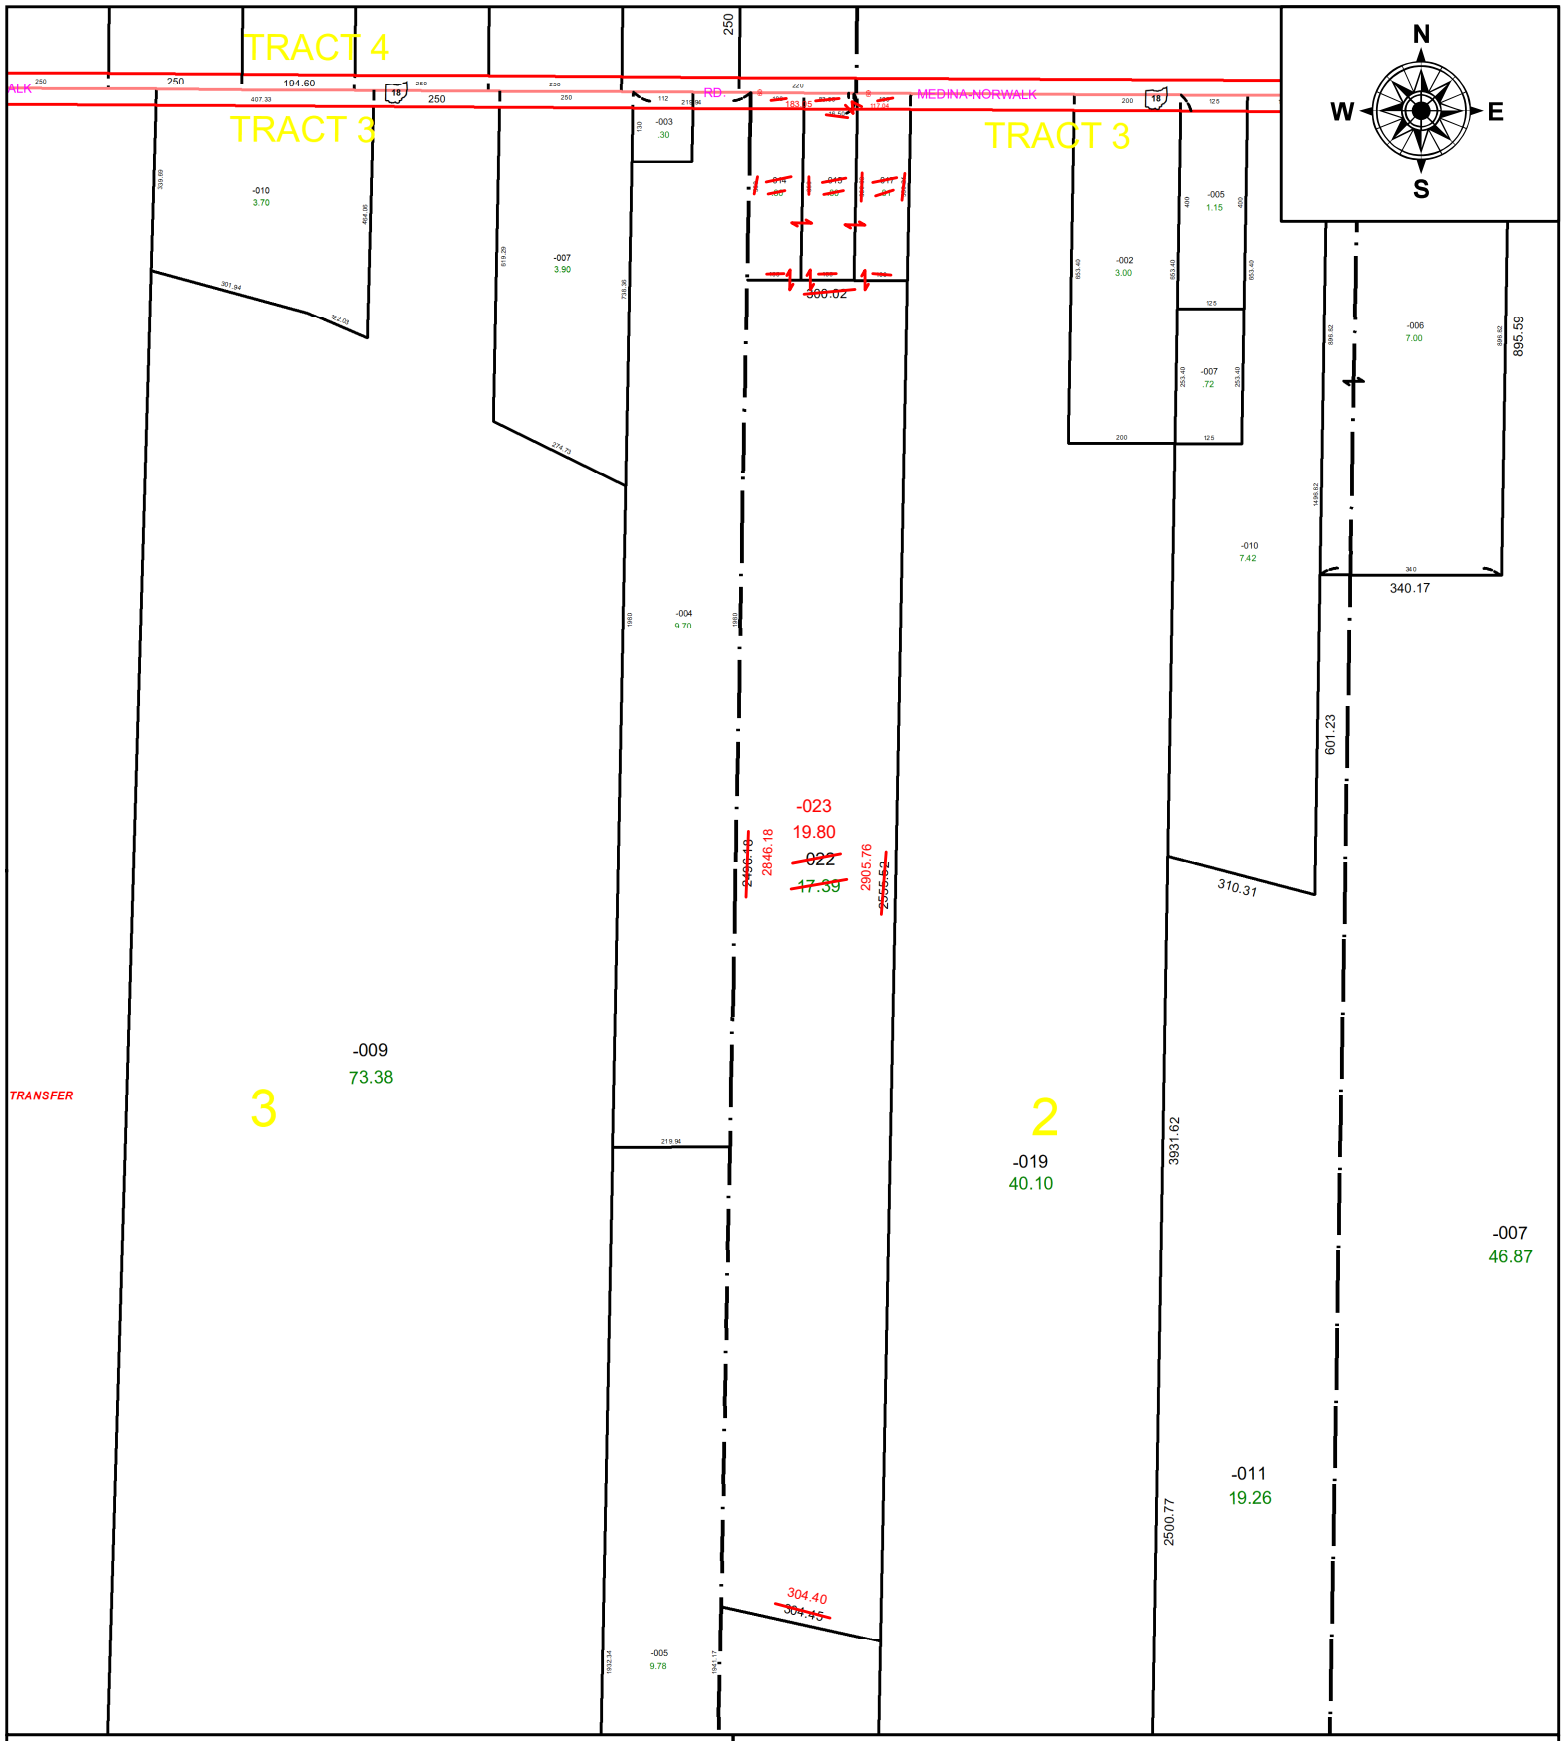

SPLITS/DEEDS PROCESSED

LORAIN COUNTY TAX MAP DEPARTMENT
226 MIDDLE AVE. ELYRIA, OH

SURVEYED BY: DANIEL ENGLE **SURVEY #:** 50722

CLOSURE: 1:1125779

MAP PAGE(S): 19-03-002

APPOVED BY: DMA **DATE:** 10/24/2022

SCALE: 1" = 360' **PRIOR INSTRUMENT:** 2022-0890914