PARENT PARCEL: 07-00-029-000-057

CHILD PARCEL:

STARTING POINT: MONUMENT BOX AT INTERSECTION OF C/L SR 83 & SOUTHEASERLY CORNER OF OL 29

21-04582-C

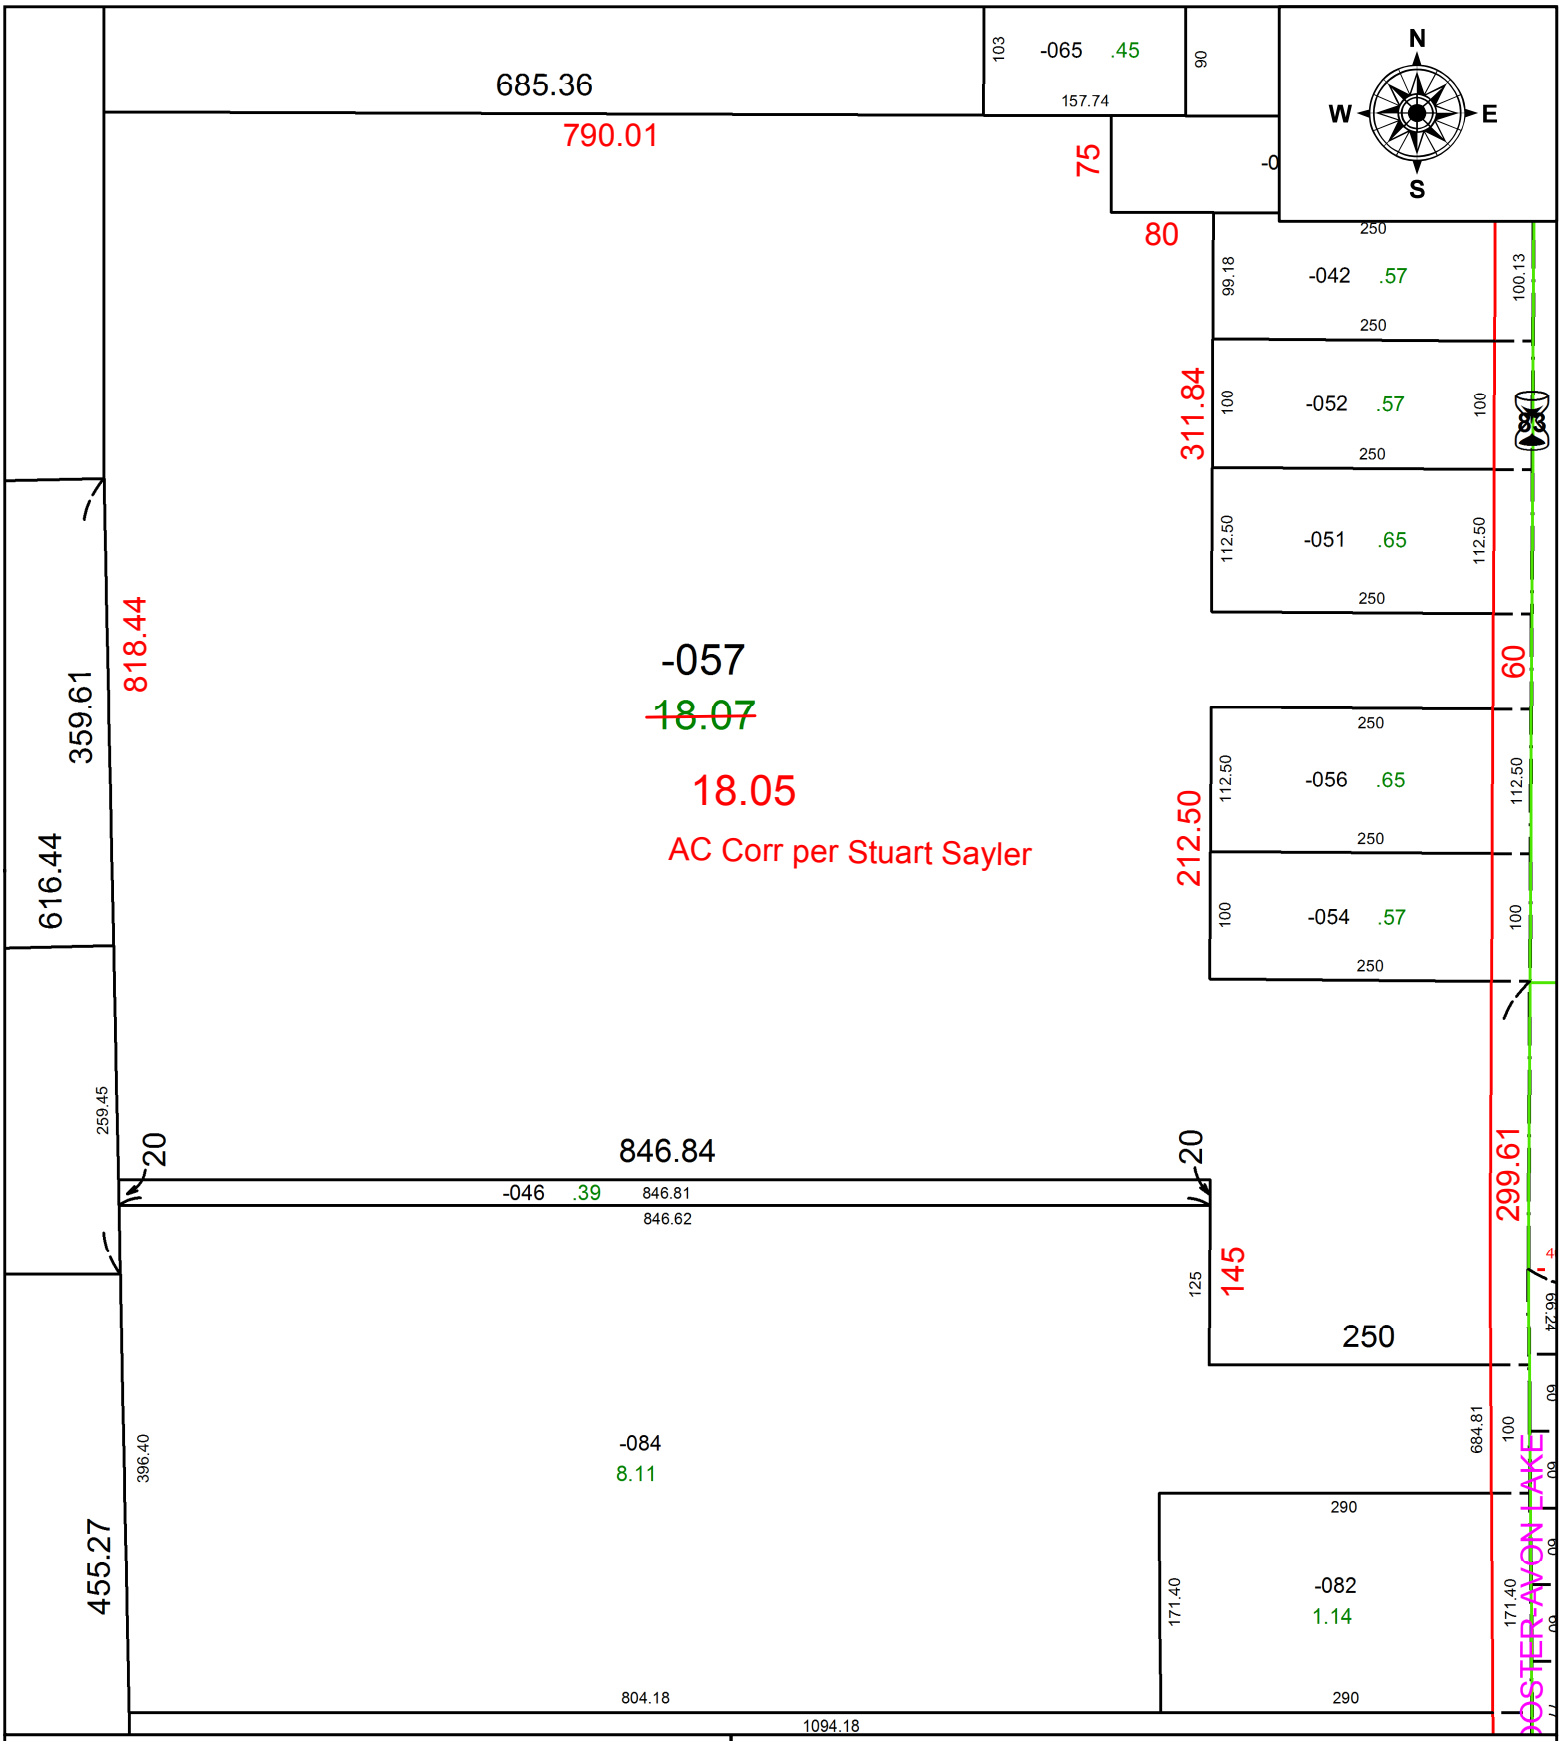

SPLITS/DEEDS PROCESSED

LORAIN COUNTY TAX MAP DEPARTMENT
226 MIDDLE AVE. ELYRIA, OH

SURVEYED BY: STUART SAYLER
CLOSURE: 1: 1,505,771
MAP PAGE(S): 07-00-029
APPOVED BY: WRZ **DATE:** 6-10-2021
SCALE: 1" = 150 **PRIOR INSTRUMENT:** OR DV 951/724