PARENT PARCEL: 05-00-061-104-033 & -034

CHILD PARCEL: 05-00-061-104-040 THRU -043 & 05-00-062-102-026 STR. TRNS.

STARTING POINT: CL OF NORTH RIDGE RD. & OBERLIN RD.

22-04583

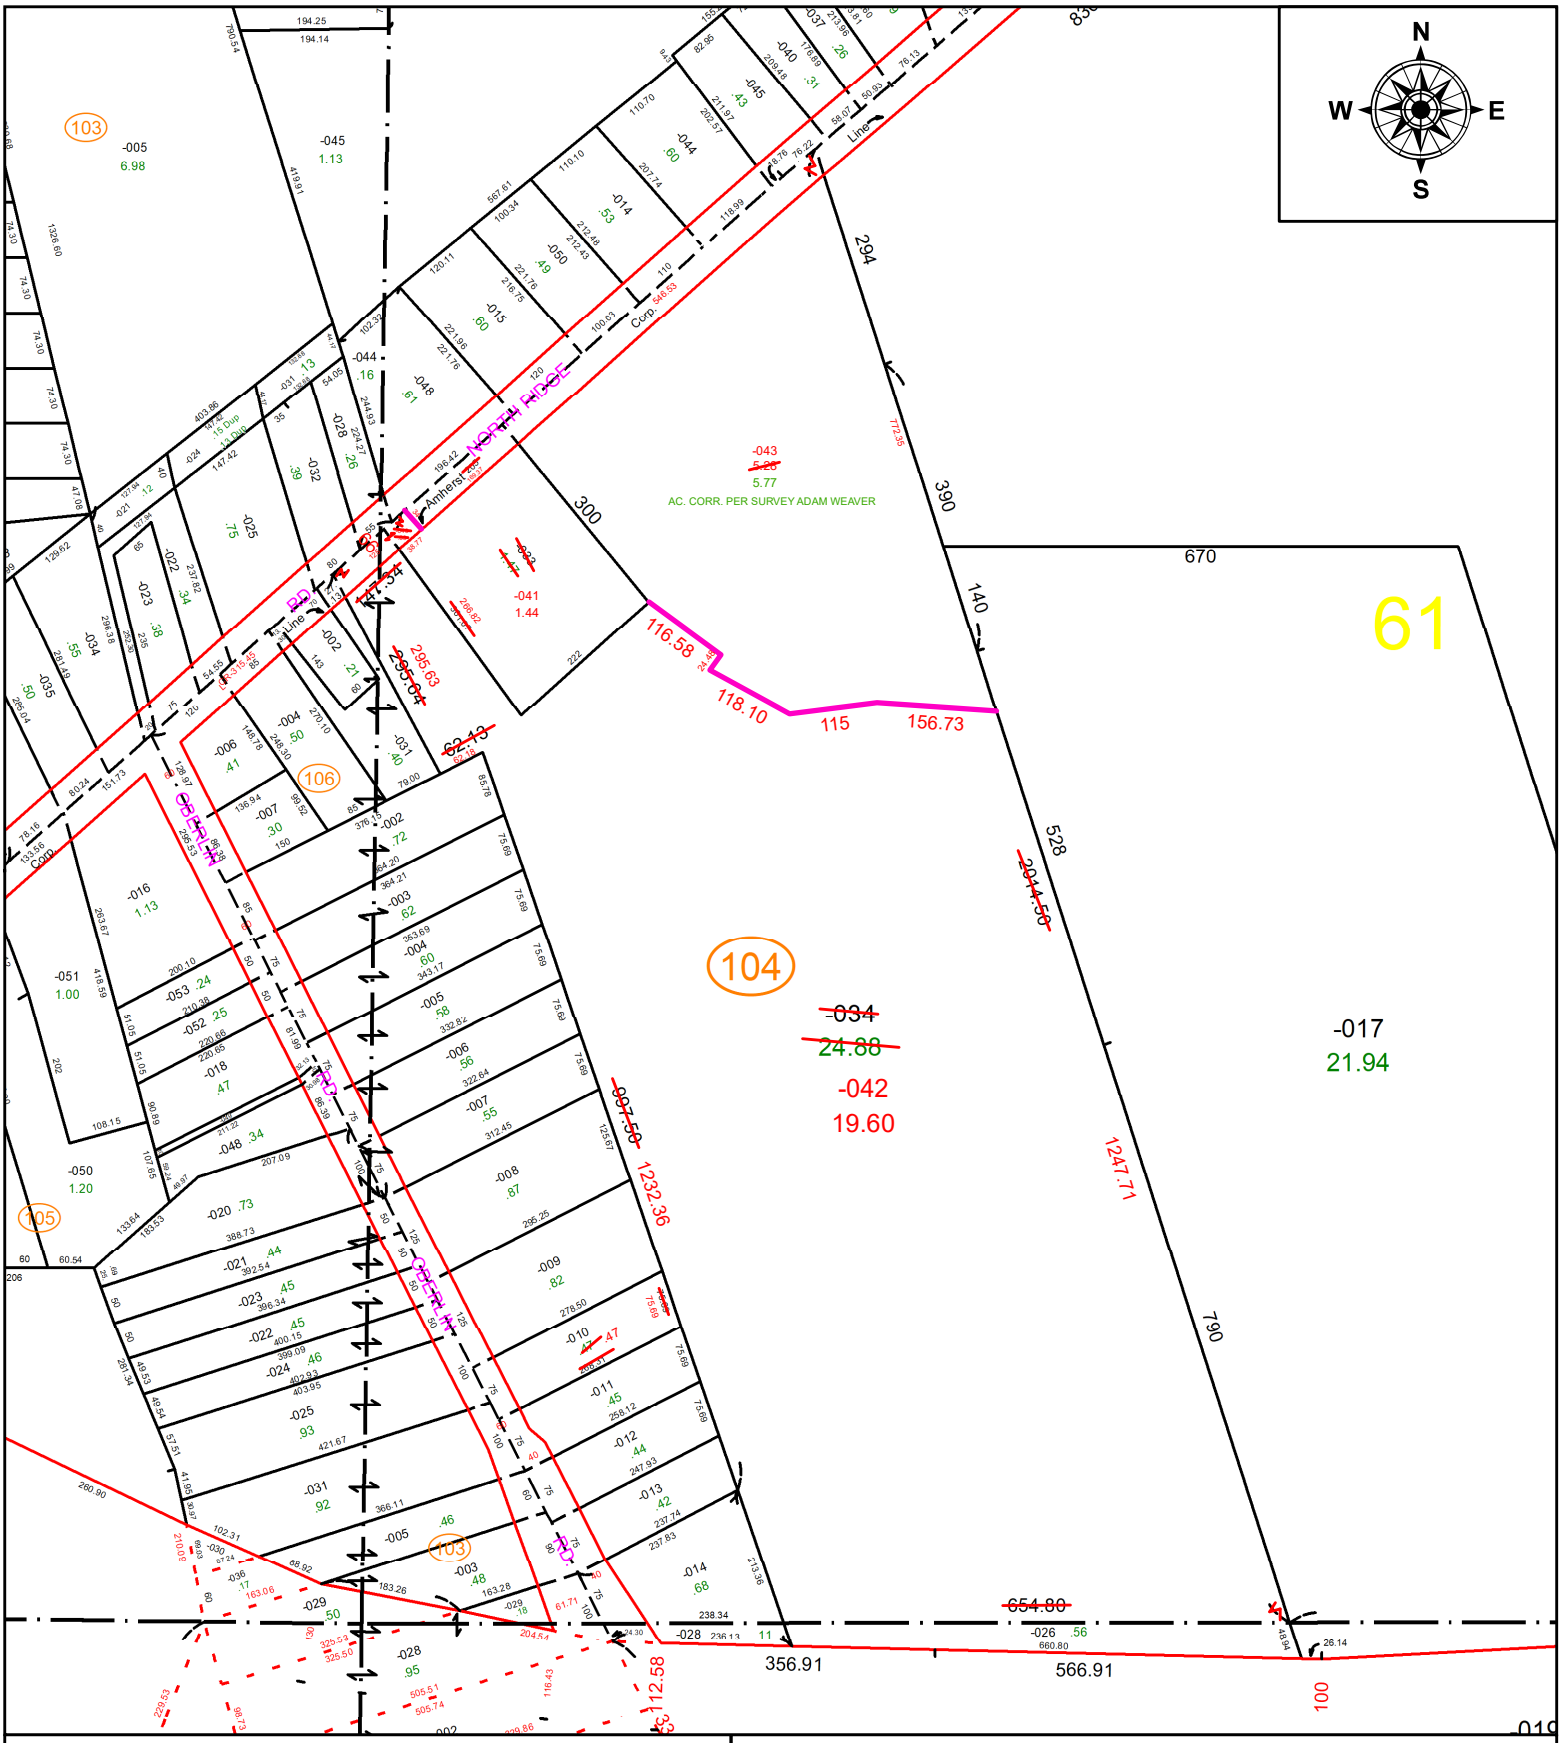

SPLITS/DEEDS PROCESSED

LORAIN COUNTY TAX MAP DEPARTMENT
226 MIDDLE AVE. ELYRIA, OH

SURVEYED BY: ADAM WEAVER **SURVEY #:** 50742

CLOSURE: 1:22292

MAP PAGE(S): 05-00-061

APPOVED BY: DMA **DATE:** 11/21/2022

SCALE: 1" = 250' **PRIOR INSTRUMENT:** 1999-0594894