PARENT PARCEL: 02-01-003-263-016 & -017

CHILD PARCEL: Ac. Corr. per survey William Wallace 1.00 Ac. to 0.97 Ac.

STARTING POINT: CL OF BROADWAY RD & NORTH RIDGE RD.

21-04584-A

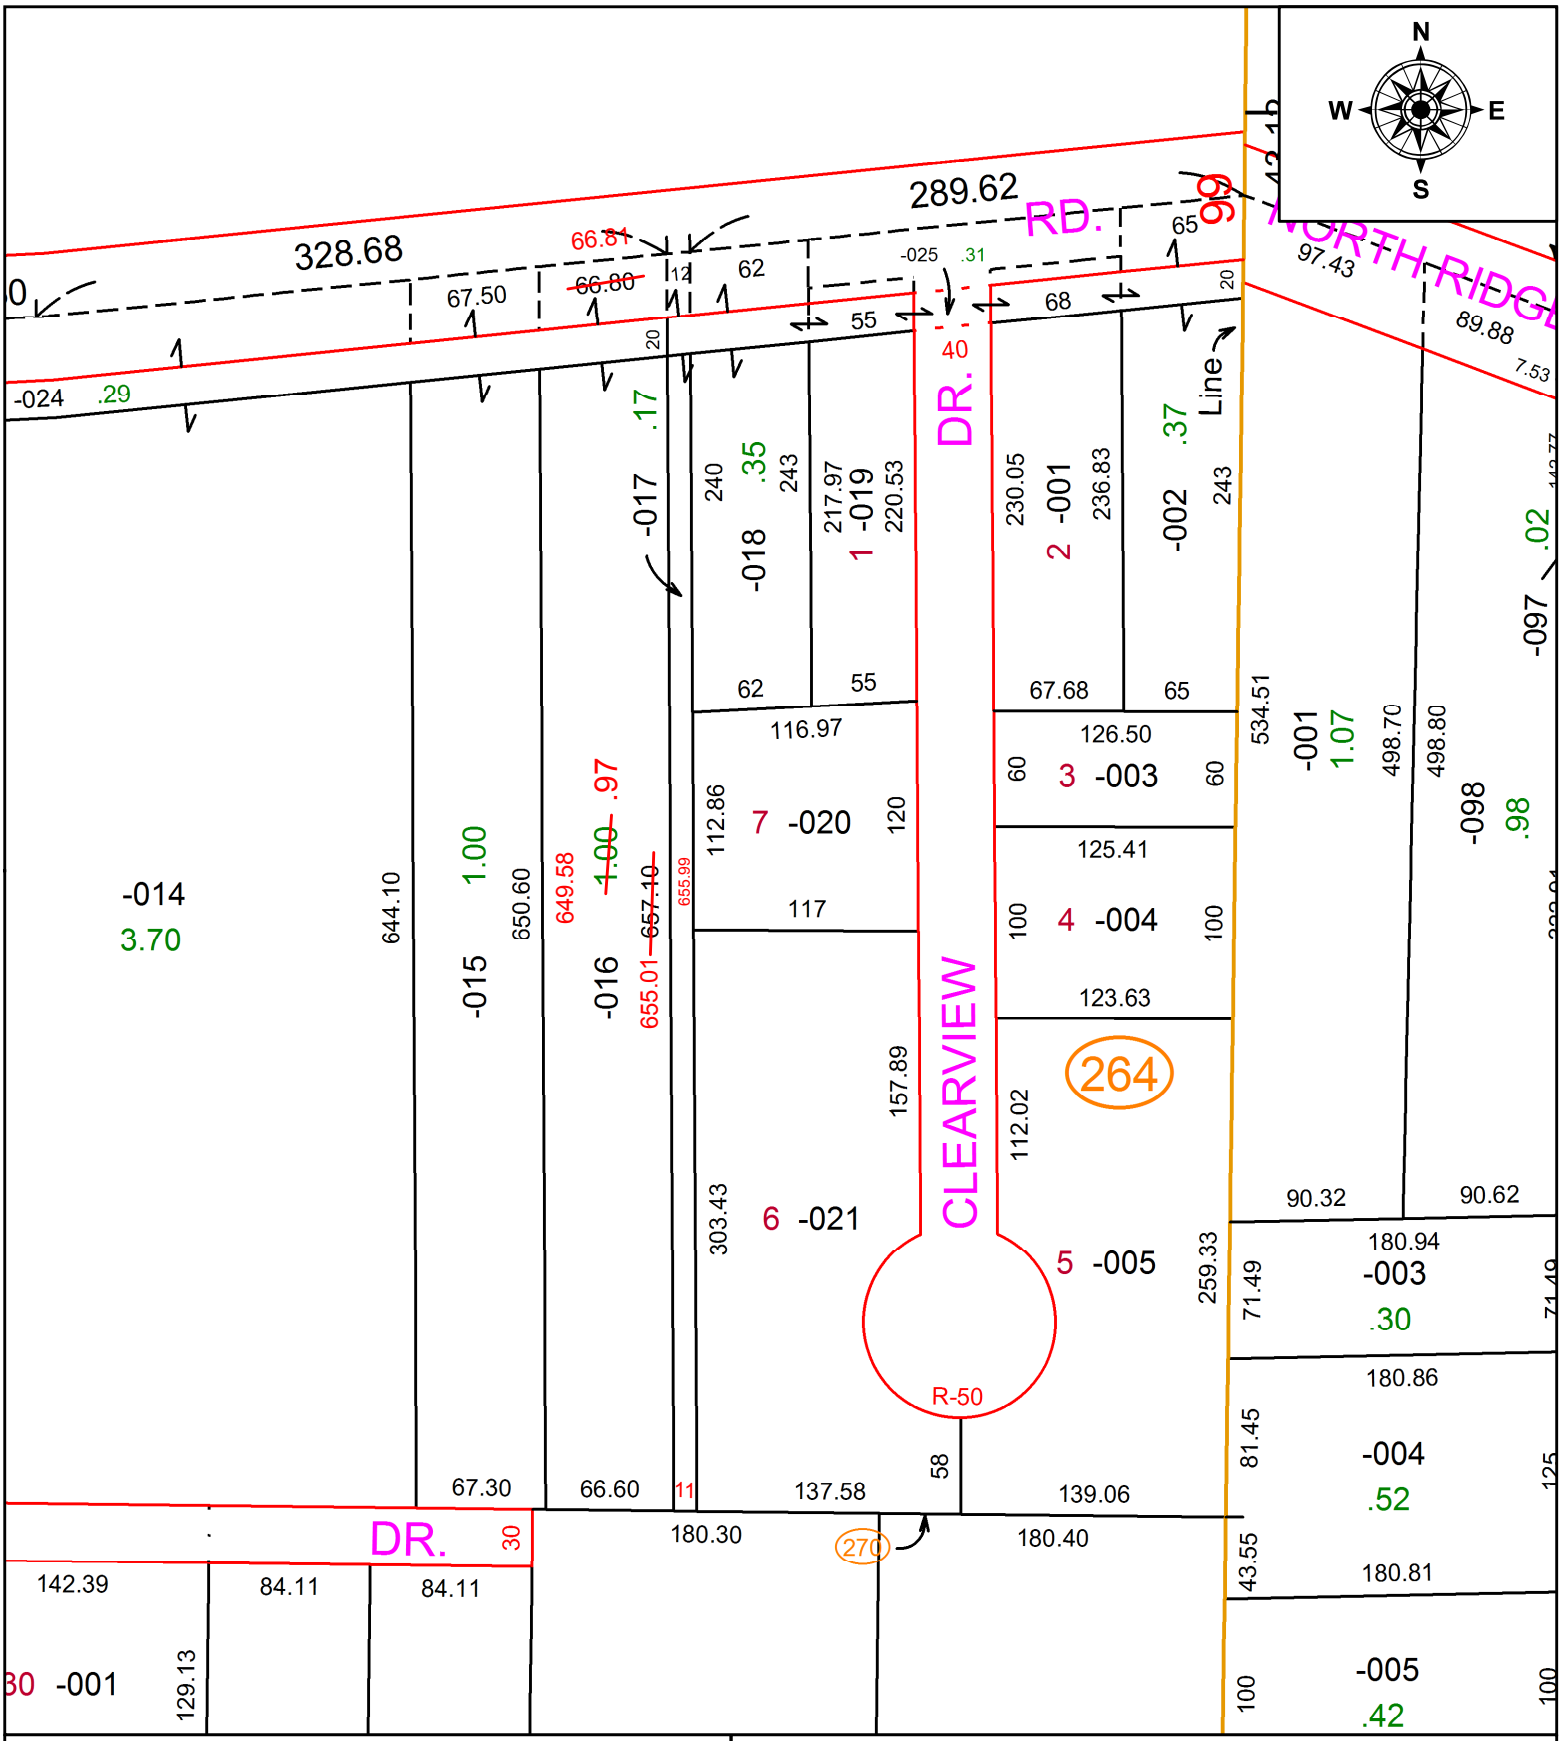

SPLITS/DEEDS PROCESSED

LORAIN COUNTY TAX MAP DEPARTMENT
226 MIDDLE AVE. ELYRIA, OH

SURVEYED BY: WILLIAM WALLACE
CLOSURE: 1: 470371
MAP PAGE(S): 02-01-003
APPOVED BY: DMA **DATE:** 6/18/2021
SCALE: 1" = 100 **PRIOR INSTRUMENT:** 20180666169