PARENT PARCEL: 08-00-103-000-033

CHILD PARCEL: 08-00-103-000-050 THRU -054 ACRAGE CORRECTION PER SURVEYOR JOHN DECHANT JR.

STARTING POINT: MONUMENT BOX @ INTERSECTION OF C/LS OF BAUMHART RD & RUSSIA RD

22-04587

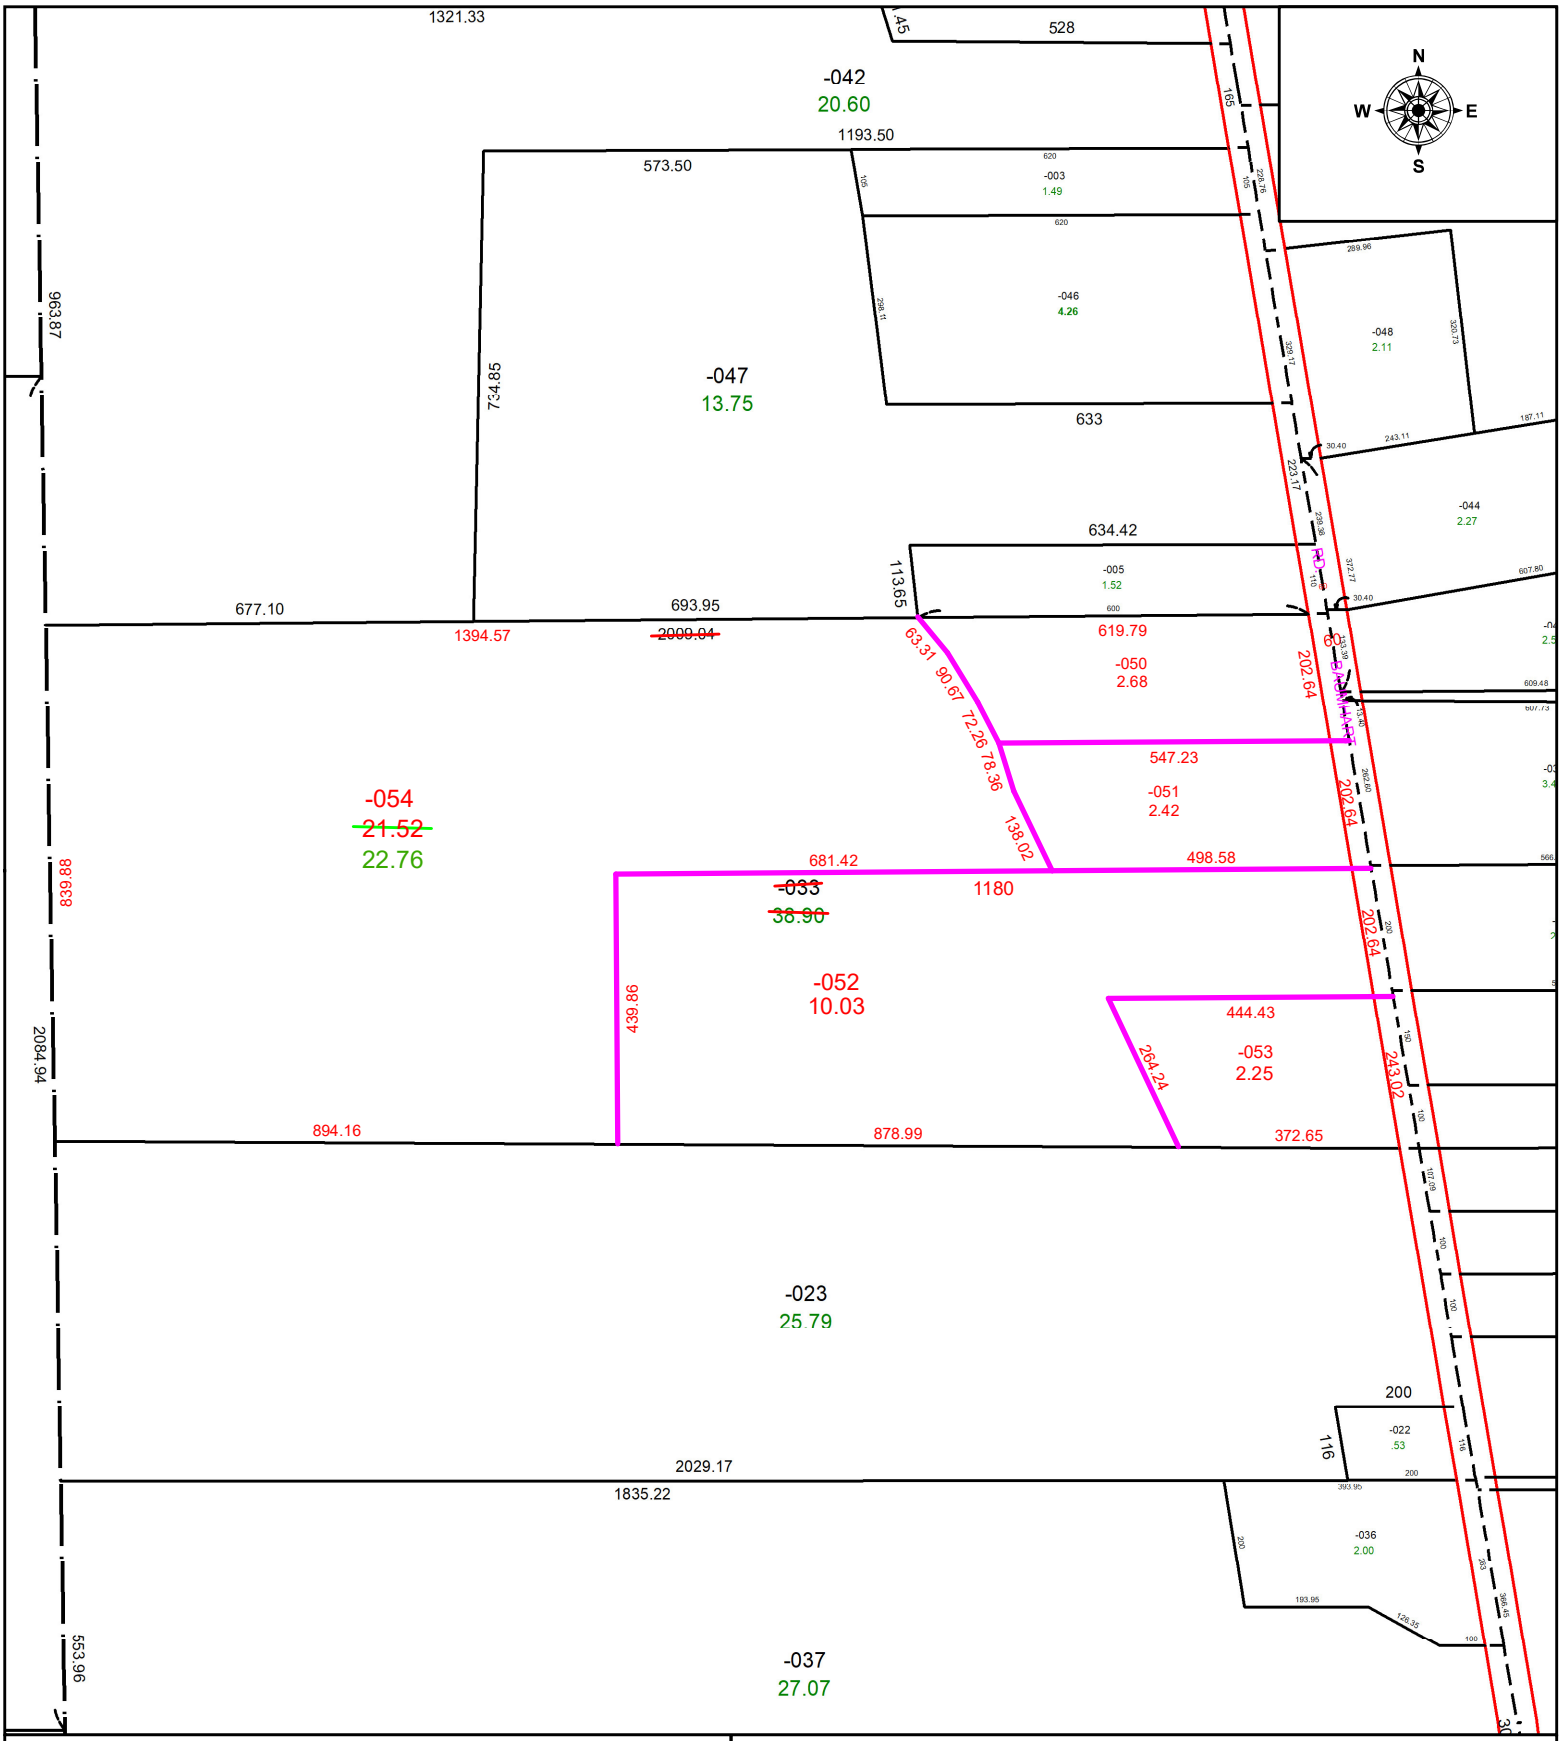

SPLITS/DEEDS PROCESSED

LORAIN COUNTY TAX MAP DEPARTMENT
226 MIDDLE AVE. ELYRIA, OH

SURVEYED BY: JOHN DECHANT JR. SURVEY # 50747

CLOSURE: 1: 645306

MAP PAGE(S): 08-00-103

APPOVED BY: WRZ **DATE:** 12/5/2022

SCALE: 1" = 300 **PRIOR INSTRUMENT:** #2022-0881301